
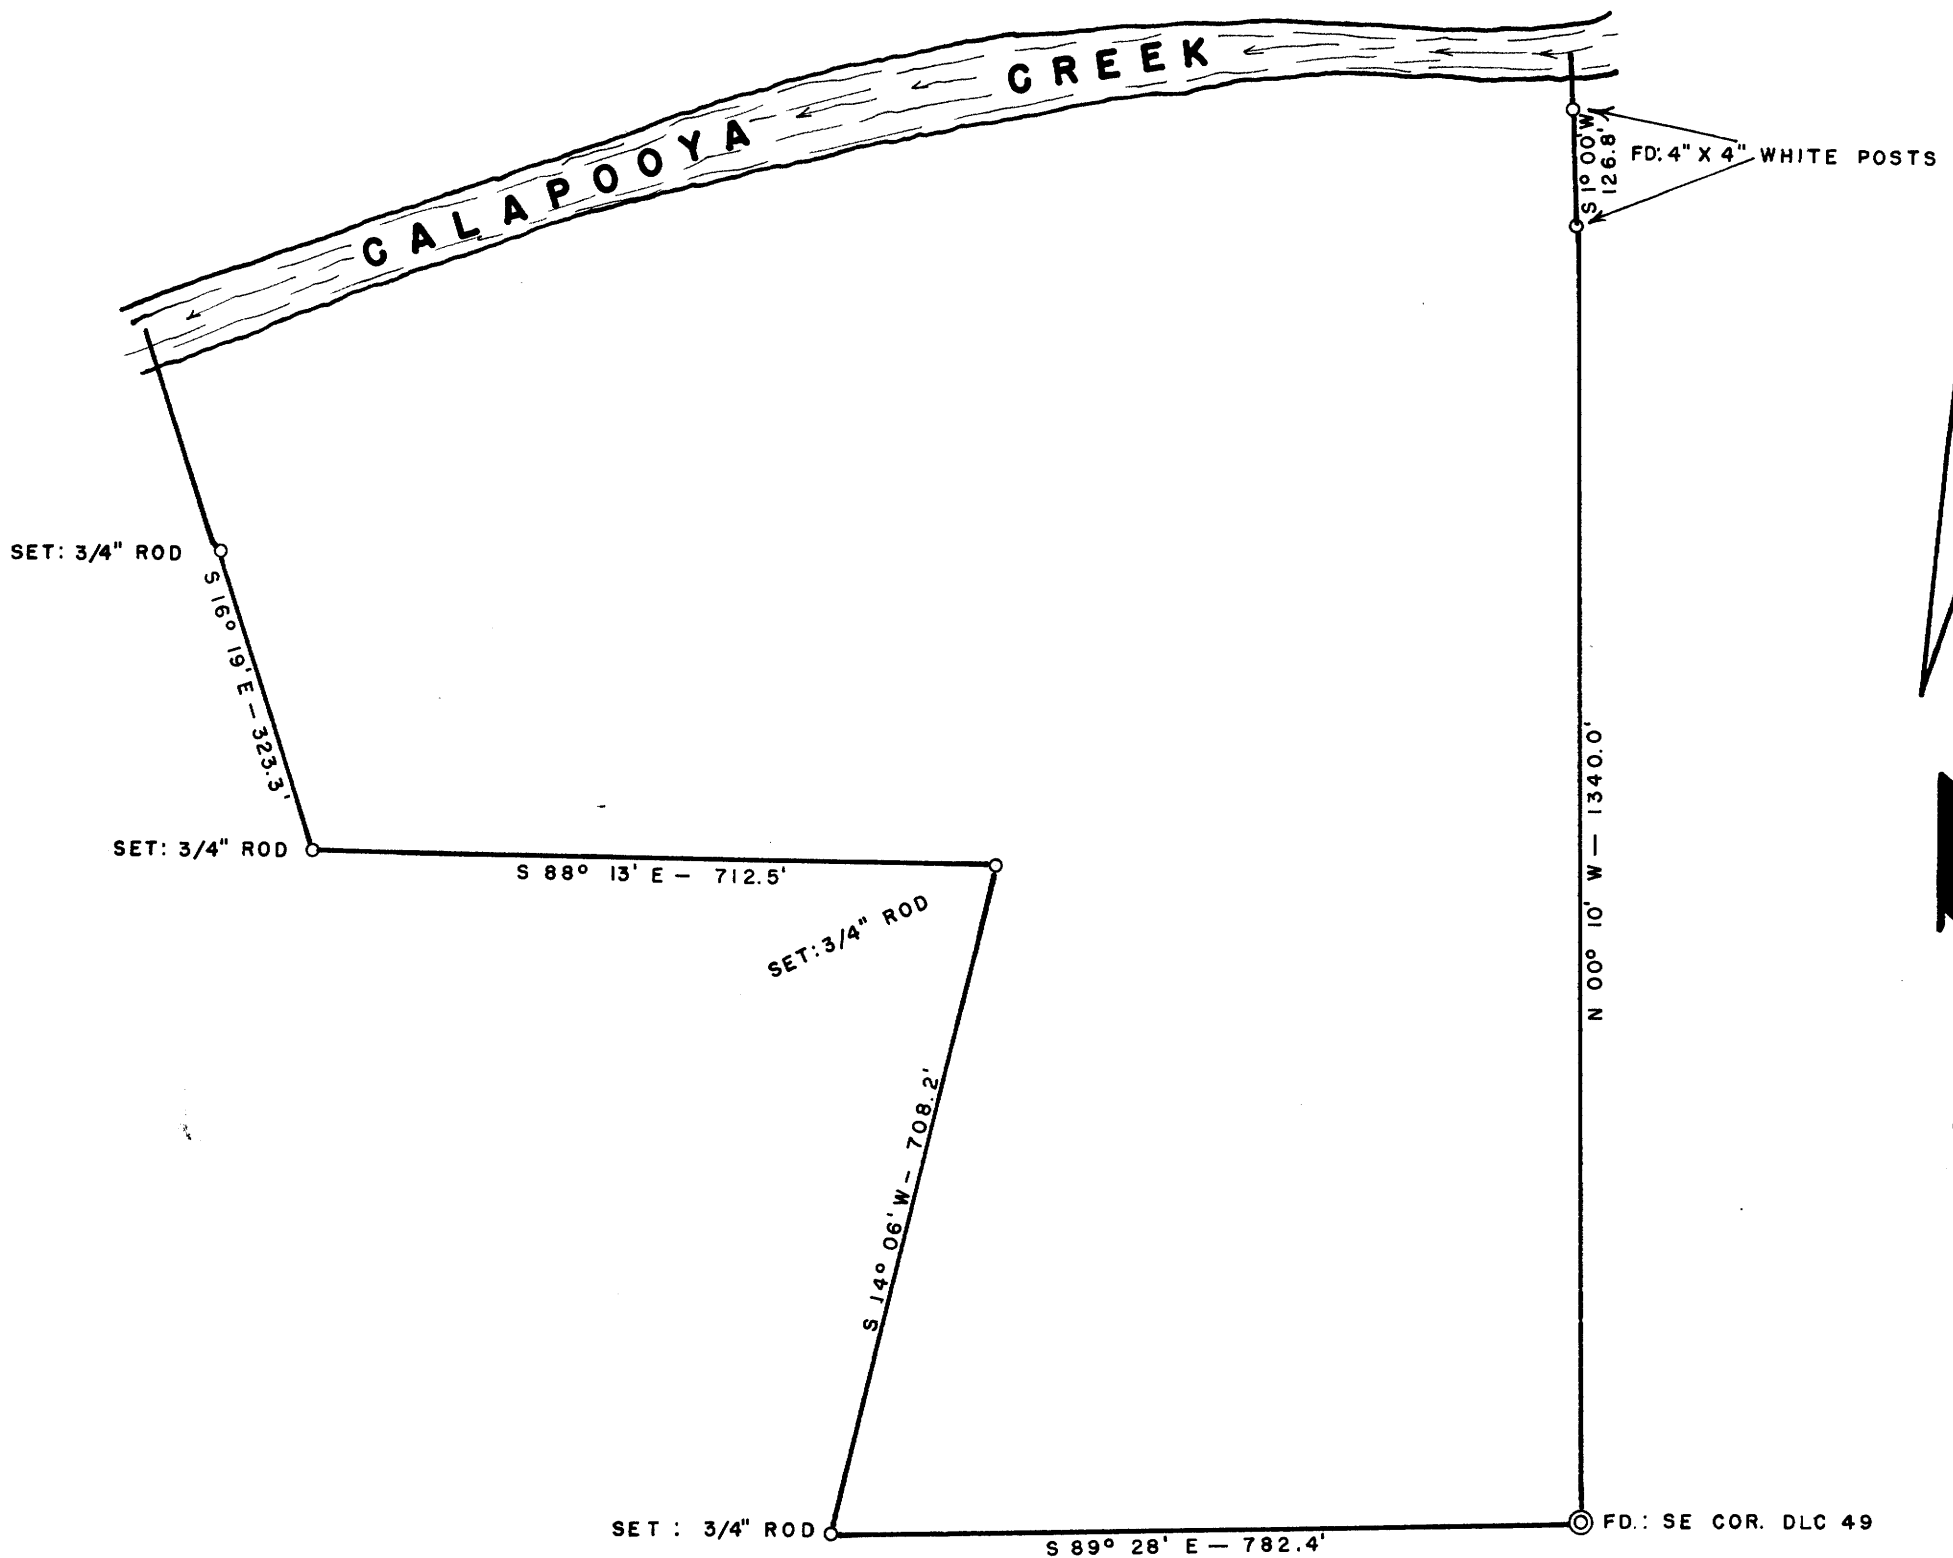


04-6W

COUNTY SURVEYOR
DO NOT REMOVE FROM FILE

SURVEY FOR DEED DESCRIPTION SECTIONS 9 & 10, T 25 S, R 4 W SURVEYED FOR: ROBERT THOMAS SURVEYED BY: G.R. LECKLIDER-ENGR. FEBRUARY, 1958 SCALE: 1" = 200'

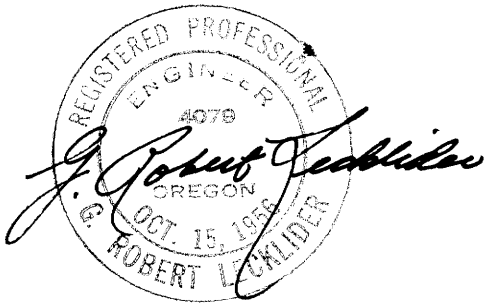

FILED
RECEIVED

MAR 3 1958

COUNTY SURVEYOR
DOUGLAS COUNTY, ORE

Handwritten initials

MAP FILE M 9-40