


COUNTY SURVEYOR
DO NOT REMOVE FROM OFF.

C.S. FILE No. 37164
MAP FILE M9-49

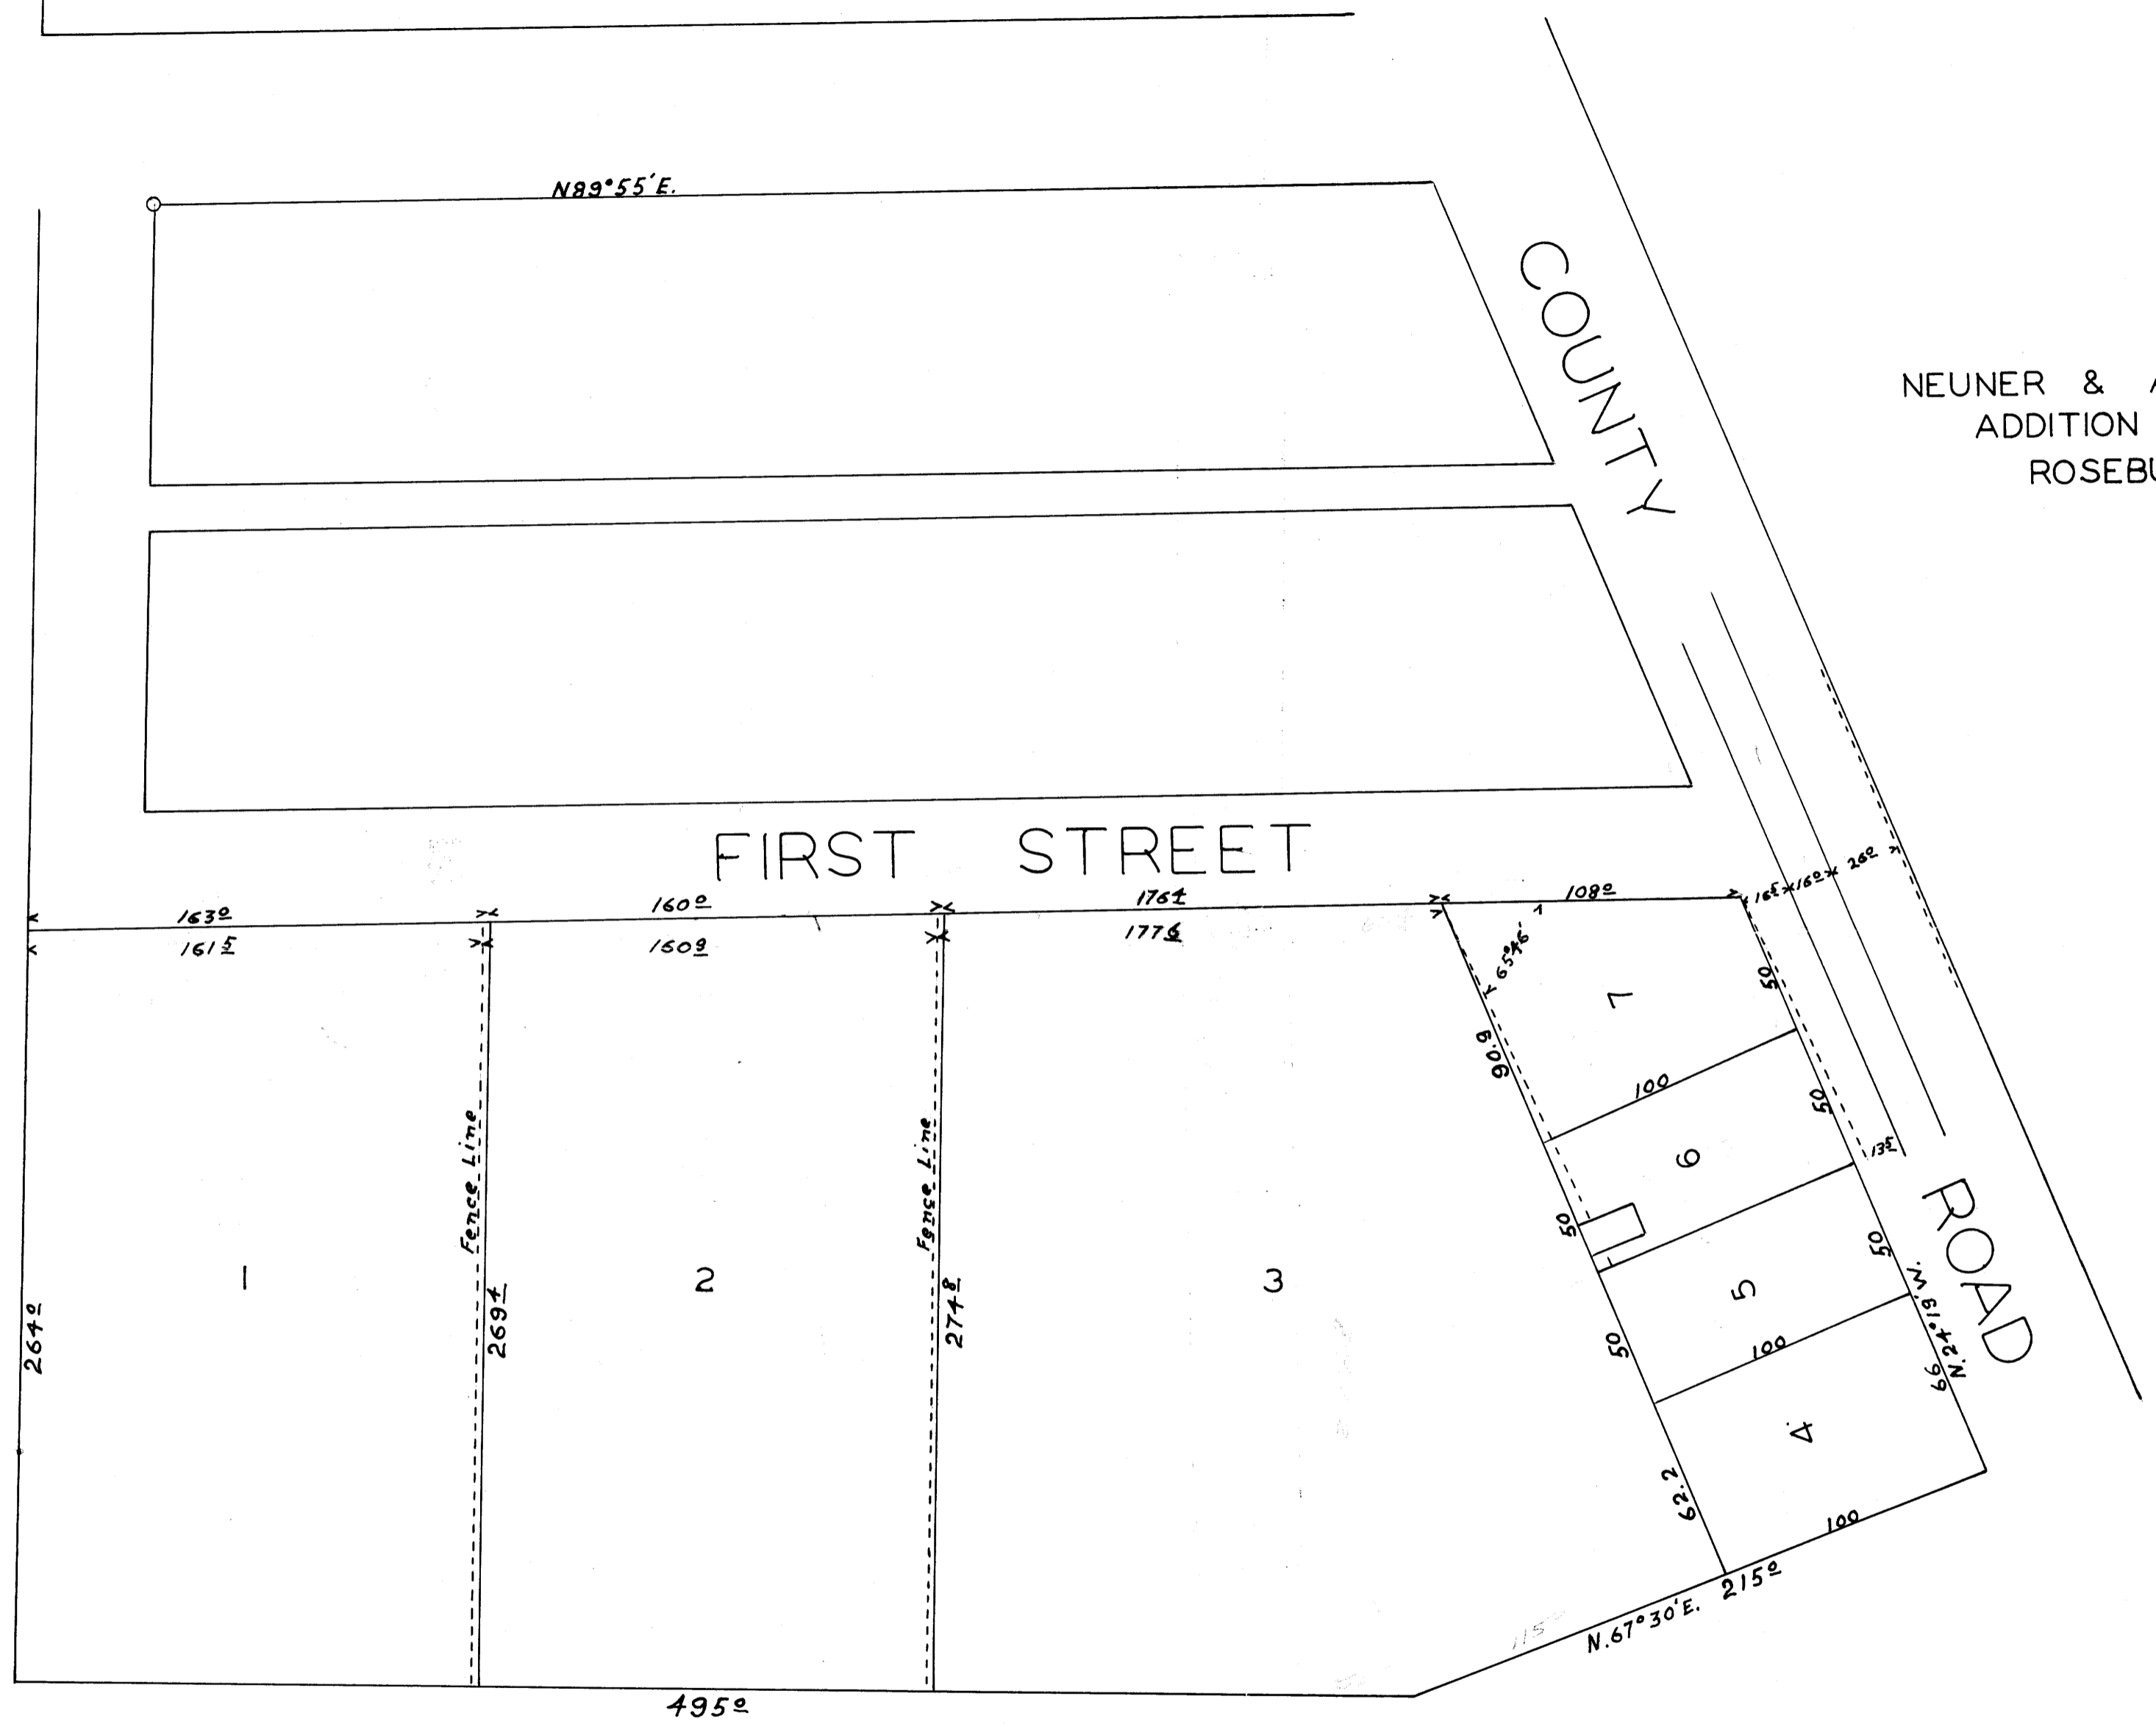

NEUNER & ANDRIE'S
ADDITION TO
ROSEBURG
SCALE 1"=50'

Note: Dotted lines show conditions
existing on ground Feb 27, 1932.
computations of exterior boundaries
show error in original plat
Bert J. Janning
Deputy Co. Surveyor

M 9-49