



DAN RUSSELL
YONCALLA
OCT. 1953 FRED L. DOW
SCALE 1"=50' C.E.

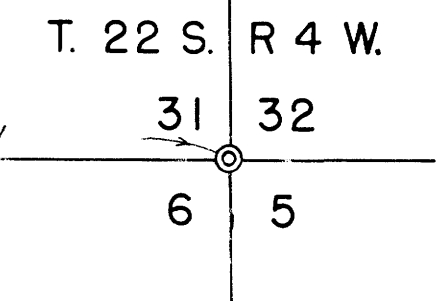


NOTE:-
STONE MARKED WITH +
ORIGINAL BEARING TREE,
AN ASH S5°W 46 LKS.
BEARINGS ARE MAGNETIC,
VARIATION 20°00E


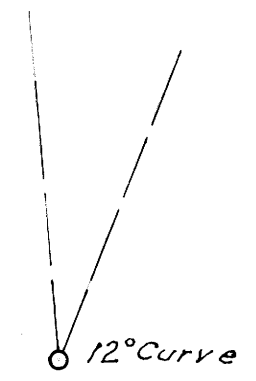


COUNTY SURVEYORS FILE
DO NOT REMOVE FROM OFFICE

FILED
RECEIVED
MAR 2 1958
COUNTY SURVEYOR
DOUGLAS COUNTY, ORE.

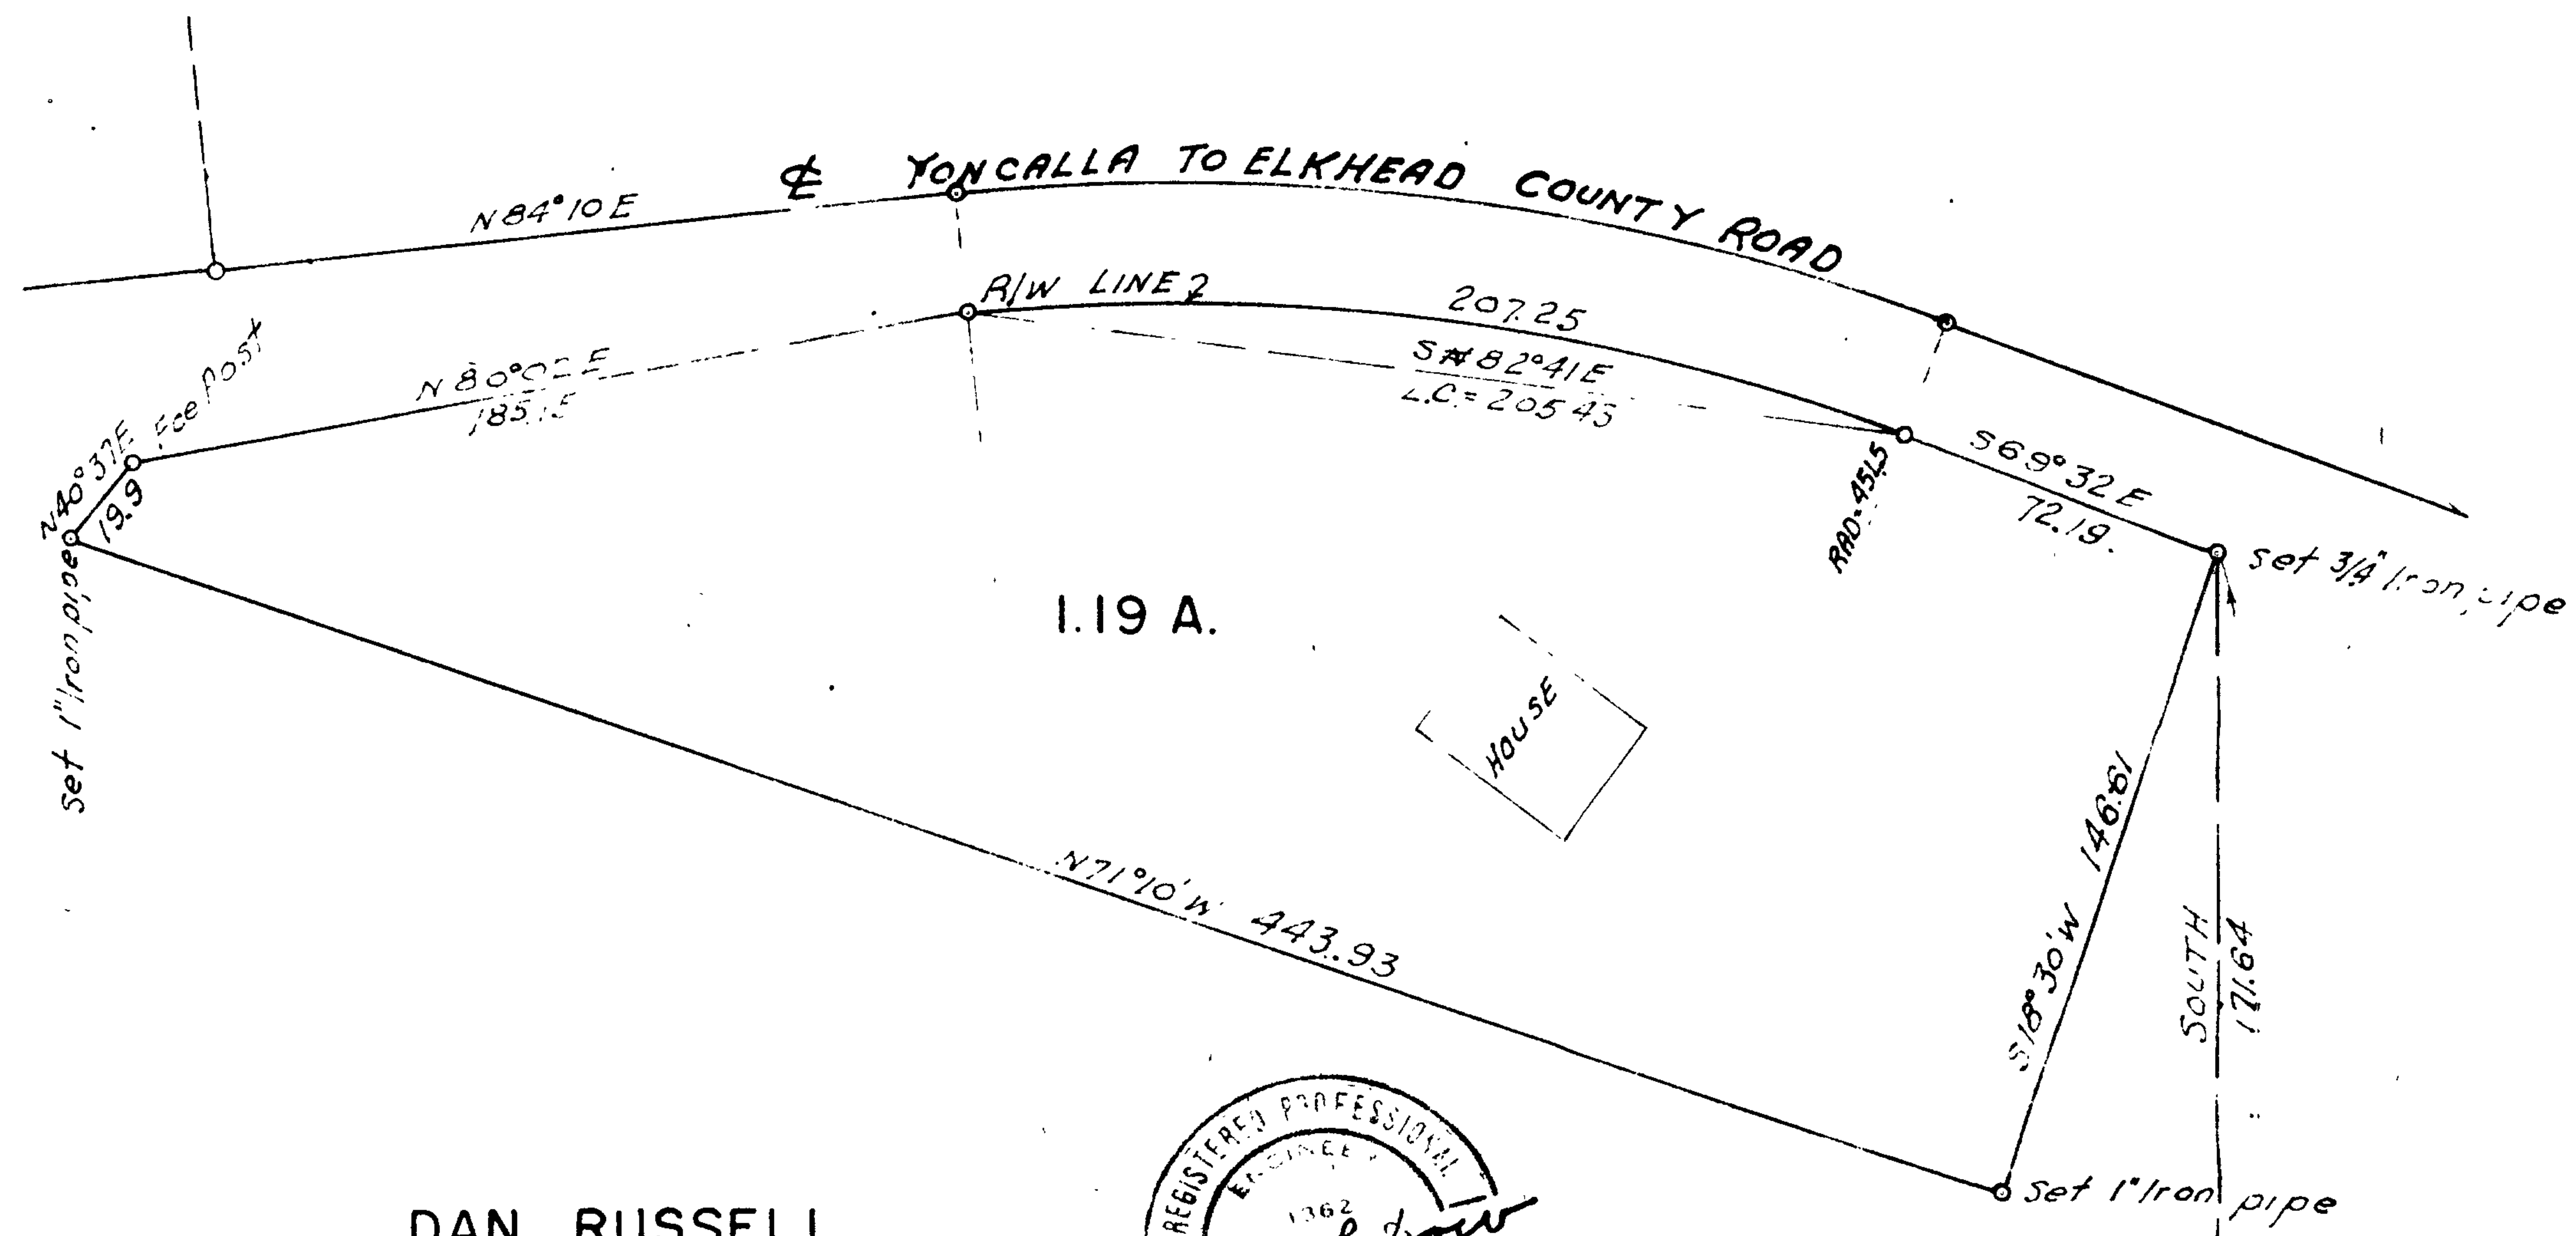

DAN RUSSELL
 YONCALLA
 OCT. 1953 FRED L. DOW
 C.E.
 SCALE 1"=50'

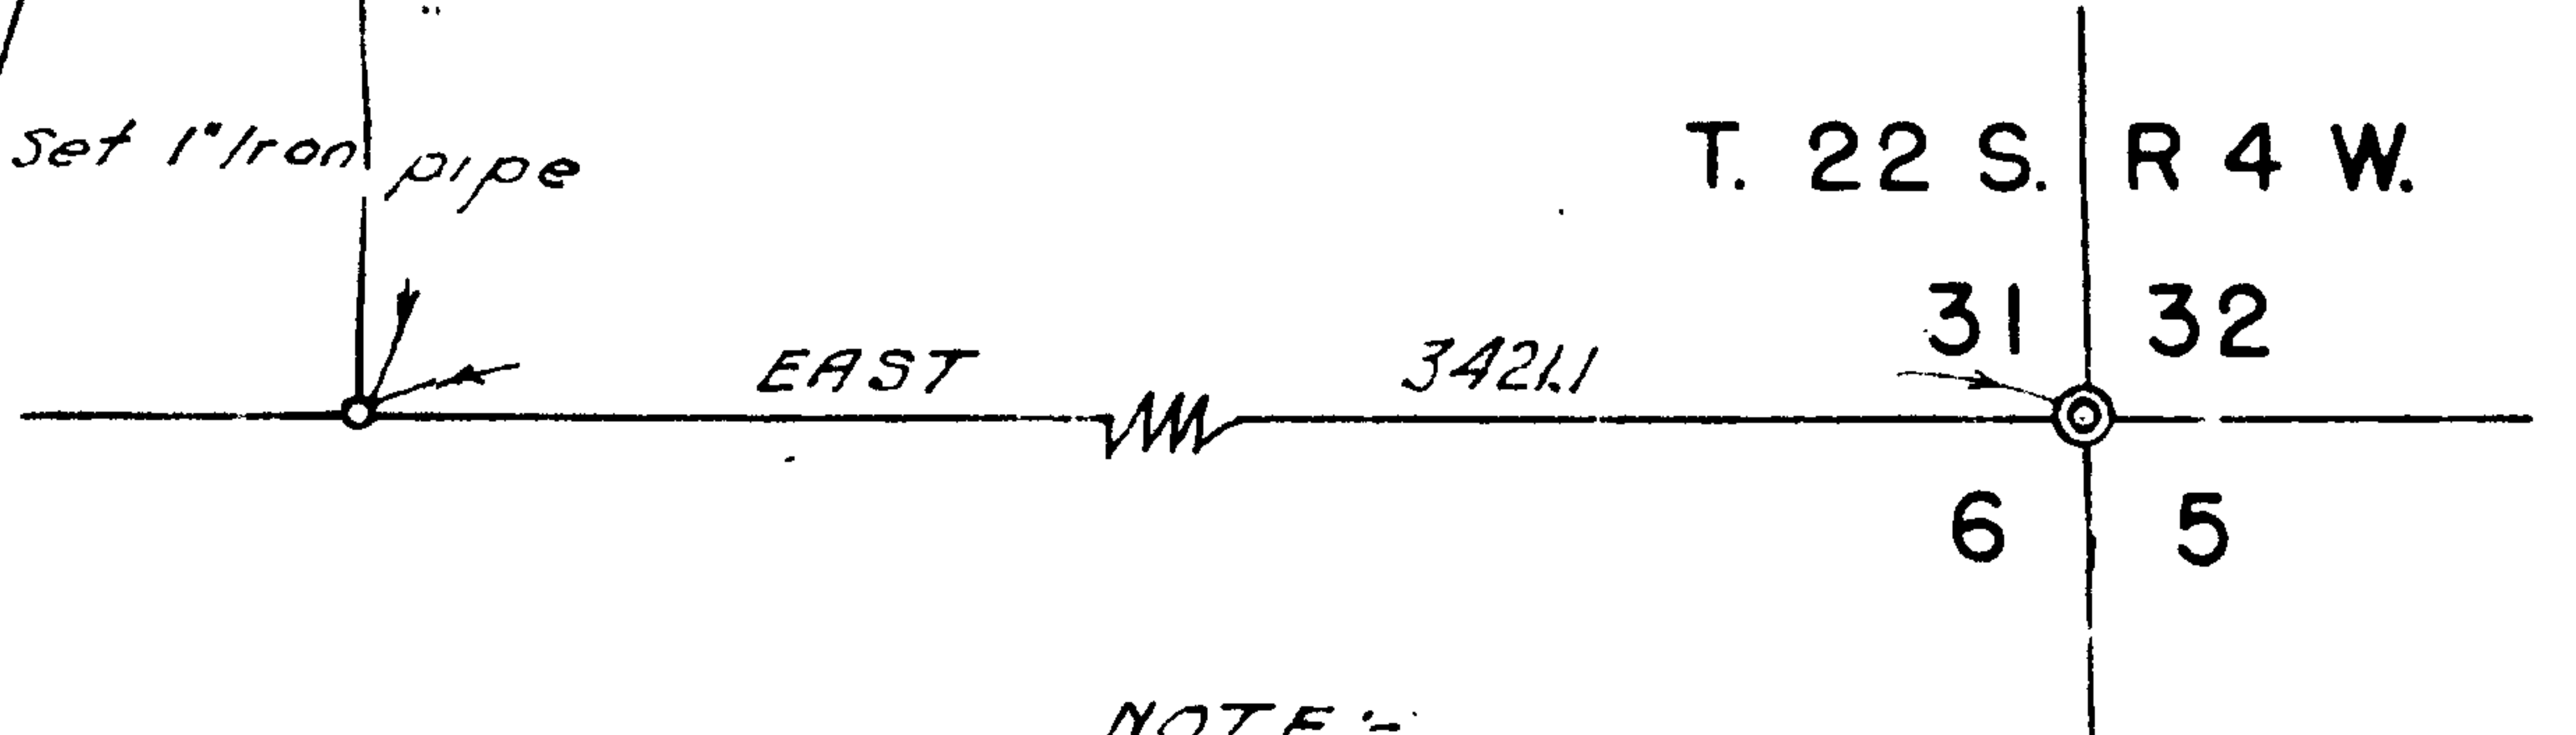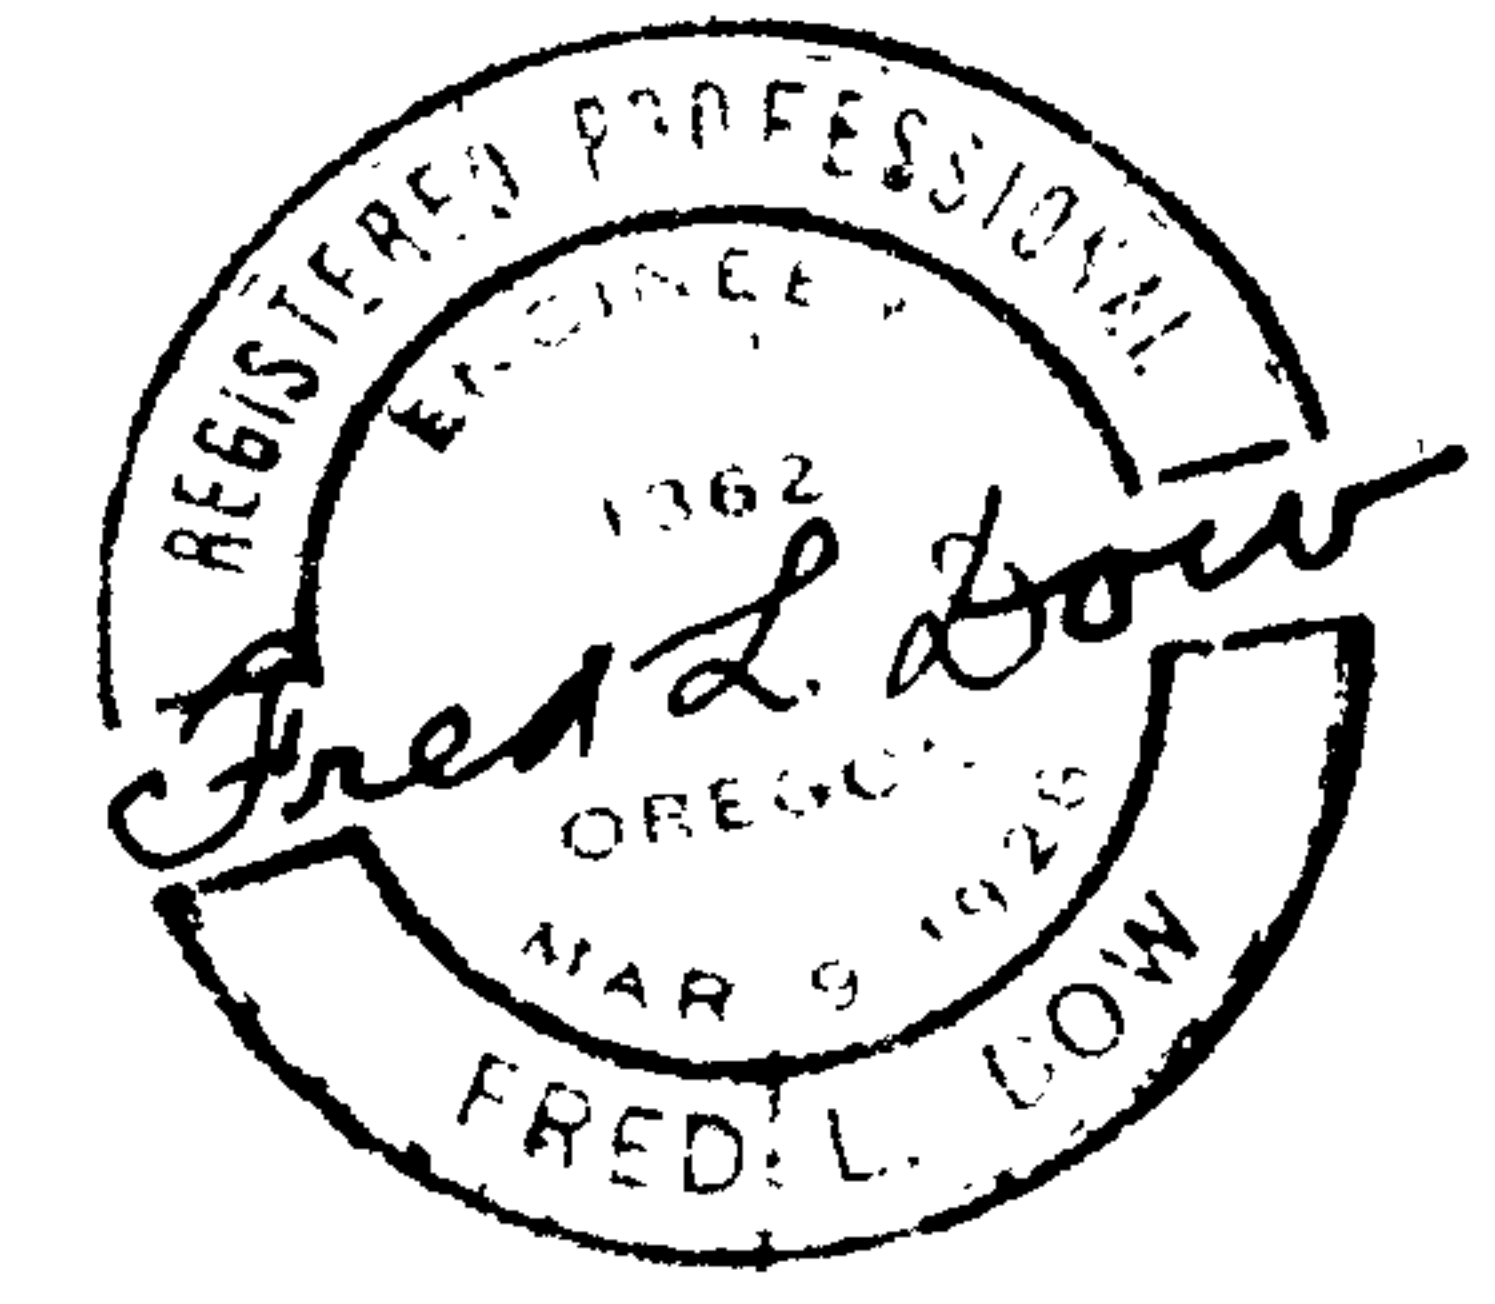

NOTE:-
 STONE MARKED WITH +
 ORIGINAL BEARING TREE,
 AN ASH S 5° W 46 LKS.
 BEARINGS ARE MAGNETIC,
 VARIATION 20° 00' E

