



M 9-64

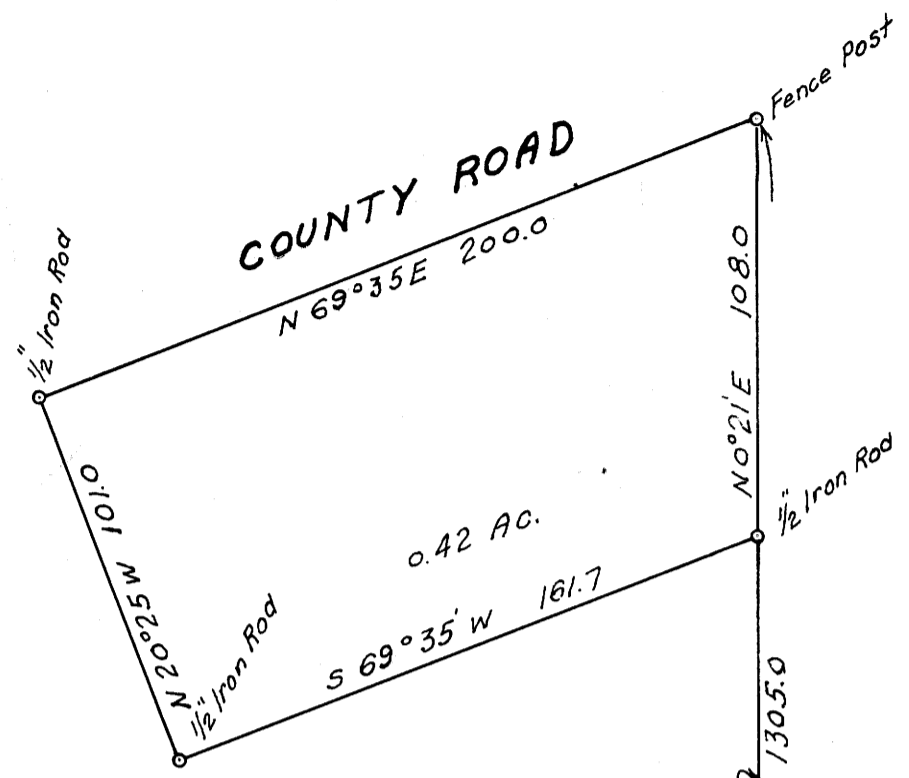


COUNTY SURVEYORS FILE  
 DO NOT REMOVE FROM

H MATLOCK  
 SUTHERLIN OREGON  
 MARCH 1953 FRED L. DOW  
 C.E.

SCALE 1"=50'

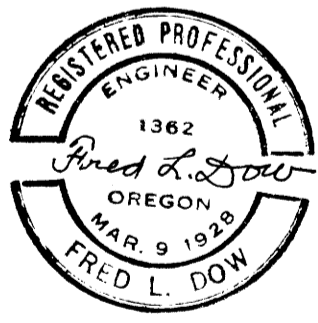

SE CORNER LOT 3  
 BLOCK 1, PLAT "D"  
 S.L. & W. Co.

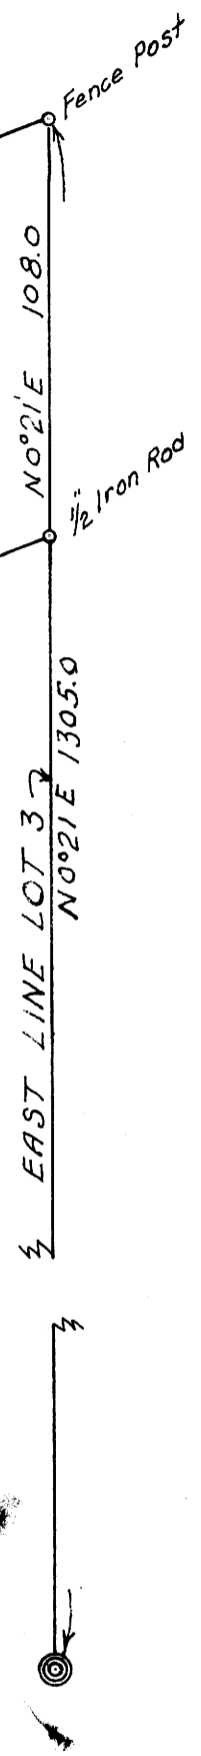

FILED  
 RECEIVED

MAR 23 1958

COUNTY SURVEYOR  
 DOUGLAS COUNTY, ORE.

MAP FILE M9-64