


L9-6 W

M 9-67

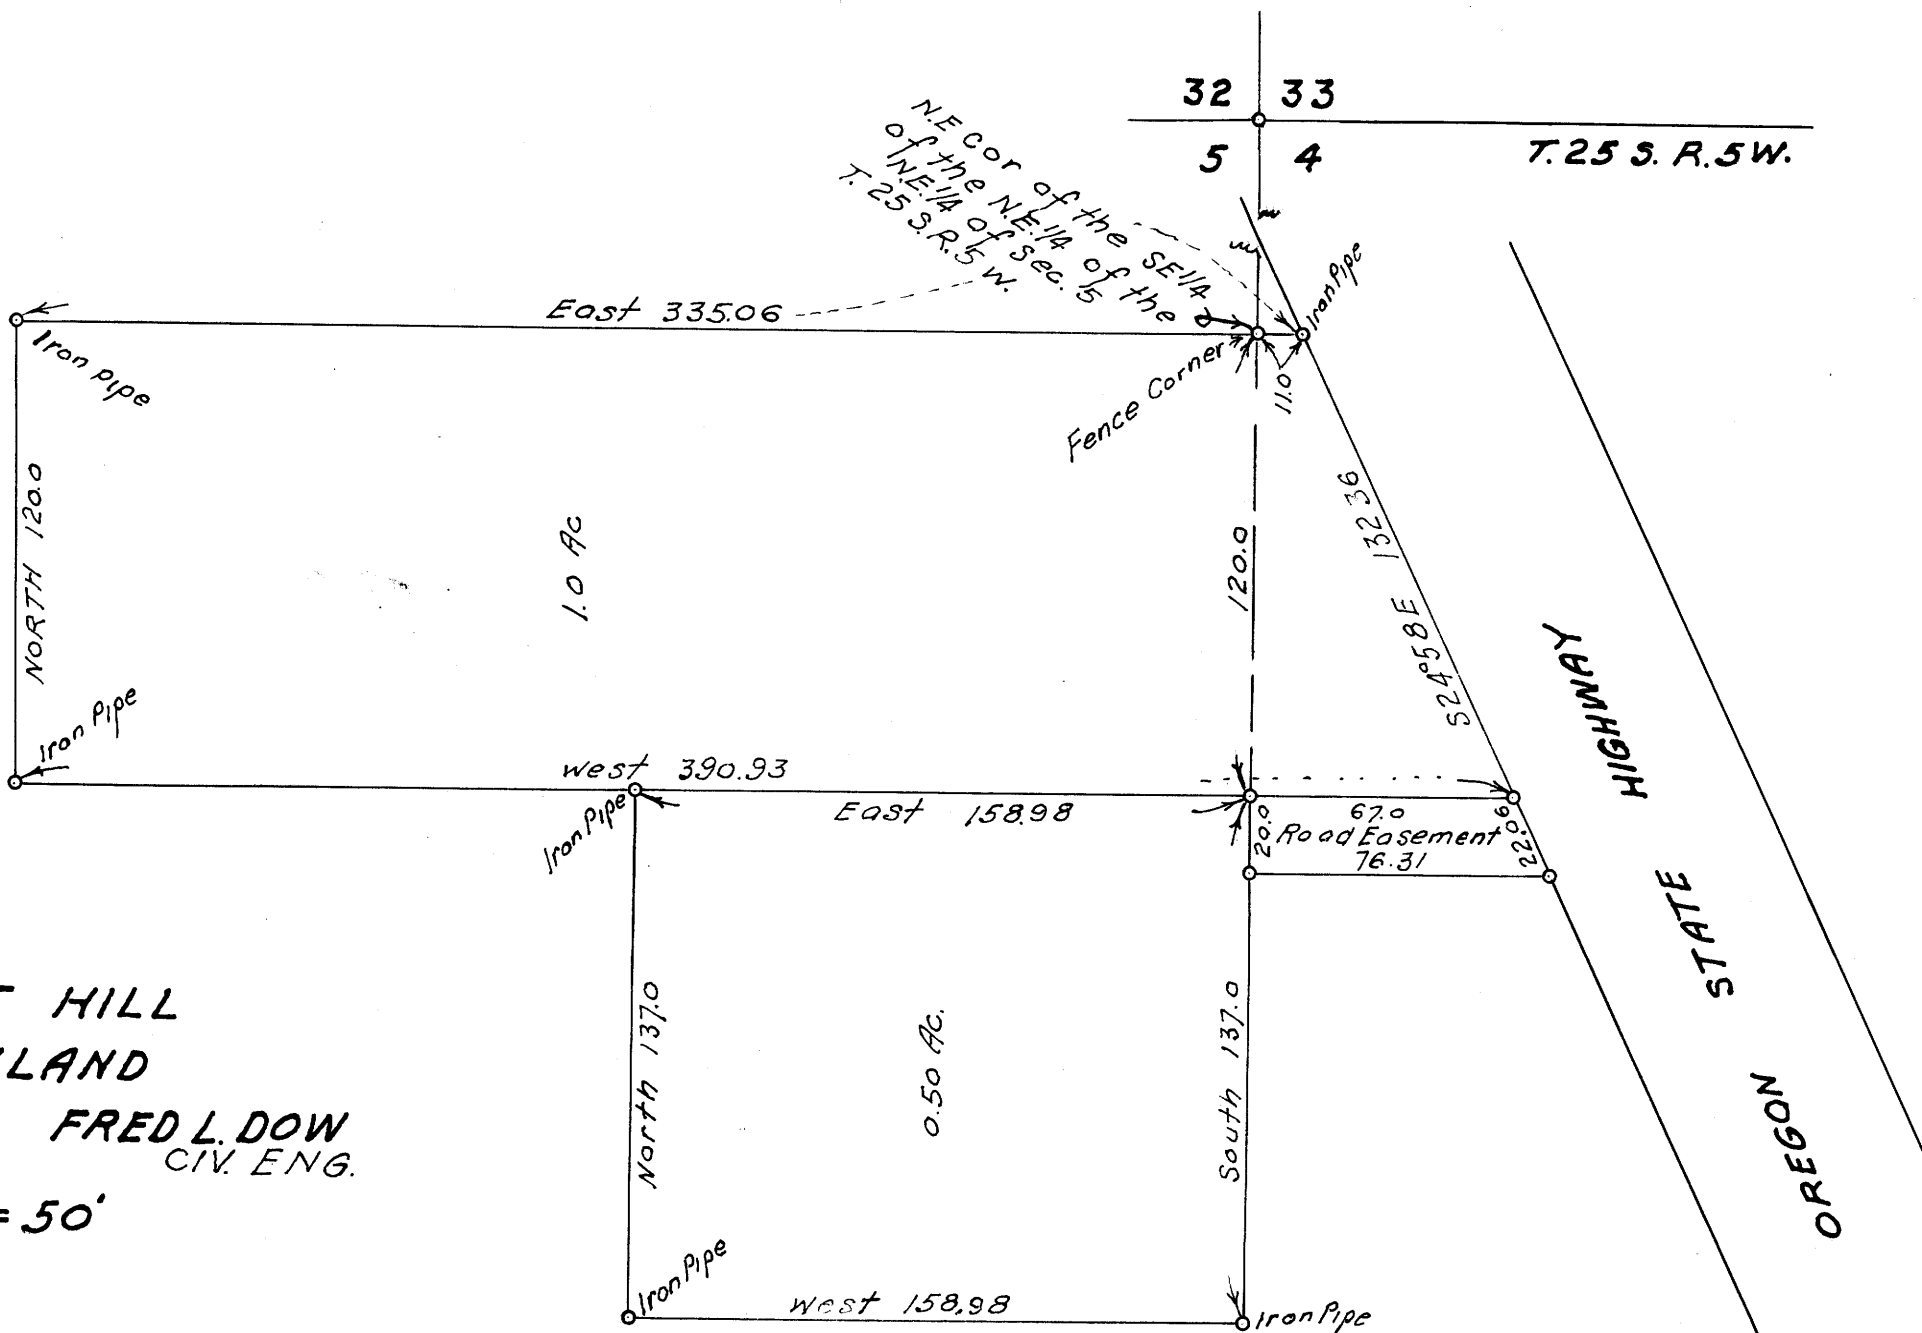

BERT HILL
 OAKLAND
 SEPT. 1953 FRED L. DOW
 CIV. ENG.
 1" = 50'

COUNTY SURVEYORS FILE
 DO NOT REMOVE FROM FILE

FILED
 RECEIVED

MAR 2 1958

COUNTY SURVEYOR
 DOUGLAS COUNTY, ORE.
 MAP FILE M 9-67

L9-6 W