


SCHOOL DISTRICT No. 1

OAKLAND

OCTOBER 1953 FRED L. DOW, C.E.

1"=100'

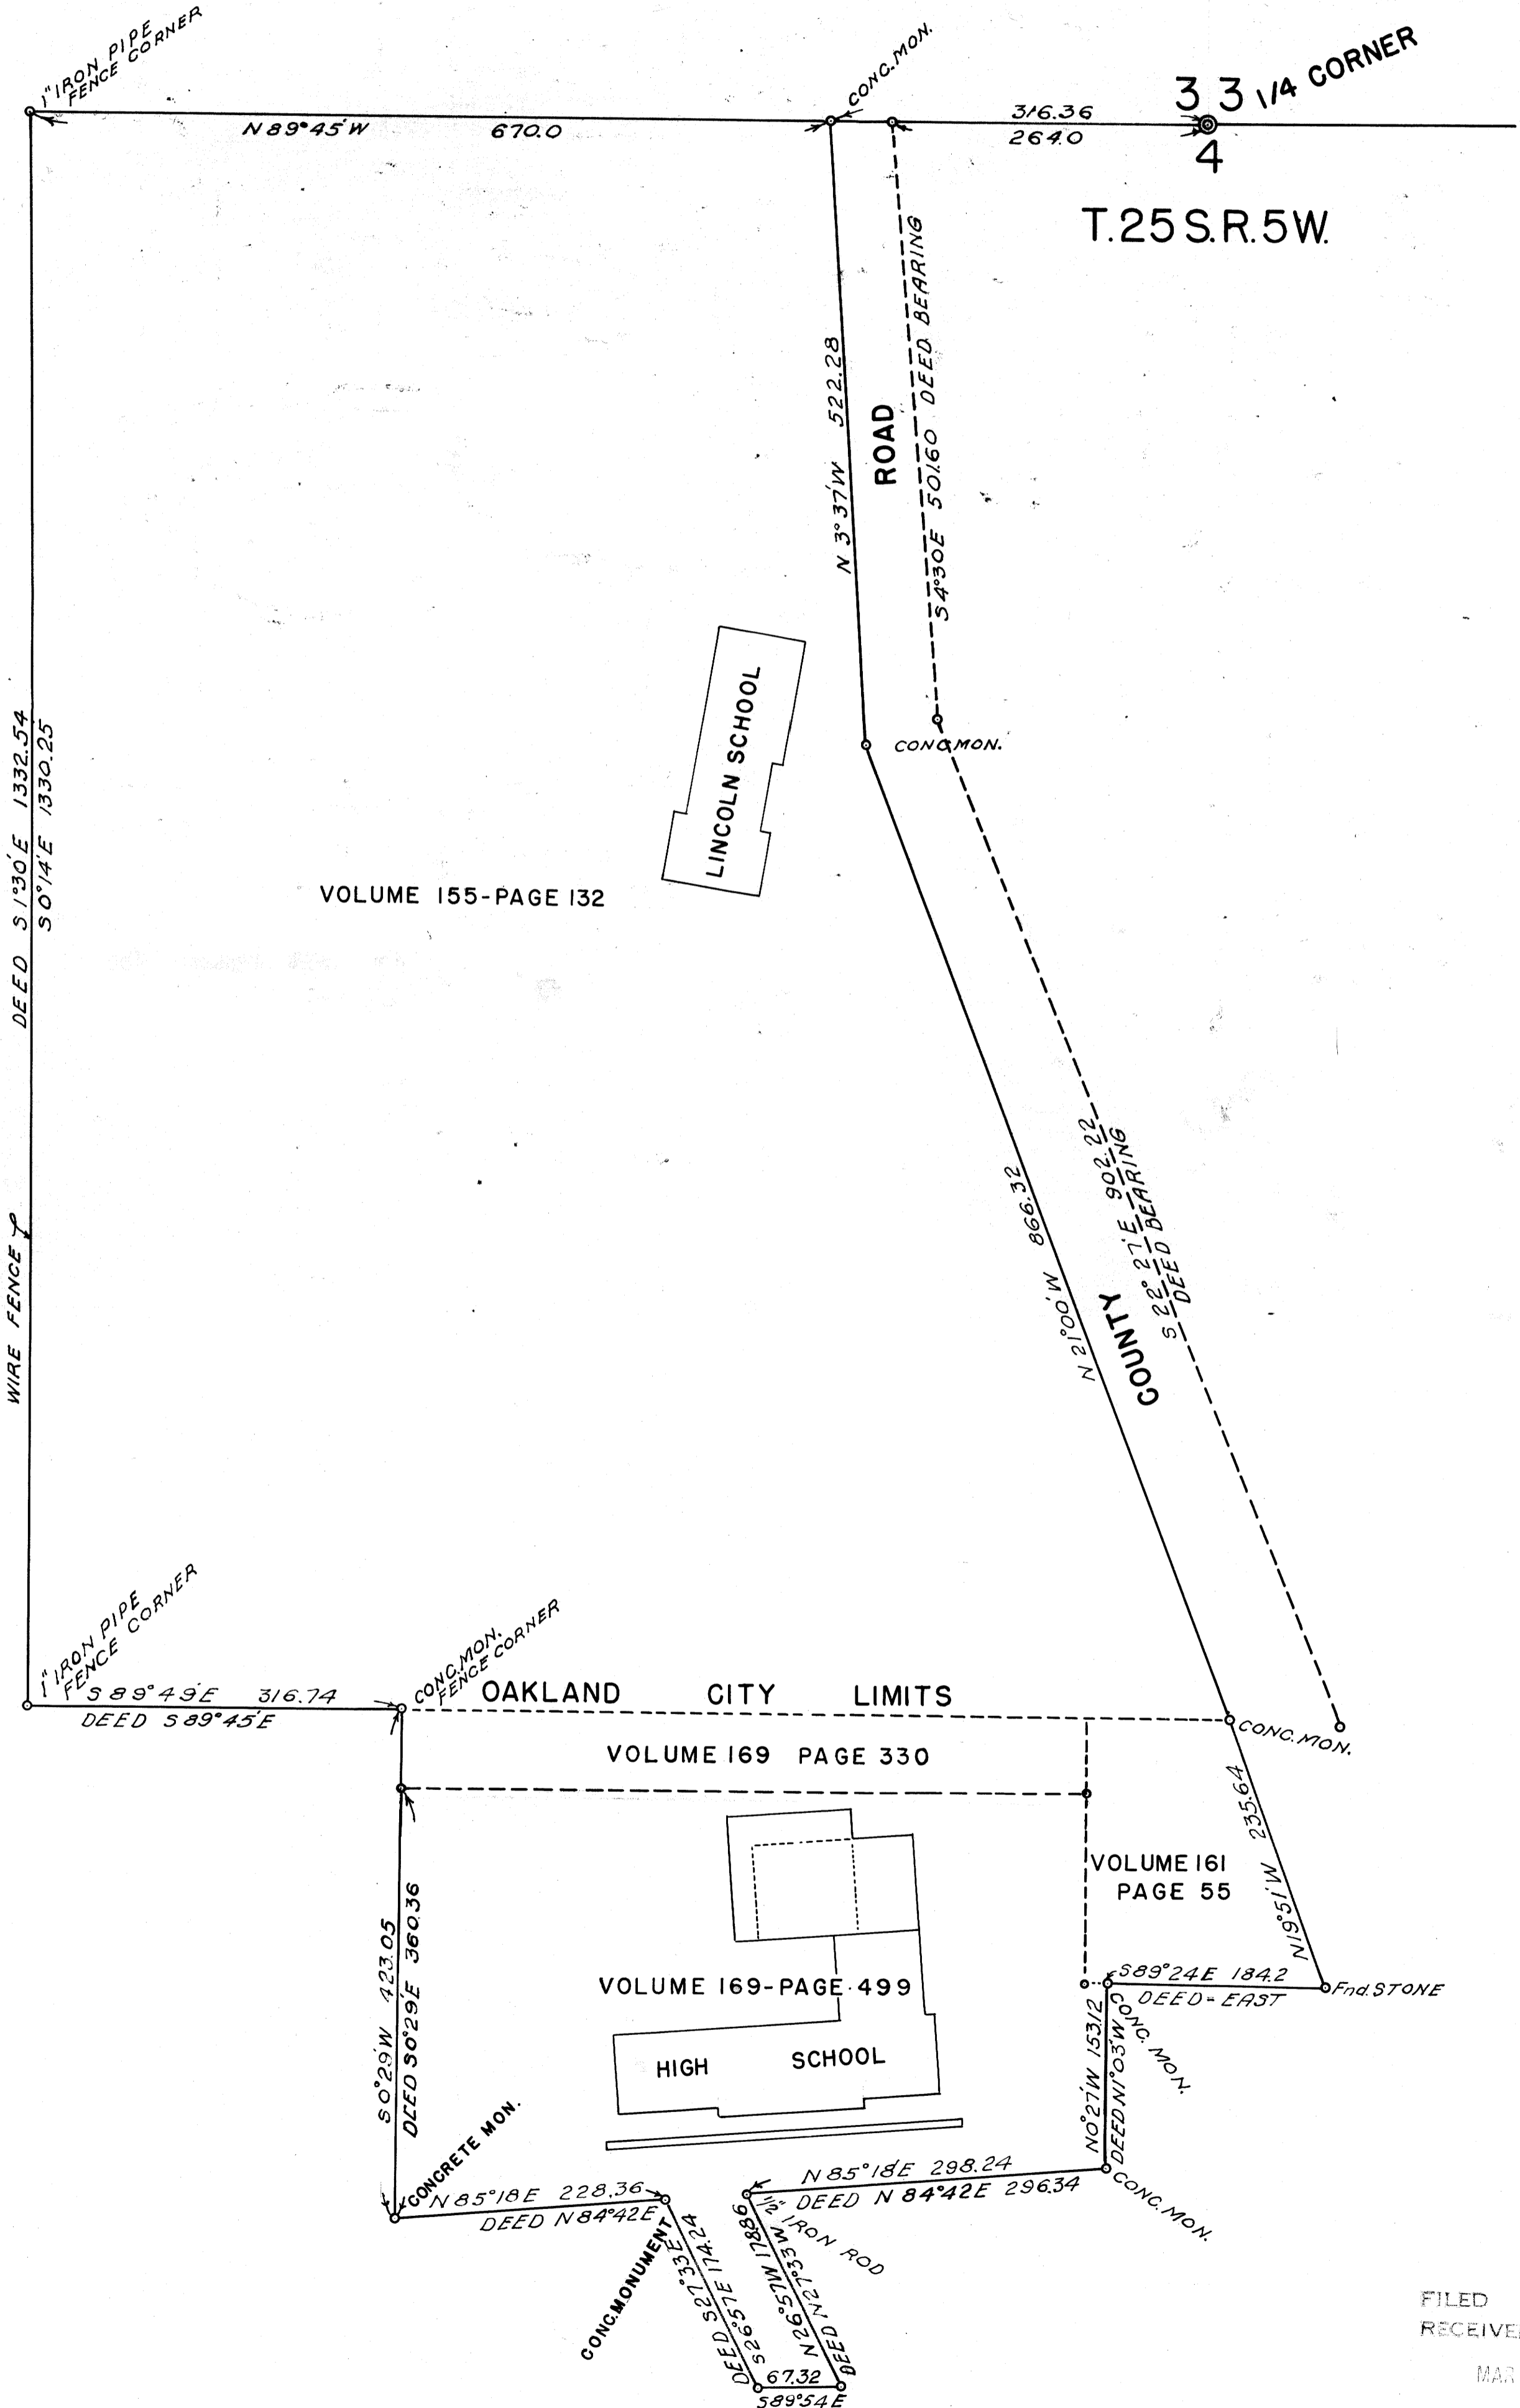

FILED
RECEIVED

MAR 27 1958

COUNTY SURVEYOR
CLATSOP COUNTY, ORE.