


REMAN SEC. COR. FOUND ORIGINAL 12" NON 20" B.C. BT. STAKE. BEARING SHOULD BE S89°30' E. DISTANCE 58.4'. ALSO FOUND N.E. ORIGINAL N.M. BT. BOTH CORNERS PARTLY ROTTEN. COR. ON N.S. FENCE LINE. ALSO FOUND 1" ROD AT COR. SET BRASS CAP ALONG SIDE MKR. THIS T.B.S. R.5 W. COUNTY SURVEYORS OFFICE 1958. A 20" RED FIR BEARS S38°W 12' CORNER S.W. COR. R.5 W. C.S. 7. 10" W.O. BEARS N17°30' E 15.0' CORNER S. BT. 245. R.5 W. C.S. 7. 6" LAUREL N80°W 12.2' SERIATED S.T. 245. R. 5 W. C.S. 7. 6" W.O. BEARS EAST 13.2' SERIATED S.T. 245. R.5 W. C.S. 7.

NOTE: BEARINGS SHOWN ARE MAG. BEARINGS BASED ON THE WEST LINE OF OLD U.S. 99.

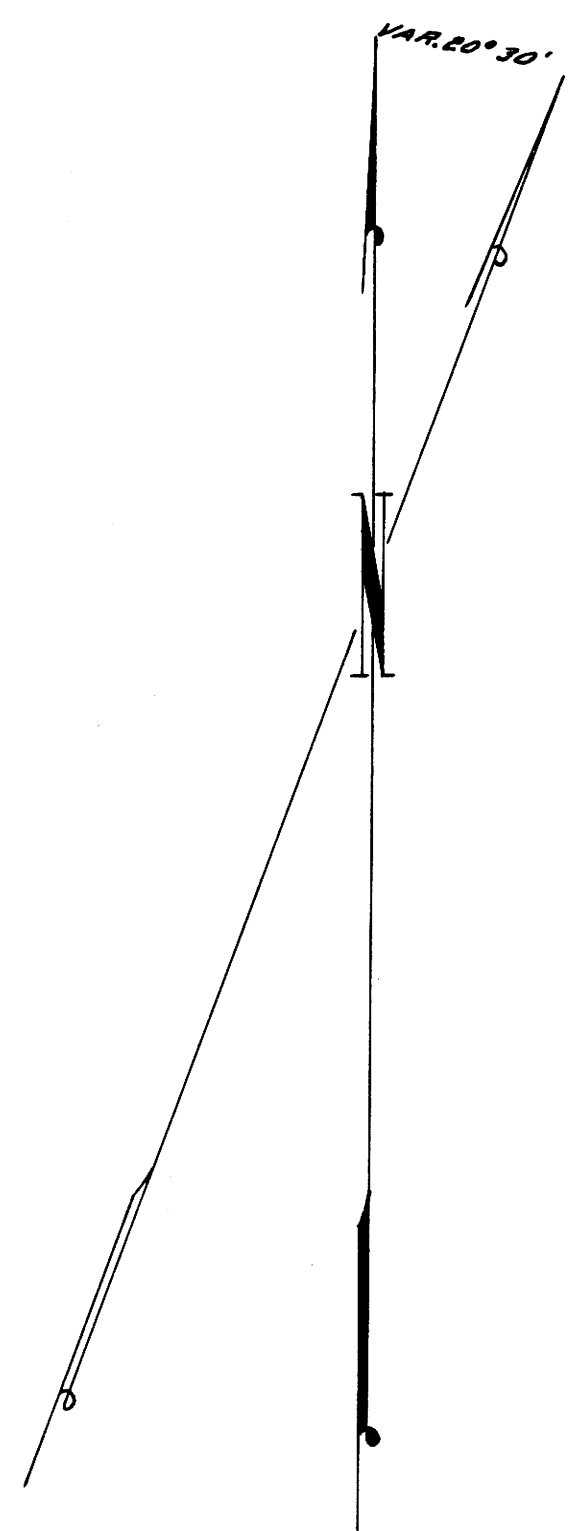

COUNTY SURVEYOR'S OFFICE
DOUGLAS COUNTY, OREGON

SURVEY FOR DEED DESCRIPTION
SECTION 7, T24S., R.5W., W.M.

FRED M. DARBY COUNTY SURVEYOR
SURVEYED APRIL 1, 1958 BY
JAMES W. BYRON - DEPUTY SCALE 1" = 50'
SURVEYED FOR LEROY CHURCHILL

James W. Byron

COUNTY SURVEYORS FILE DATA
DO NOT REMOVE FROM OFFICE

CS FILE FOLDER

CONTAINS

MORE

INFORMATION