


THIS COPY MADE FROM
A XEROX 2510
DATE 3-30-89

MAP
OF
PORTION OF H. CARSON DLC #50
T29S, R5W, W.M.
PREPARED FOR G. GATES
SEPTEMBER 1947
SCALE \approx 1-inch = 200 ft.

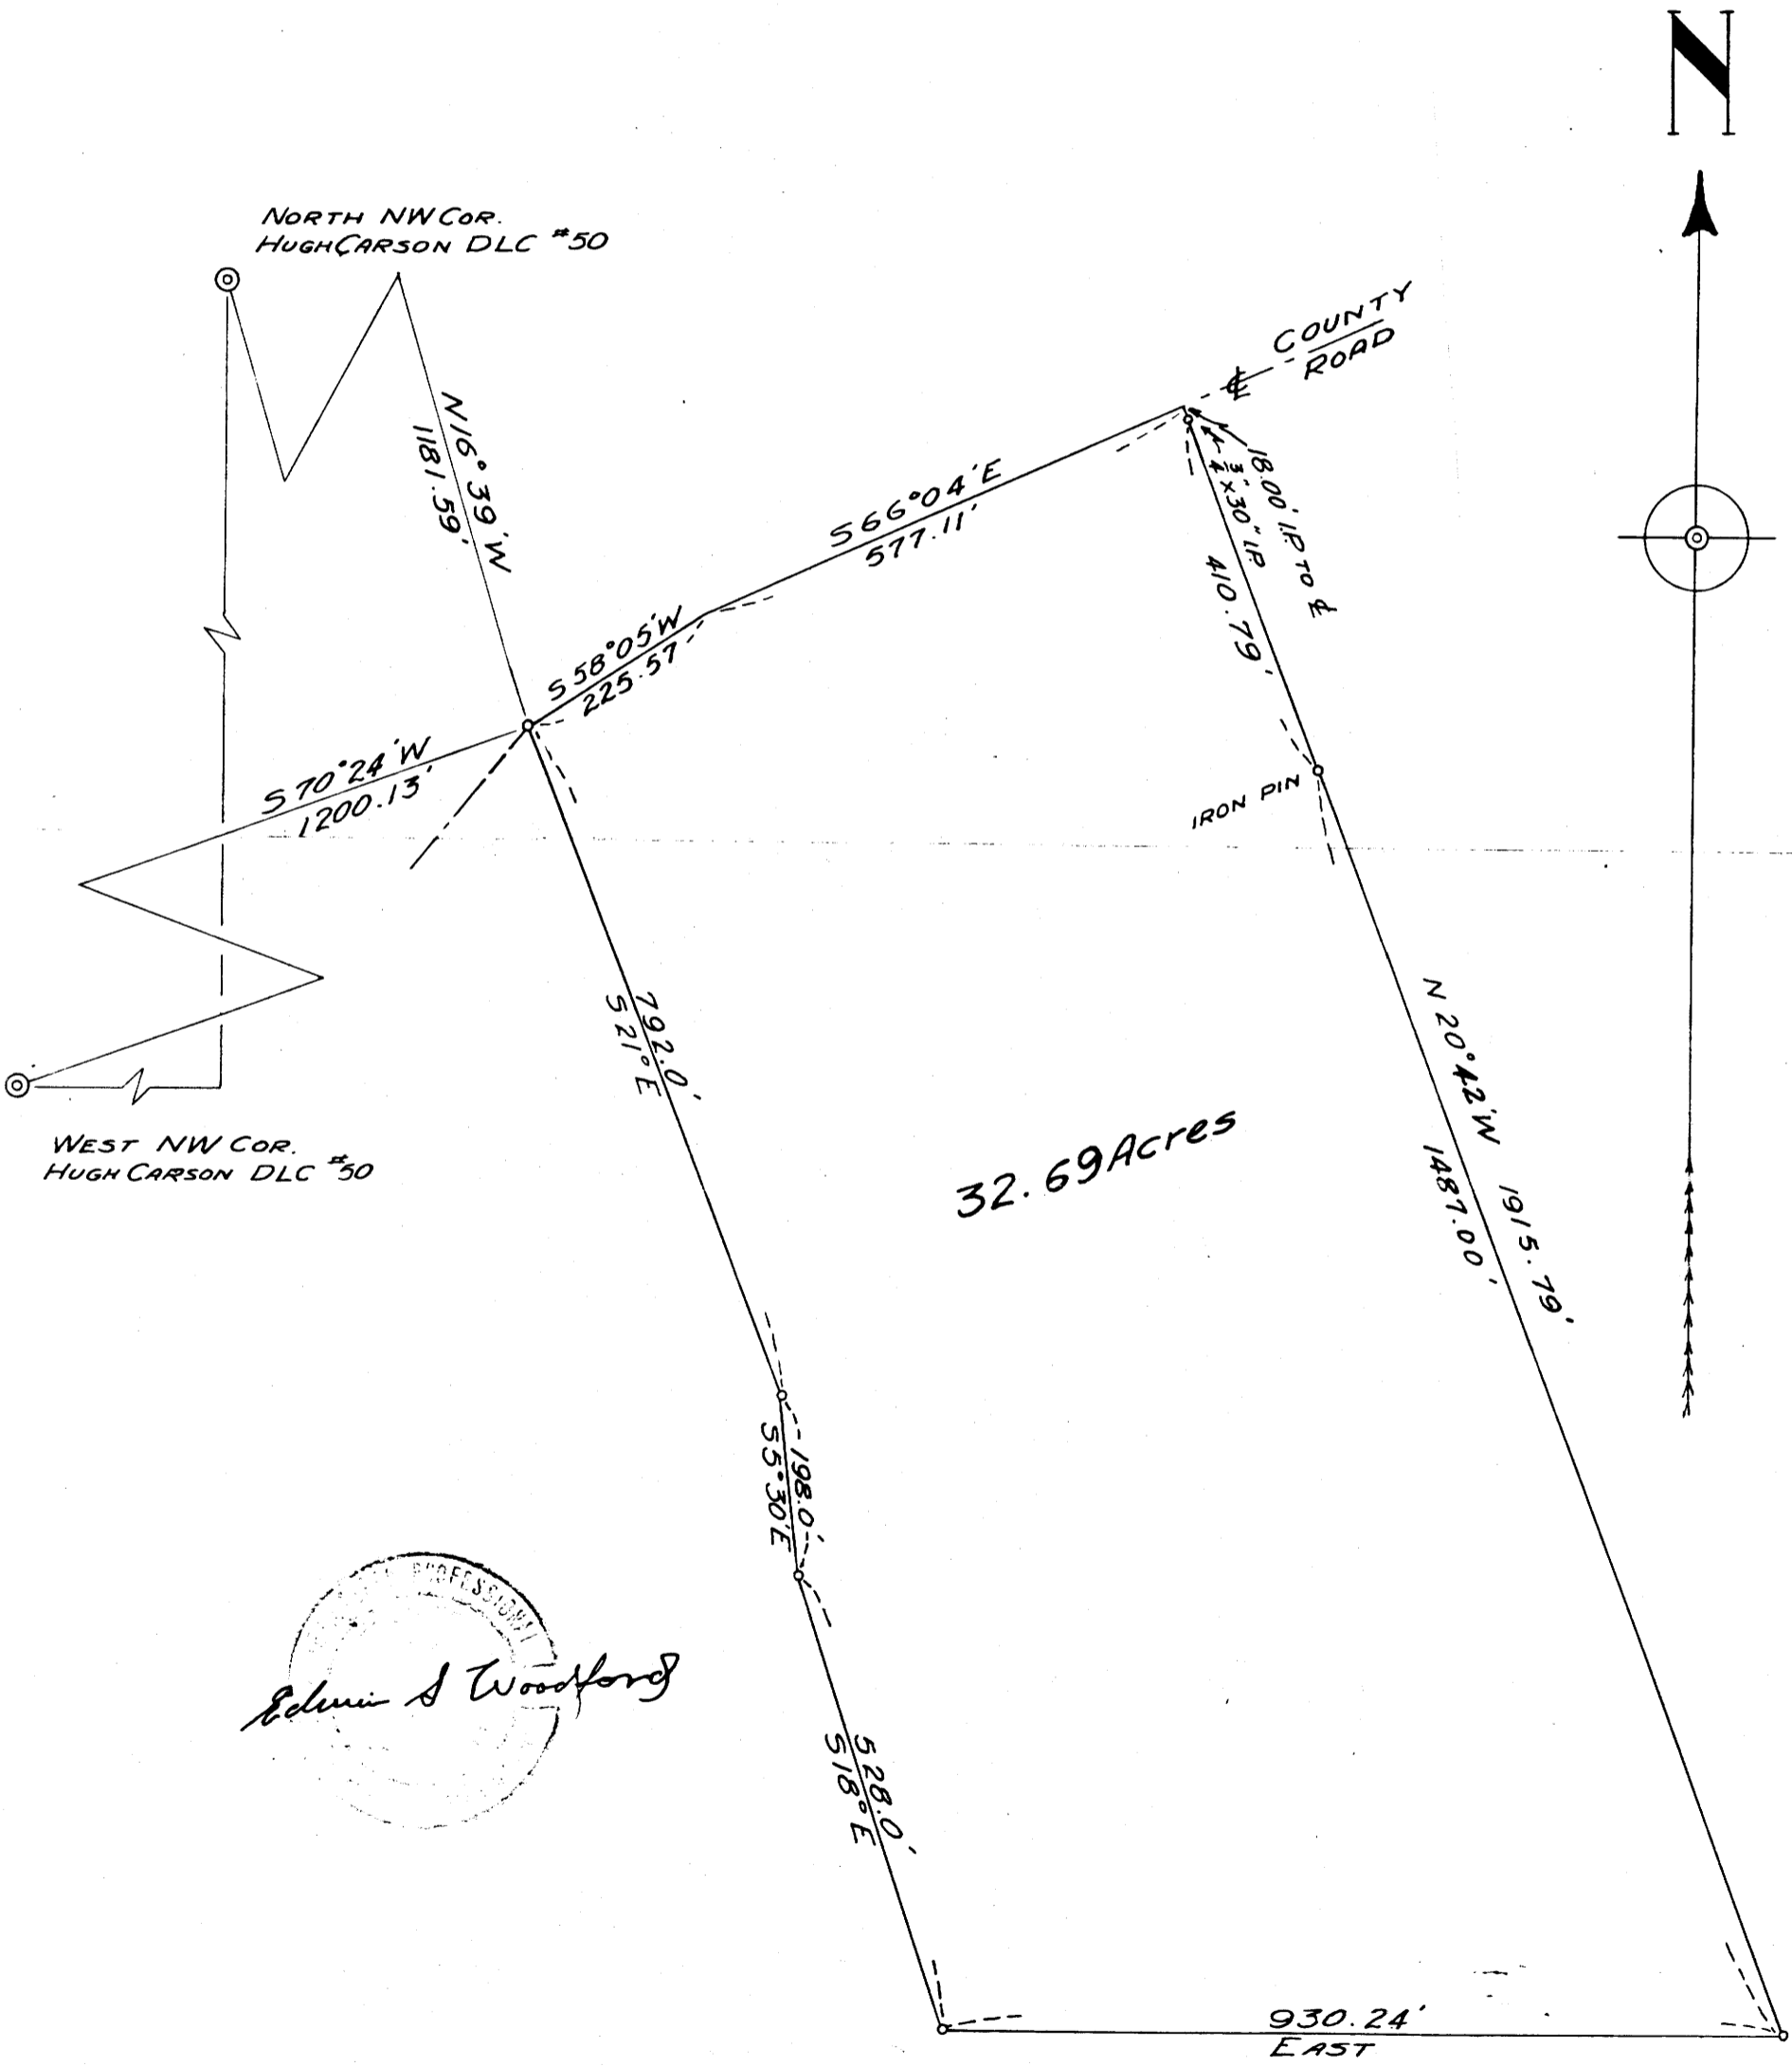

Edwin S Woodford

CS FILE FOLDER

CONTAINS

MORE

INFORMATION