


D.S. 421359
M 10-30

C.S. 42/359
M 10-30



o = 1/2" X 30" Pipe set

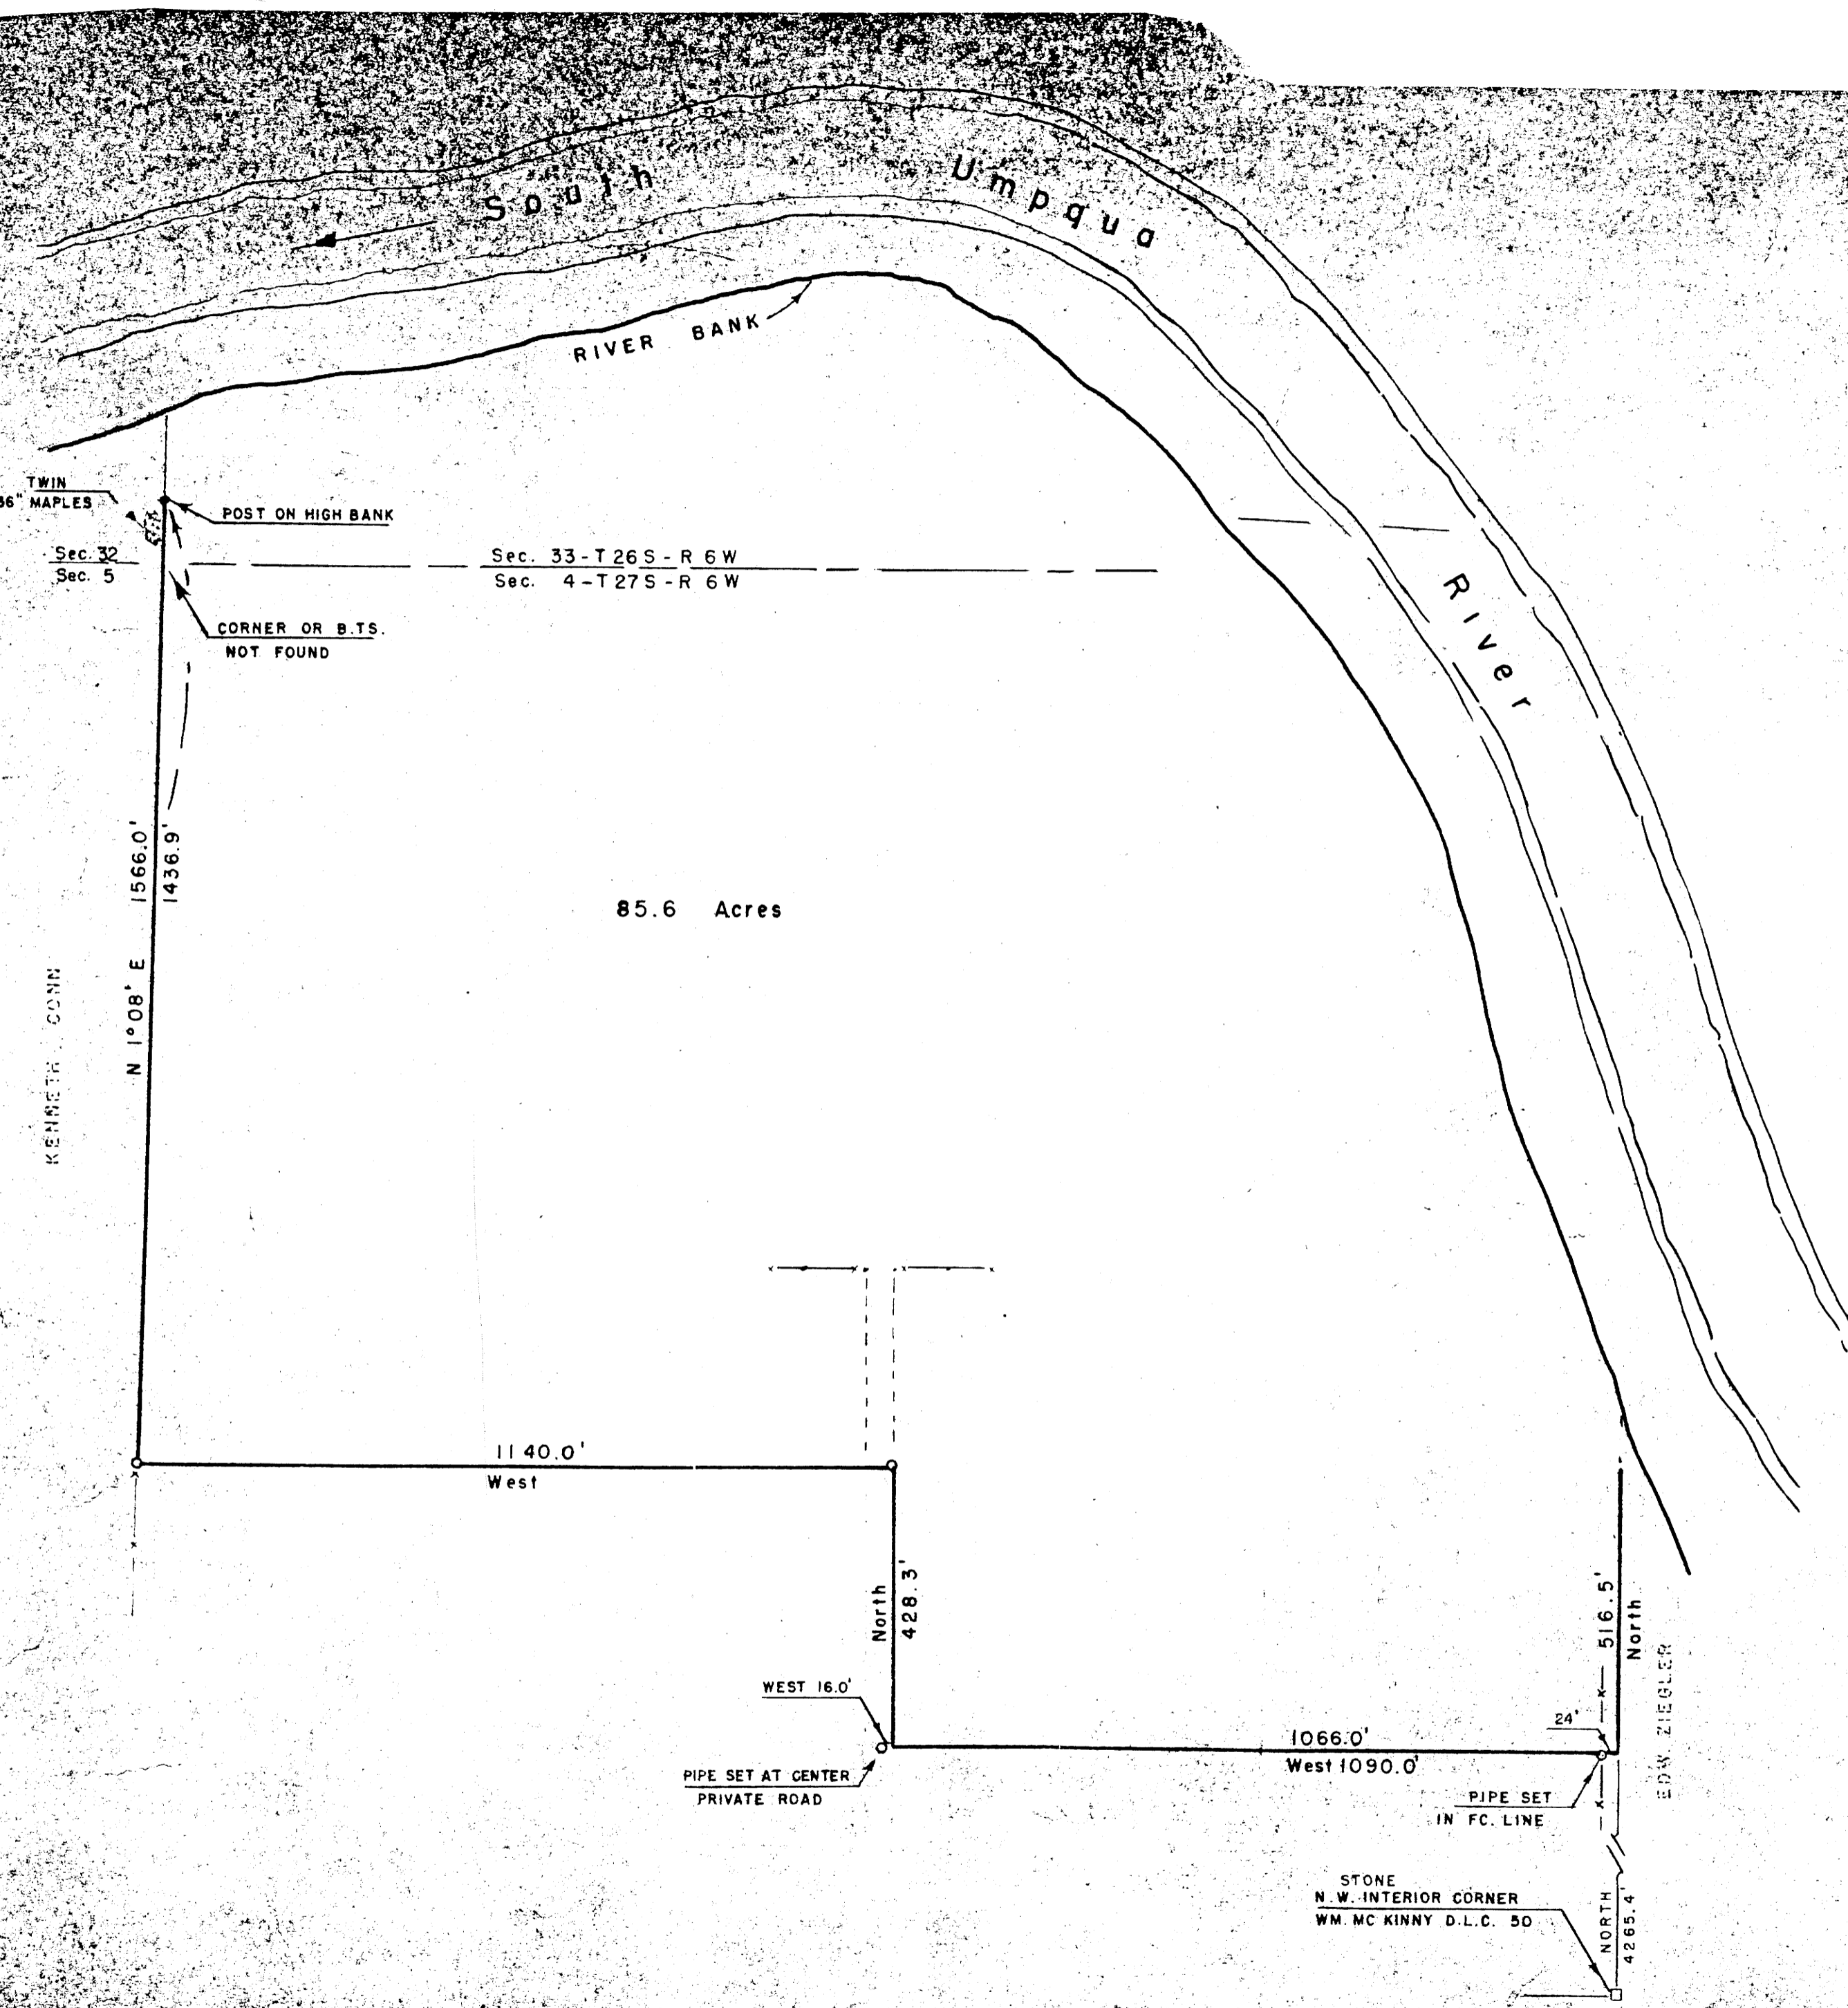

PLAT OF PART OF
BUSENBARK BROS. Property

IN SECTIONS 33-T26S and 4-T27S - R6W W.M. Douglas Co., Ore.
 MAY 1957 Scale 1" = 200'

THIS COPY MADE FROM
 A XEROX 2510
 DATE 3-10-89

FILED
 RECEIVED

MAY 4 1958