
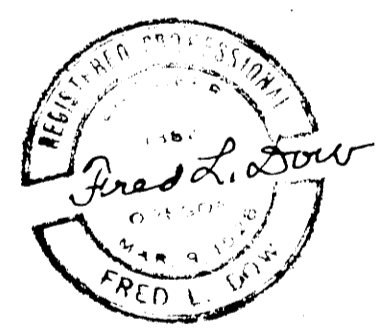


THIS COPY MADE FROM  
A XEROX 2510  
DATE 3-16-89

M 10-44

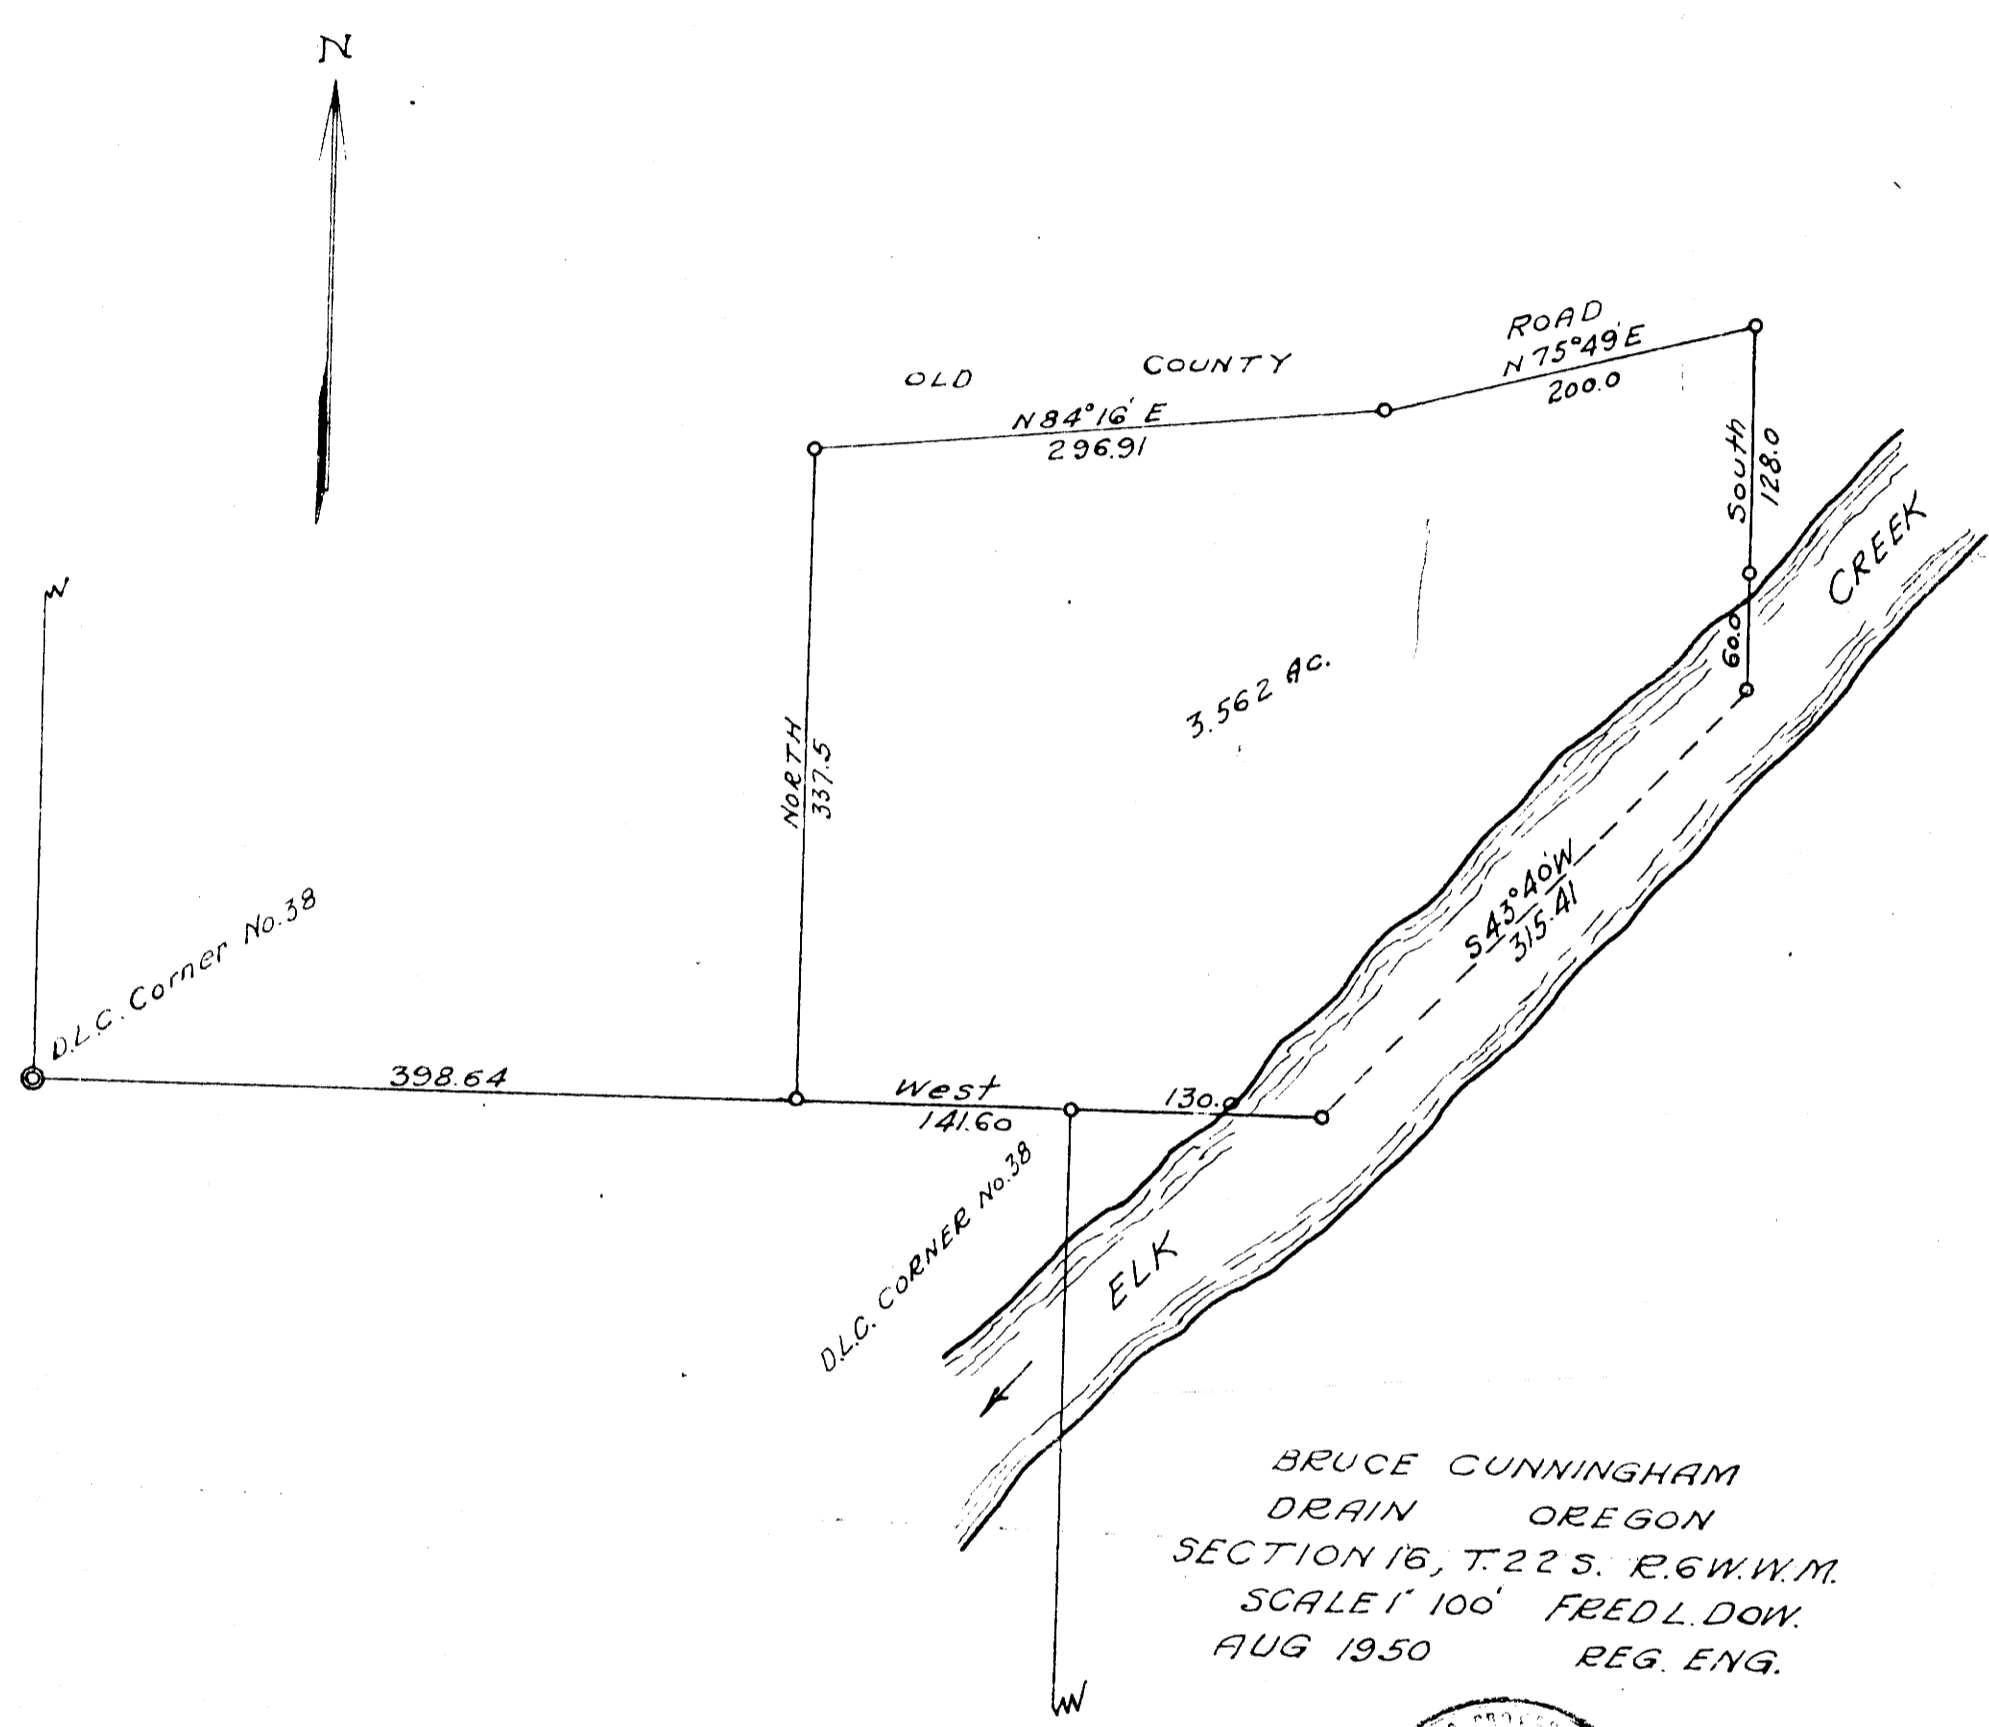

CS FILE NO/282  
M 10-44

COUNTY SURVEYORS FILE DATA  
DO NOT REMOVE FROM OFFICE