


26-01 W


COUNTY SURVEYORS FILE DATA
DO NOT REMOVE FROM OFFICE

WALTER PETERSON
DRAIN OREGON
JUNE 1951 200' = 1"

FRED L. DOW = CIV. ENGINEER

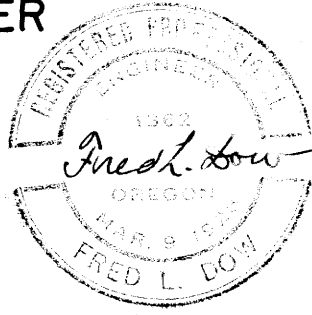

T. 22 S. R. 6 W.

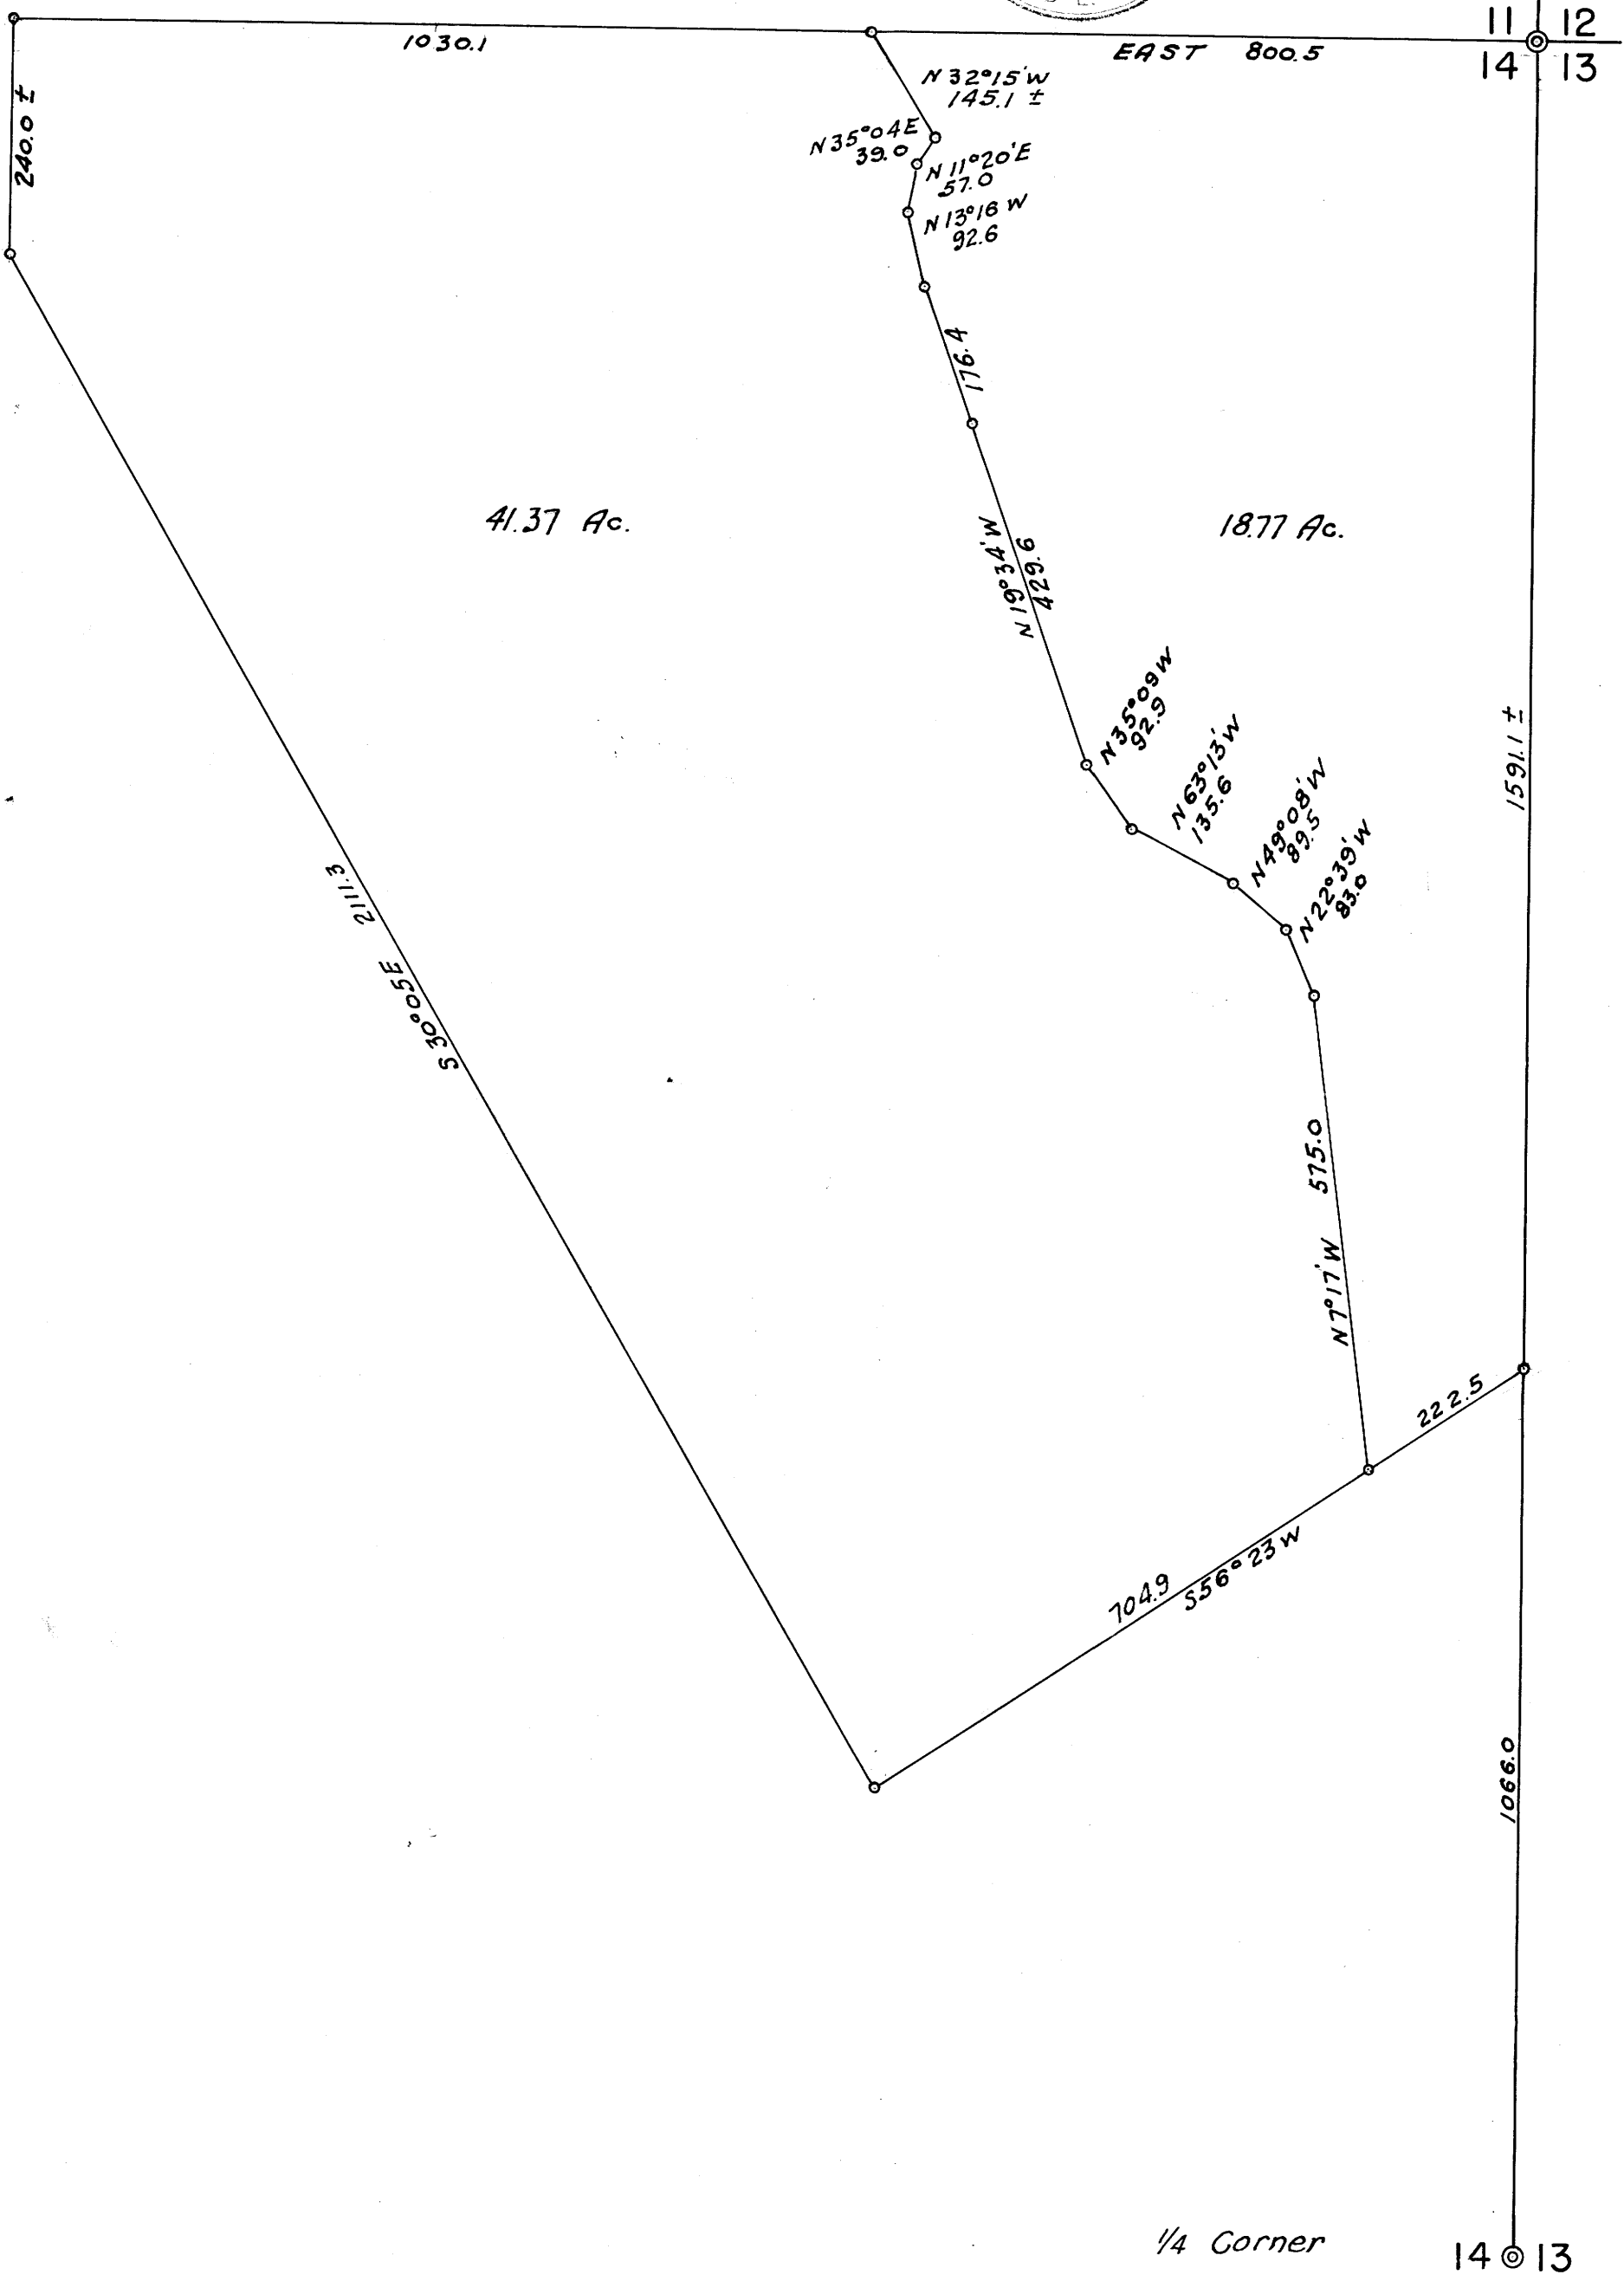

CS FILE FOLDER

CONTAINS

MORE

INFORMATION