



**COUNTY SURVEYOR'S OFFICE
DOUGLAS COUNTY OREGON
SURVEY FOR DEED DESCRIPTION
IN U. DAISLEY D.L.C. No 37, & SECS.
17 & 8, TWP 22 S, R 6 W. WM.**

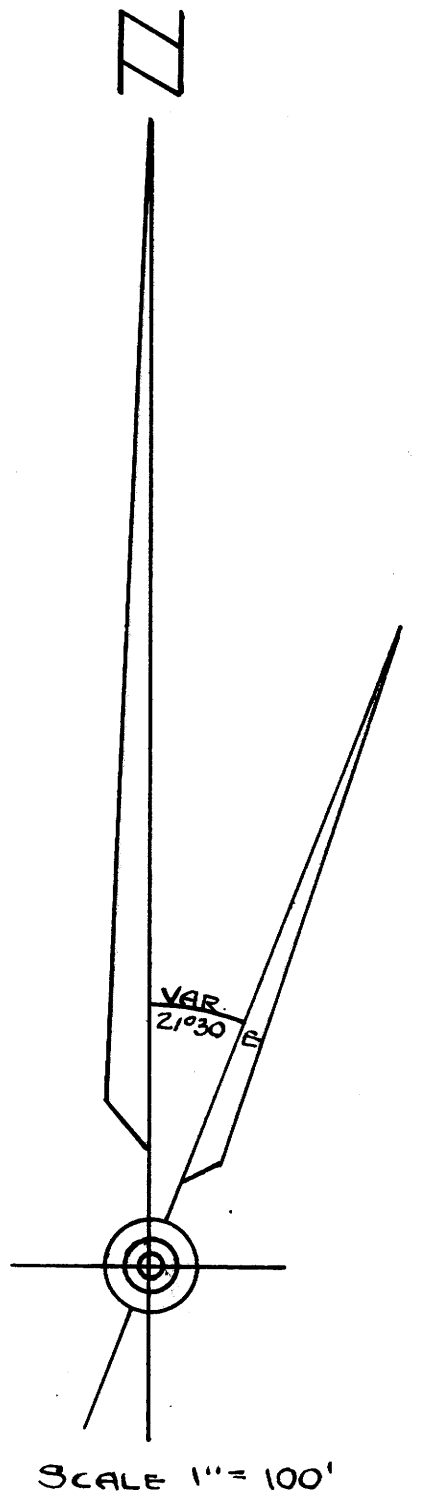

BEARINGS ARE BASED ON THE BEARING OF THE SOUTH BDRY OF D.L.C. No 37, AS ESTABLISHED BY CO. SURVEYOR'S OFFICE IN SURVEY OF 1919.

BEN B. IRVING
SURVEYED,
N.E. RICHARDSON

COUNTY SURVEYOR
JULY, 1950, BY
DEPUTY

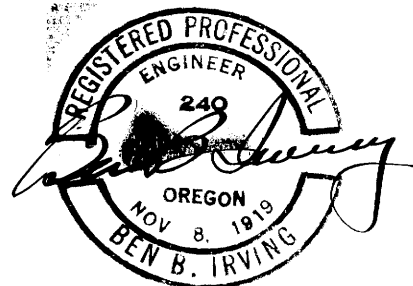

COUNTY SURVEYORS FILE DATA
DO NOT REMOVE FROM OFFICE