


56-01-00

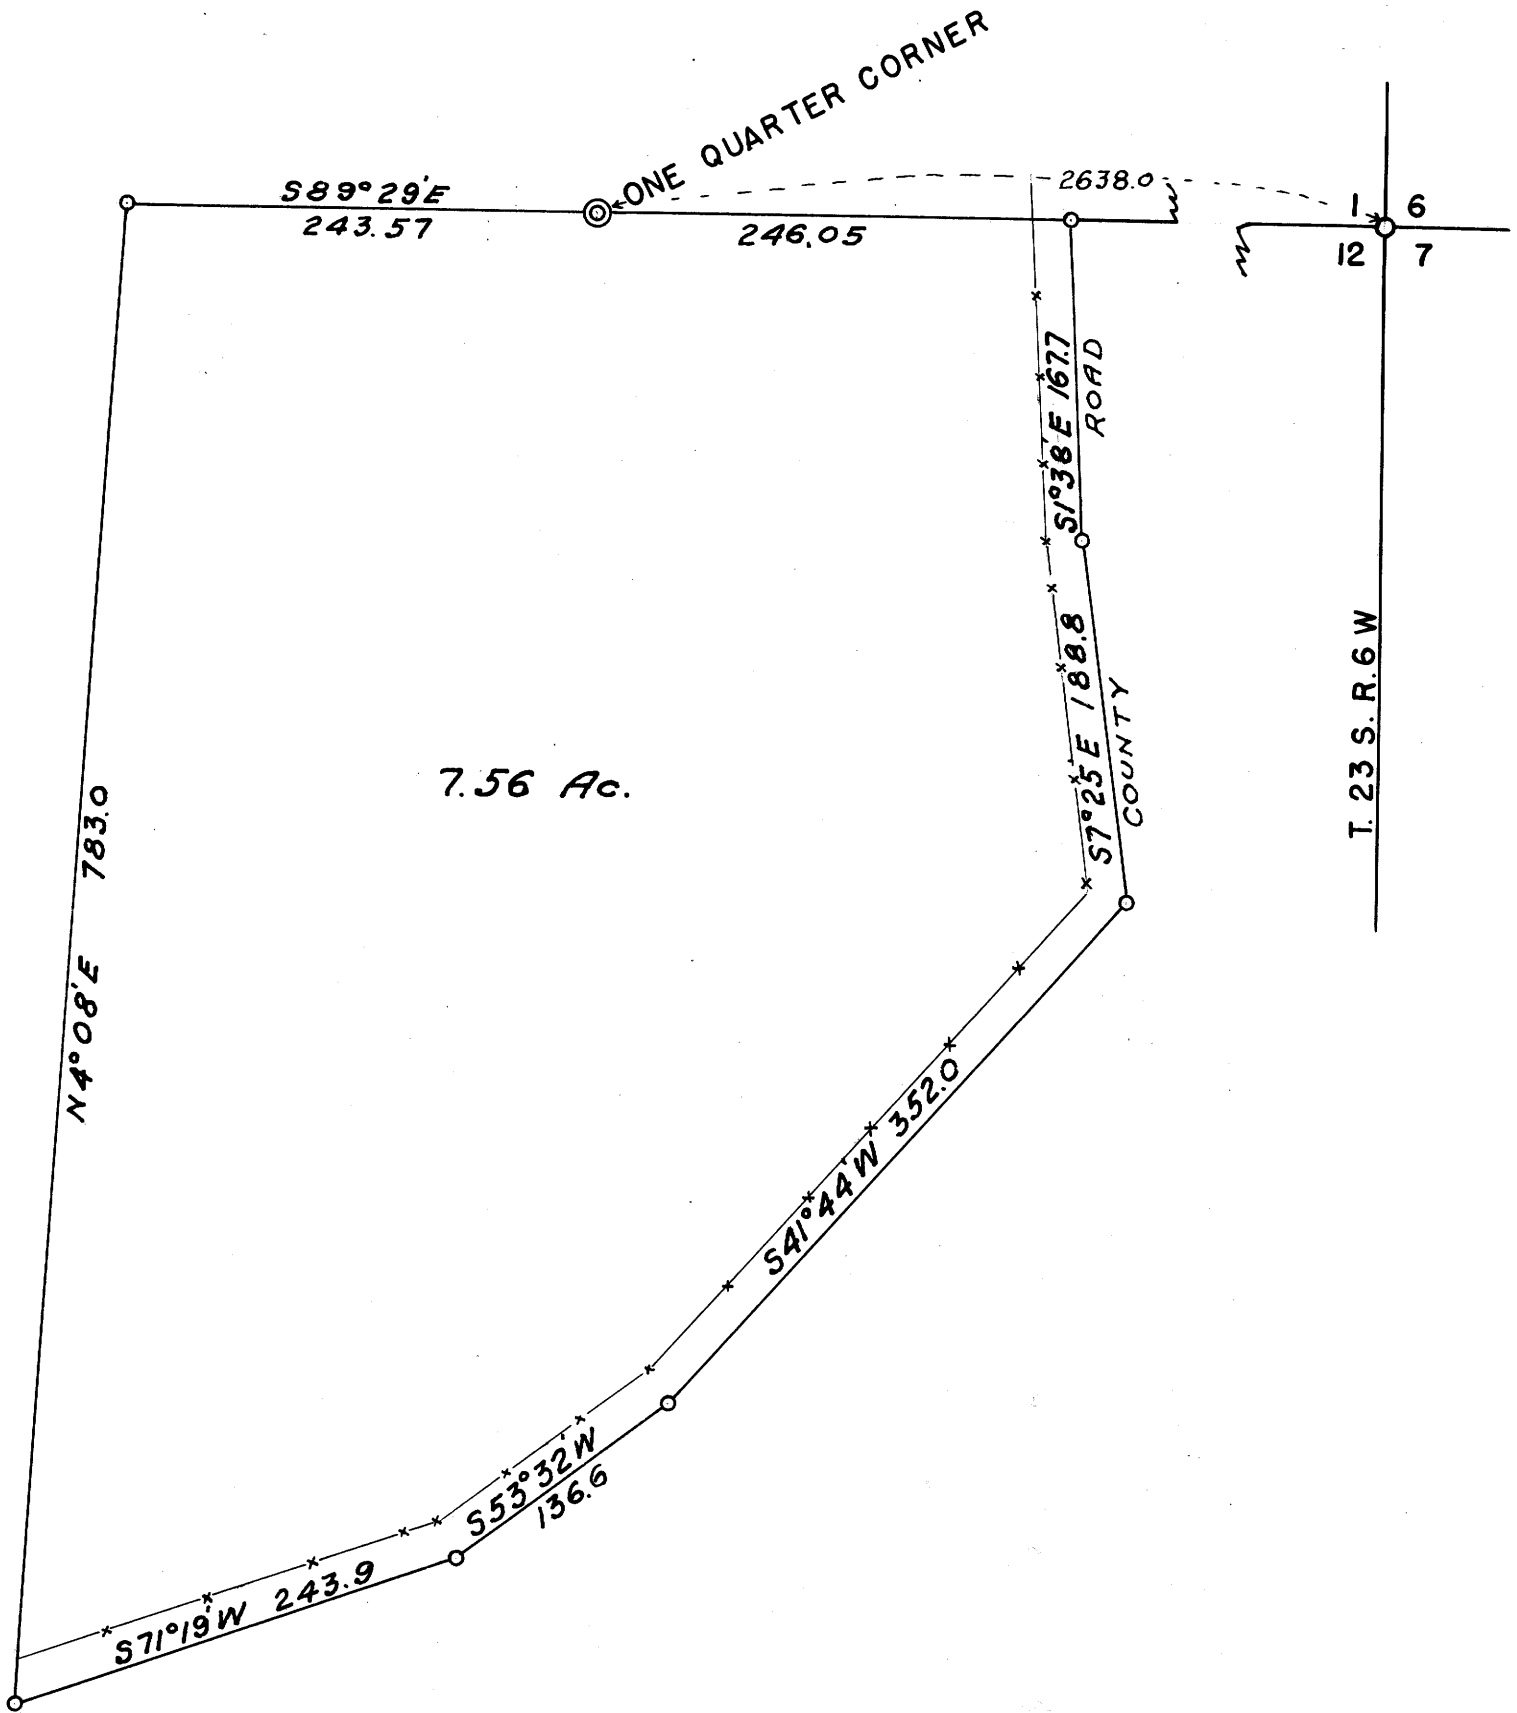


YONCALLA LUMBER COMPANY

JULY 1952

1" = 100'

FRED L. DOW

CIV. ENG.

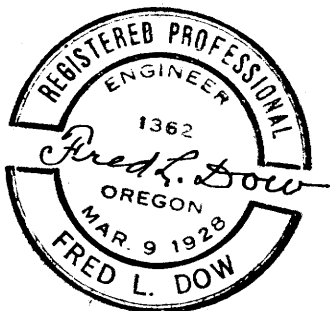

COUNTY SURVEYORS FILE DATA
DO NOT REMOVE FROM OFFICE

C.S. FILE 41/60
MAP FILE M10-75