

COUNTY SURVEYORS FILE DATA
DO NOT REMOVE FROM OFFICE



YONCALLA LUMBER COMPANY

JULY 1952

FRED L. DOW

1" = 100'

CIV. ENG.

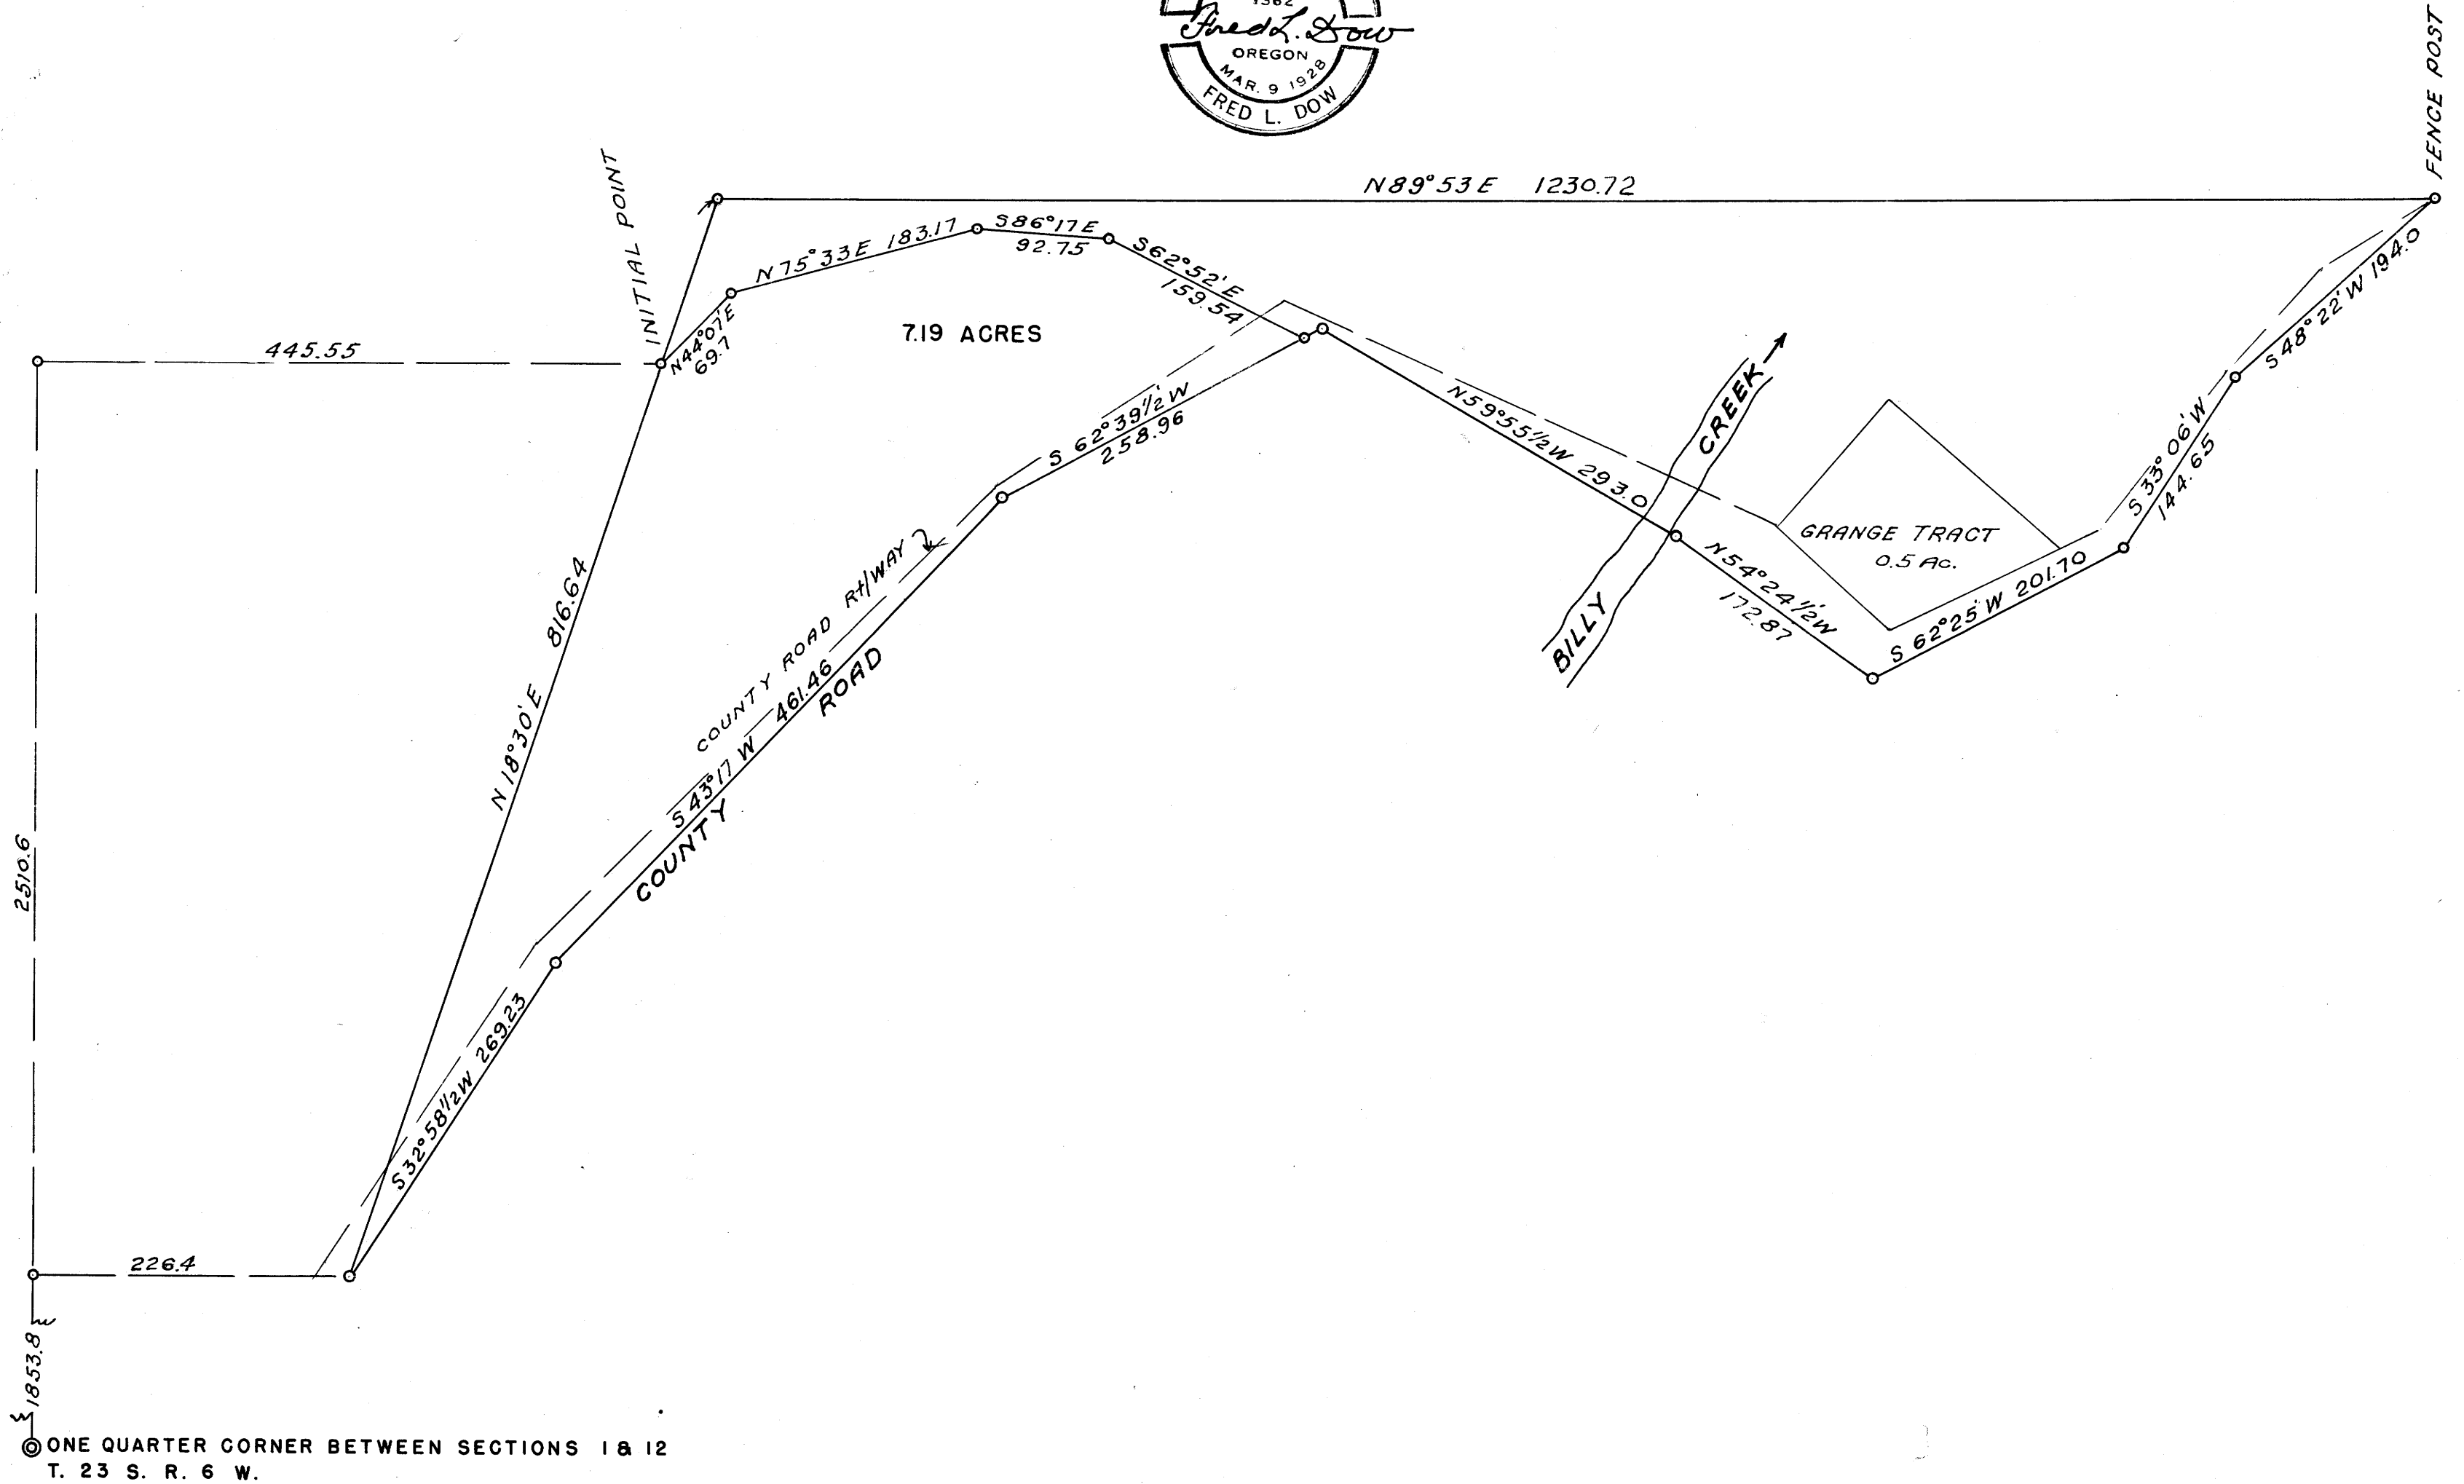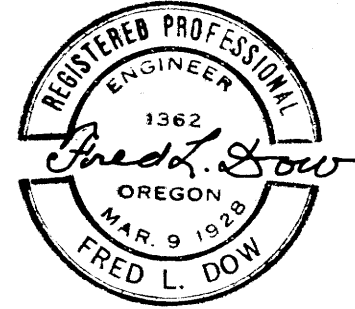

C.S. FILE NO. 41/60
MAP FILE M10-76