
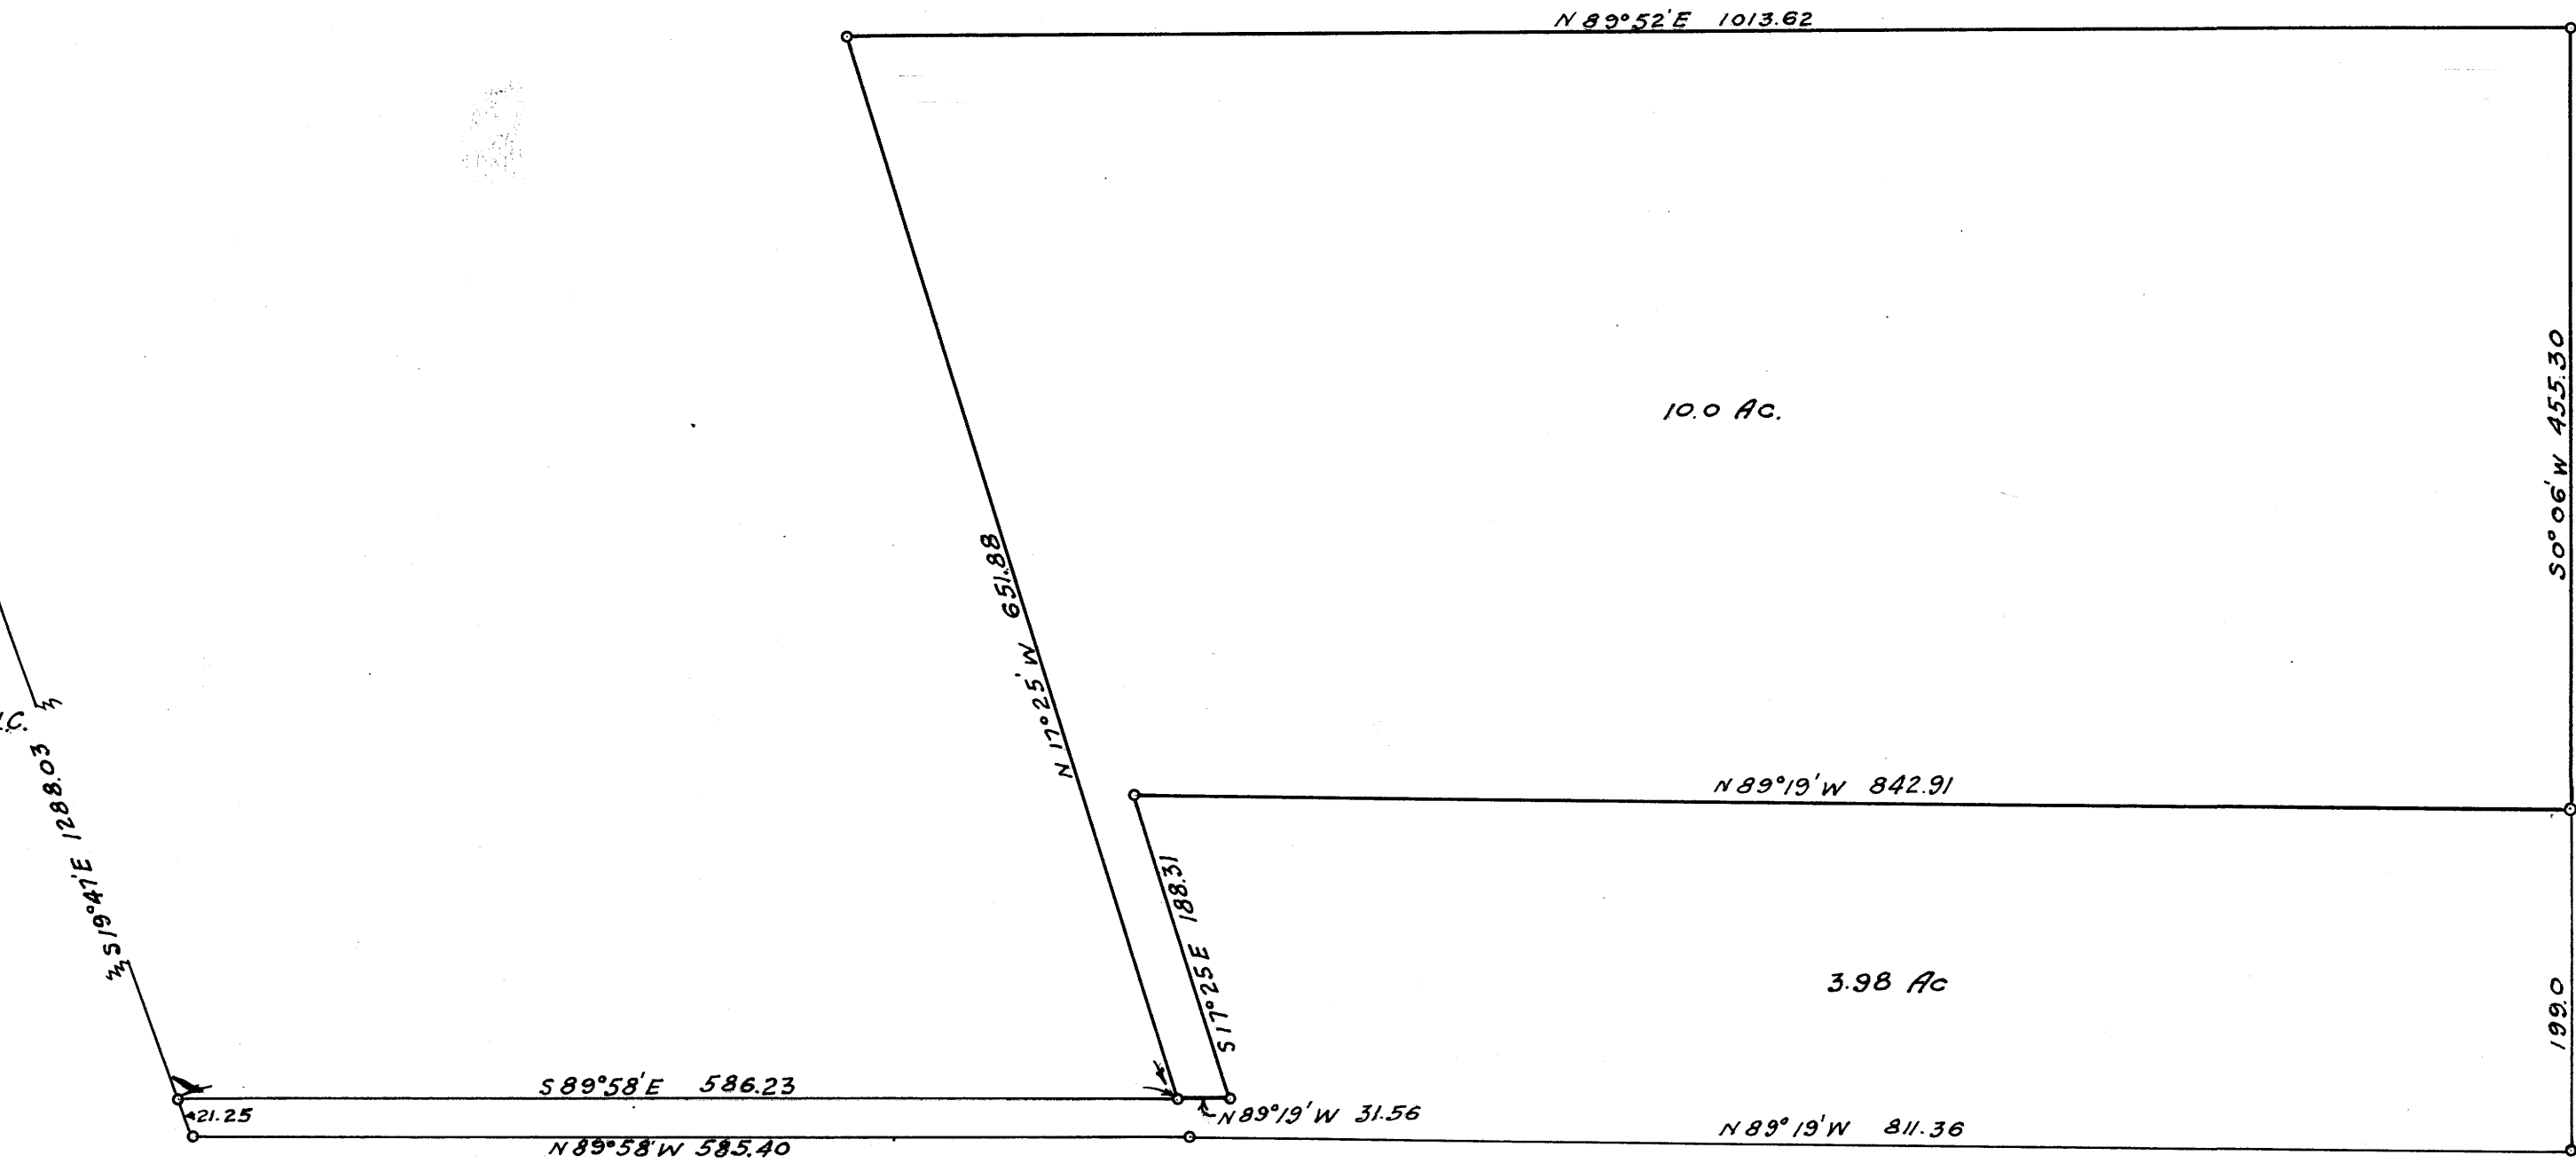
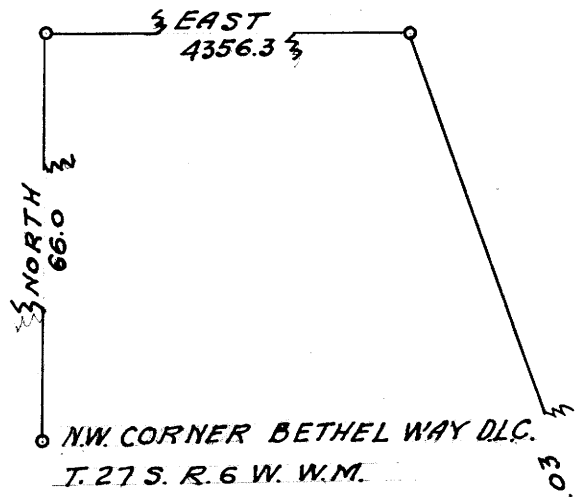


COUNTY SURVEYORS FILE DATA  
DO NOT REMOVE FROM OFFICE

ERNEST NAZELROD  
SECTION 3 T. 27 S. R. 6 W.  
SCALE 1" = 100' FRED L. DOW  
JULY 1951 SURVEYOR

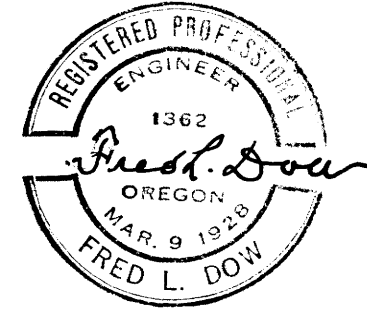

M 10-78

e.s. 10/360

M 10-78

CS FILE FOLDER

CONTAINS

MORE

INFORMATION