


NOTE: ALL BEARINGS CALCULATED FROM ANGLES TURNED IN DEFLECTION FROM MERIDIAN DETERMINED FROM BEARING OF SECTION LINE BETWEEN CORNER TO SECTIONS 9, 16 & 17, & 1/4 Sec. COR. 9-16.



OFFICE OF THE COUNTY SURVEYOR
DOUGLAS COUNTY OREGON
SURVEY FOR GATEWAY ROAD
IN SECTIONS 9-16, T26S, R3W, WM.

SURVEYED JUNE 13-14, 1949, BY
BEN B. IRVING COUNTY SURVEYOR
PLATTED BY A.R. EVANS, DEP. CO. SURVEYOR
SCALE 1" = 100'

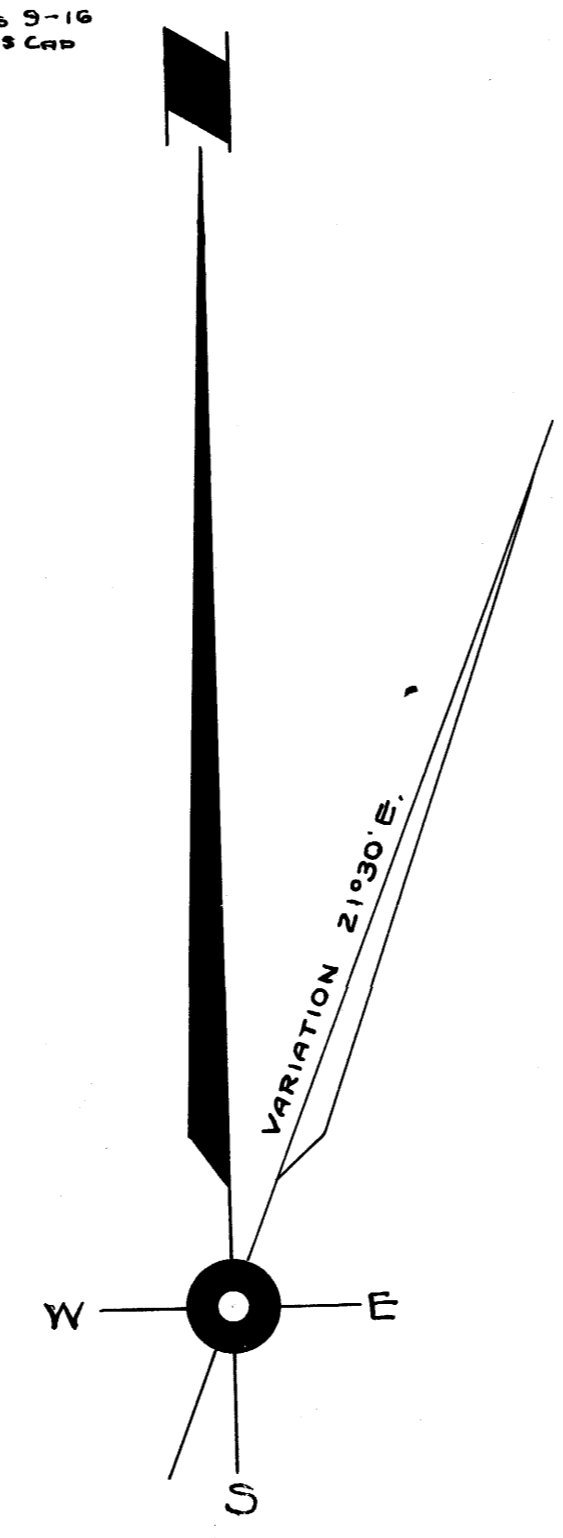