


FILED
RECEIVED

JAN 7 1958

COUNTY SURVEYOR
DOUGLAS COUNTY, ORE.

SURVEY OF SECTION 24, T 25 S, R 1 W, W.M.

SURVEYED FOR: U. S. PLYWOOD CORP.
SURVEYED BY: G. R. LECKLIDER — ENGR. DECEMBER, 1958
SCALE: 1" = 500'

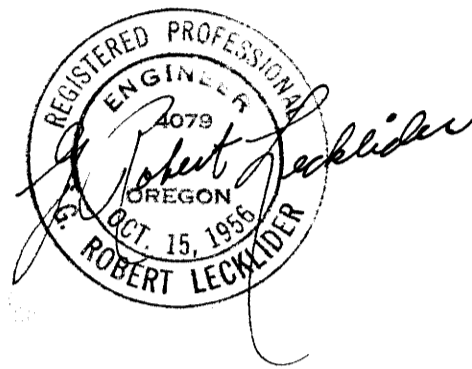

SEC. COR. 13, 14, 23 & 24
FD.: COR. STONE
12" MADRONE - S 5° W - 7.9'
SET: 26" Fir - N 77° E - 27.0'
36" Fir - N 18° W - 15.7'
26" Fir - S 66° E - 30.0'

1/4 COR. SEC. 13 & 24
FD.: 50" Fir at cor.
18" Fir - S 50° W - 44.2'
SET: 48" Fir - S 38 1/2° W - 18.8'
50" Fir - N 38 1/2° E - 35.8'
N 89° 11' E - 2737.0' (2653.2')

SEC. COR. 13 & 24
FD.: COR. STONE
60" Fir - N 74° W - 29'
42" W. Fir - S 19° W - 7.9'

N 1/16 COR. SEC. 23 & 24
SET: 5/8" X 36" ROD FOR COR.
14" Fir - N 60° E - 34.8'
10" Fir - N 30° W - 29.1'

C-N-C 1/16 COR. SEC. 24
SET: 5/8" X 36" ROD FOR COR.
14" Fir - N 34° W - 35.7'
14" Fir - S 72° W - 30.2'

CC SEC. 18 & 19
FD.: BRASS CAP
8" Fir - N 51° E - 30.4'
8" Fir - S 40° E - 27.7'

1/4 COR. SEC. 23 & 24
FD.: COR. STONE
32" Fir - N 53° E - 32.3'
16" Fir - S 14° W - 16.5'

1/4 COR. SEC. 24
FD.: COR. STONE
10" Madrone - N 64° W - 4.6'
36" Fir - N 45° W - 66'

CC 1/4 COR. SEC. 19
FD.: BRASS CAP
30" Fir - N 86° E - 77.9'
24" Fir - S 72° E - 79.2'

S 1/16 COR. SEC. 24
SET: 5/8" X 36" ROD FOR COR.
10" Fir - N 39° W - 14.1'
8" Fir - S 78° W - 12.2'

SEC. COR. 23, 24, 25 & 26
FD.: COR. STONE & 5/8" ROD
10" Fir - N 35° E - 12.5'
5" Hem. - N 56° W - 18.8'
5" Hem. - S 15° W - 9.9'
6" Hem. - N 61° W - 14.5'

SEC. COR. 24 & 25
FD.: BRASS CAP
60" Fir - N 18° W - 23.8' (Down)
40" W. Fir - S 18° W - 71.9'

1/4 COR. SEC. 24 & 25
COR. COMPUTED
ORIG. COR. NOT FD.

