


CORNER DESCRIPTIONS	
1	3/4" PIPE
2	1/2" BOLT
3	3/4" BOLT
4	1 1/2" PIPE
5	1" PIPE
6	1 1/2" PIPE
7	3/4" PIPE
8	3/4" PIPE
9	PIPE
10	PIPE
11	3/4" PIPE SE Cor. G.A. BURT DLC 40 Orig. B.T. 40" Oak N45°E 105.1ks. New B.T. 30" B. Oak N66°W 131 ft. Cor. Center County Road & C" under road surface.

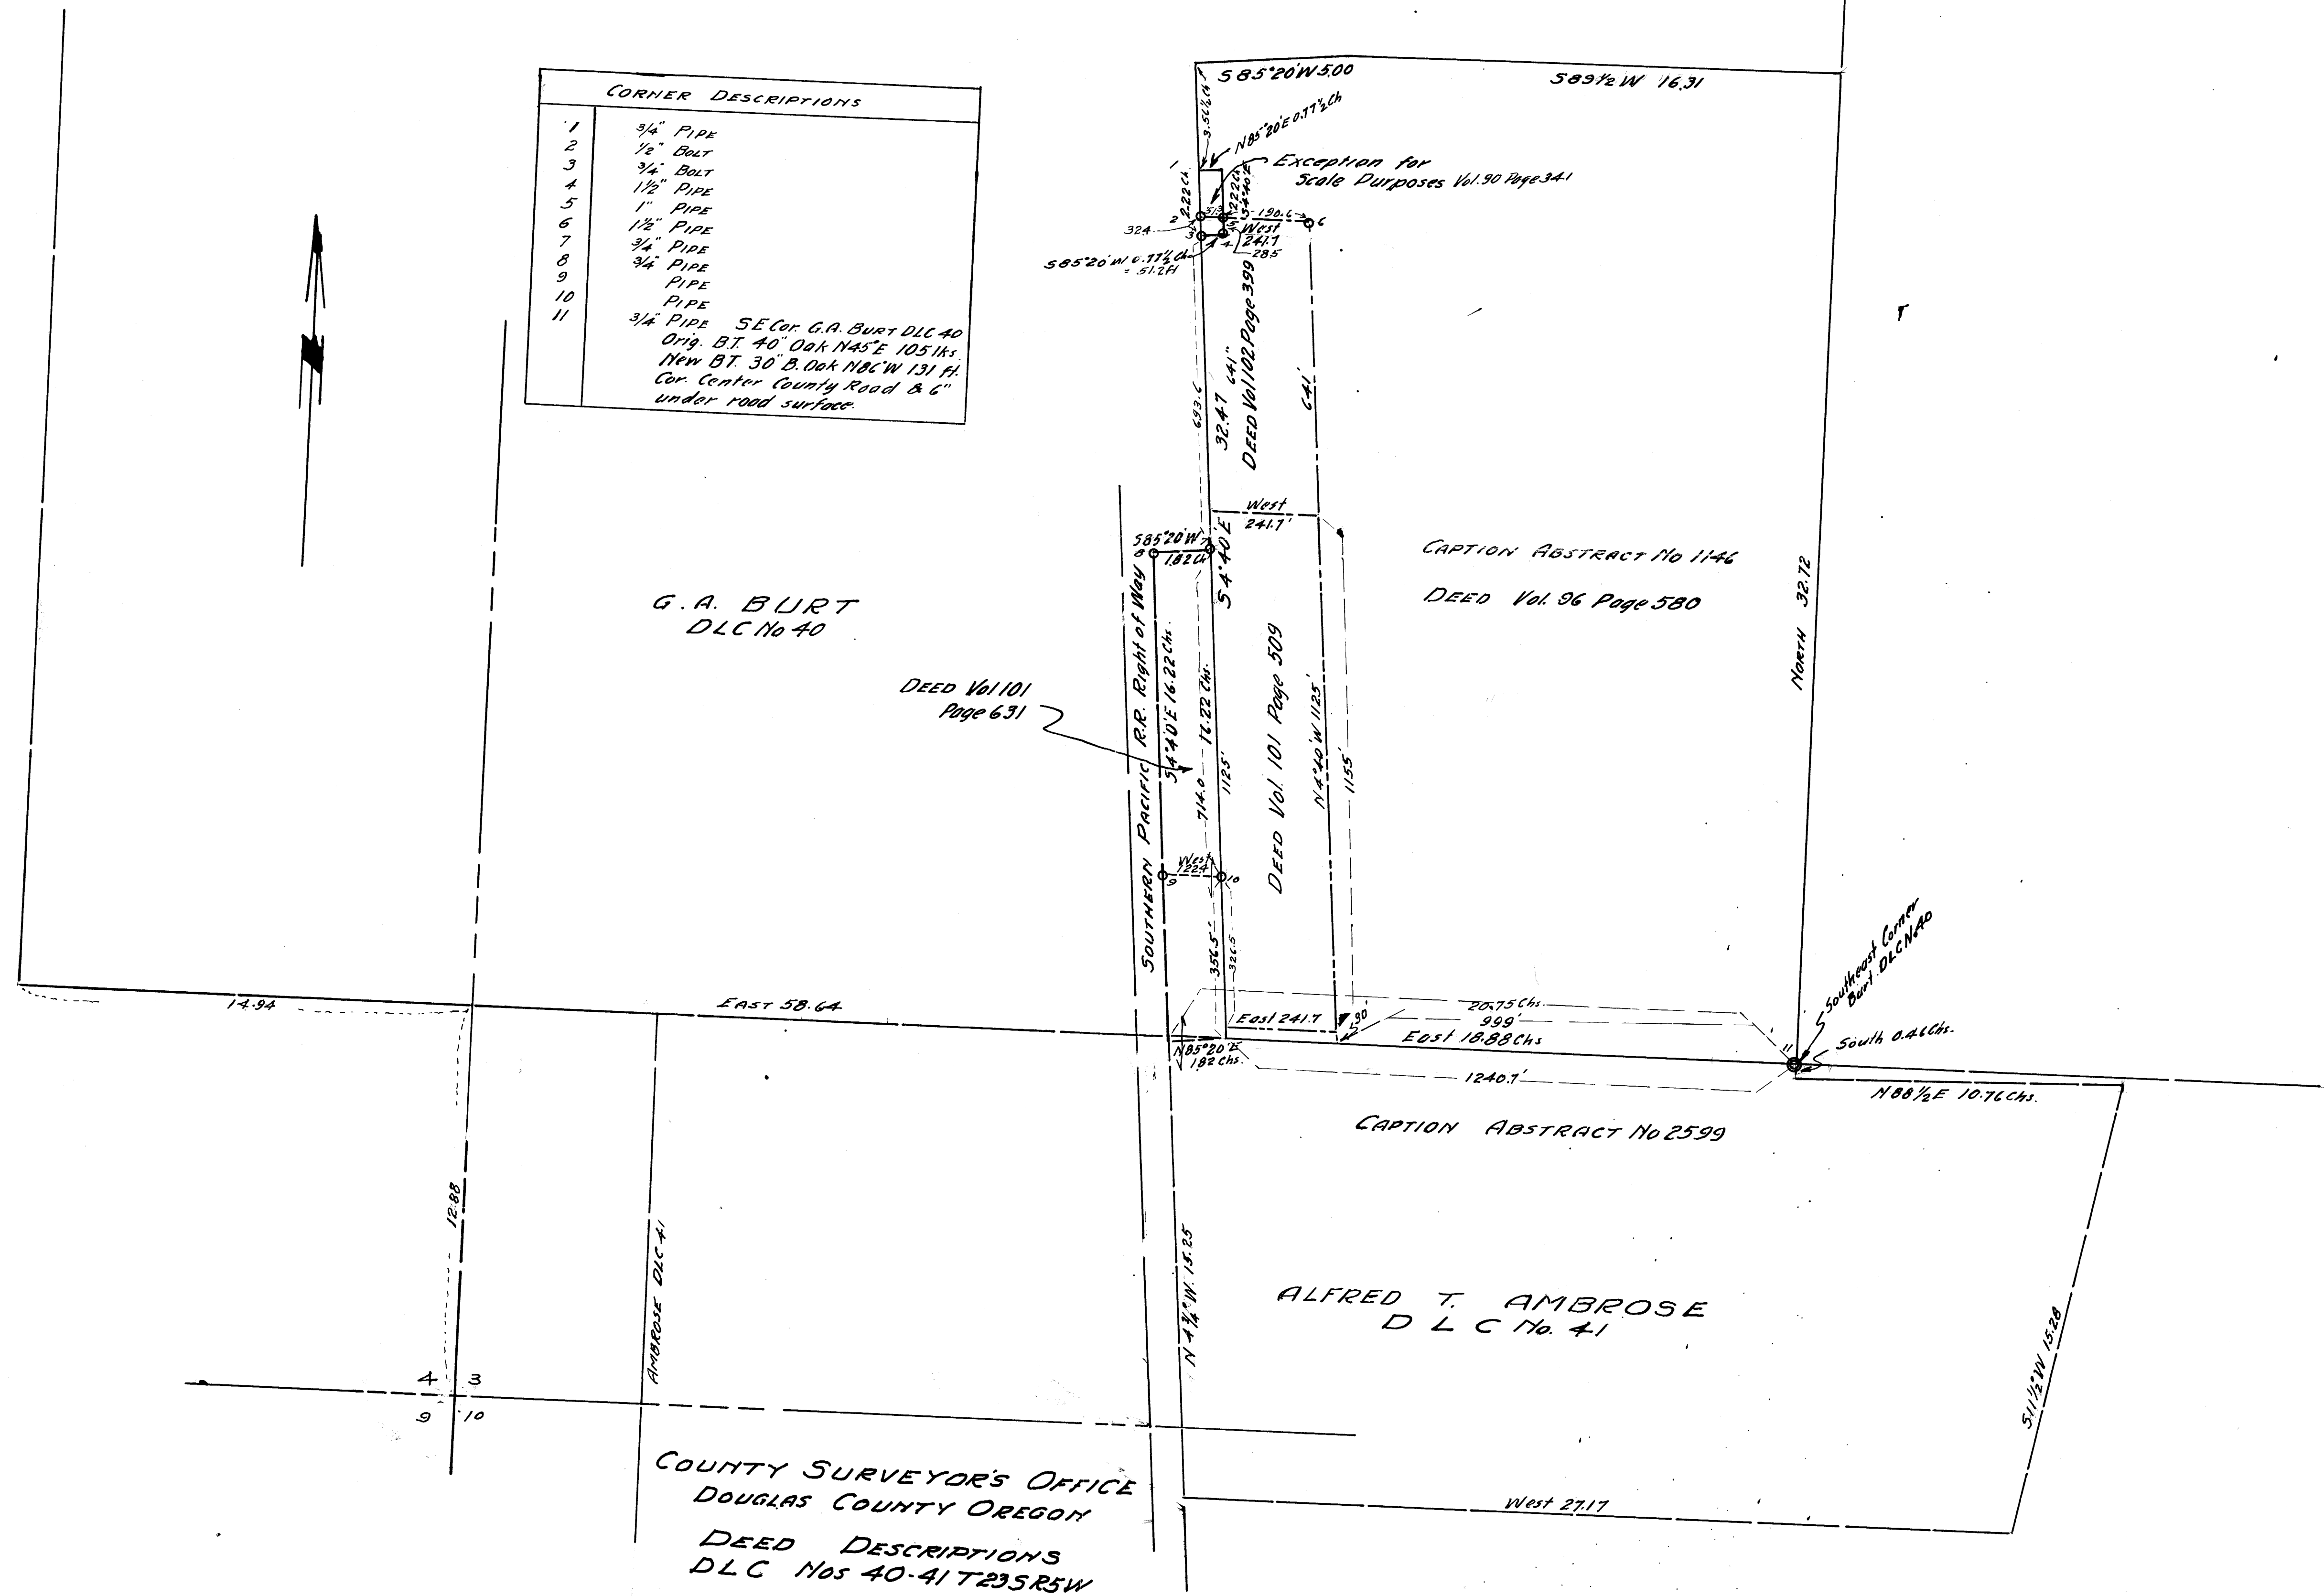

COUNTY SURVEYOR'S OFFICE
DOUGLAS COUNTY OREGON
DEED DESCRIPTIONS
DLC Nos 40-41 T235R5W

PLOTTED BY
BEN. B. IRVING County Surveyor
March 19 1946
SCALE 1" = 200'