




DETAIL AT SW CORNER

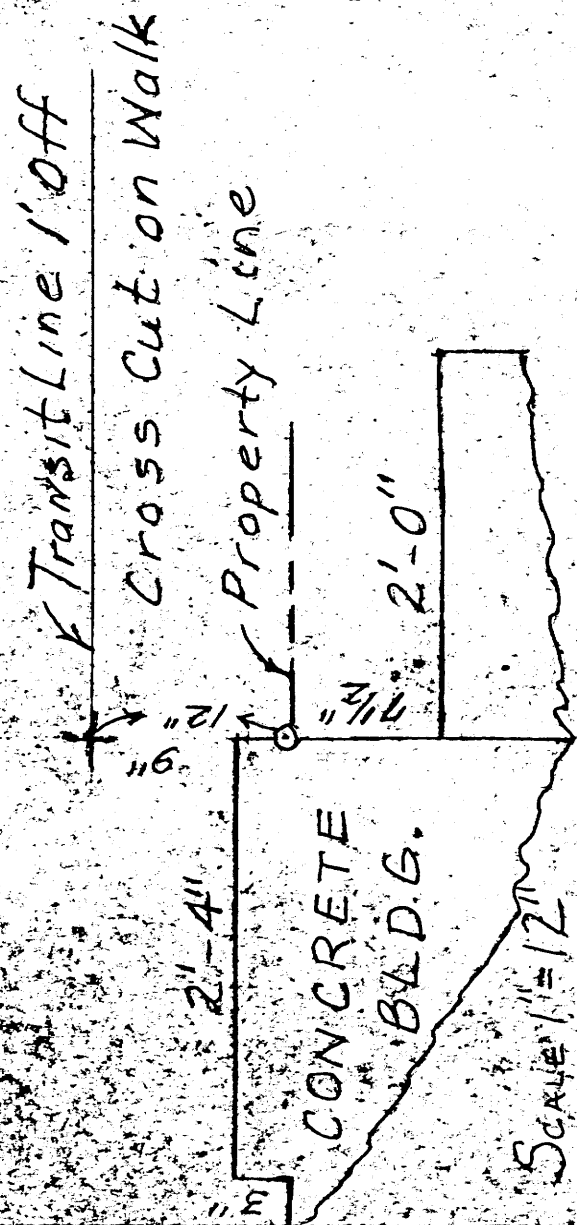

SE STEPHENS ST

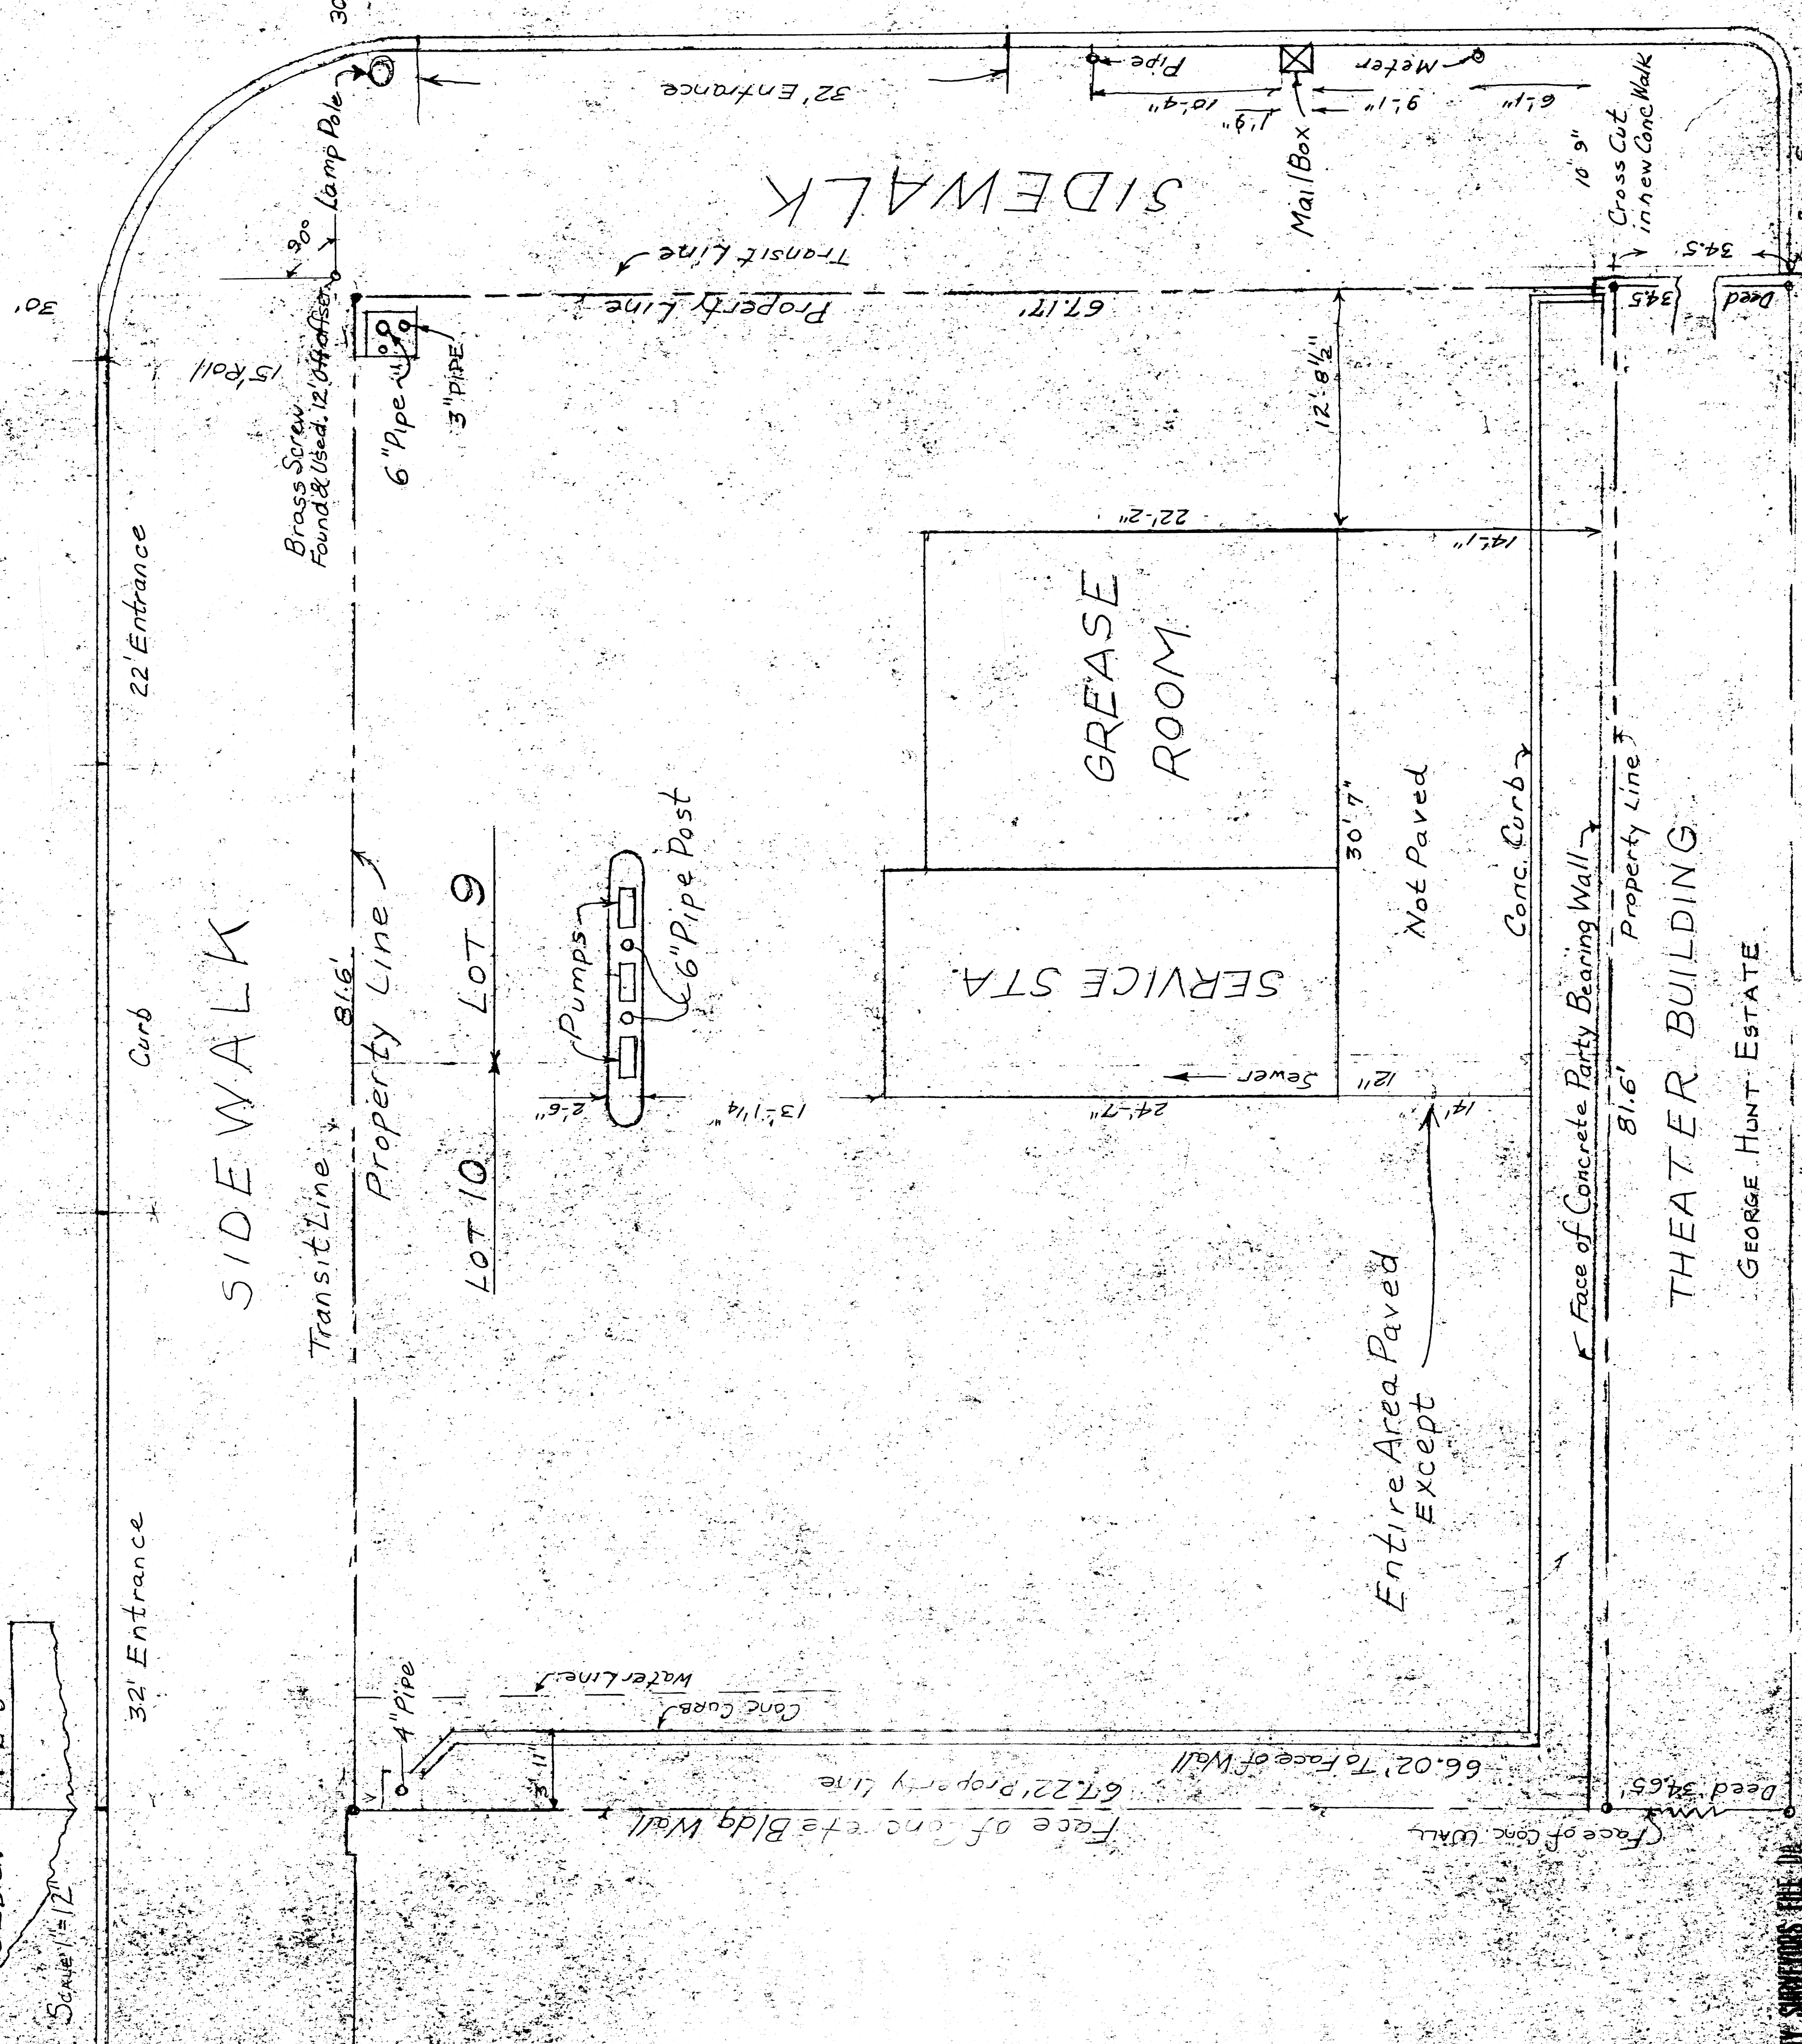

DETAIL AT
THEATER BLDG.
SCALE 1"=12"

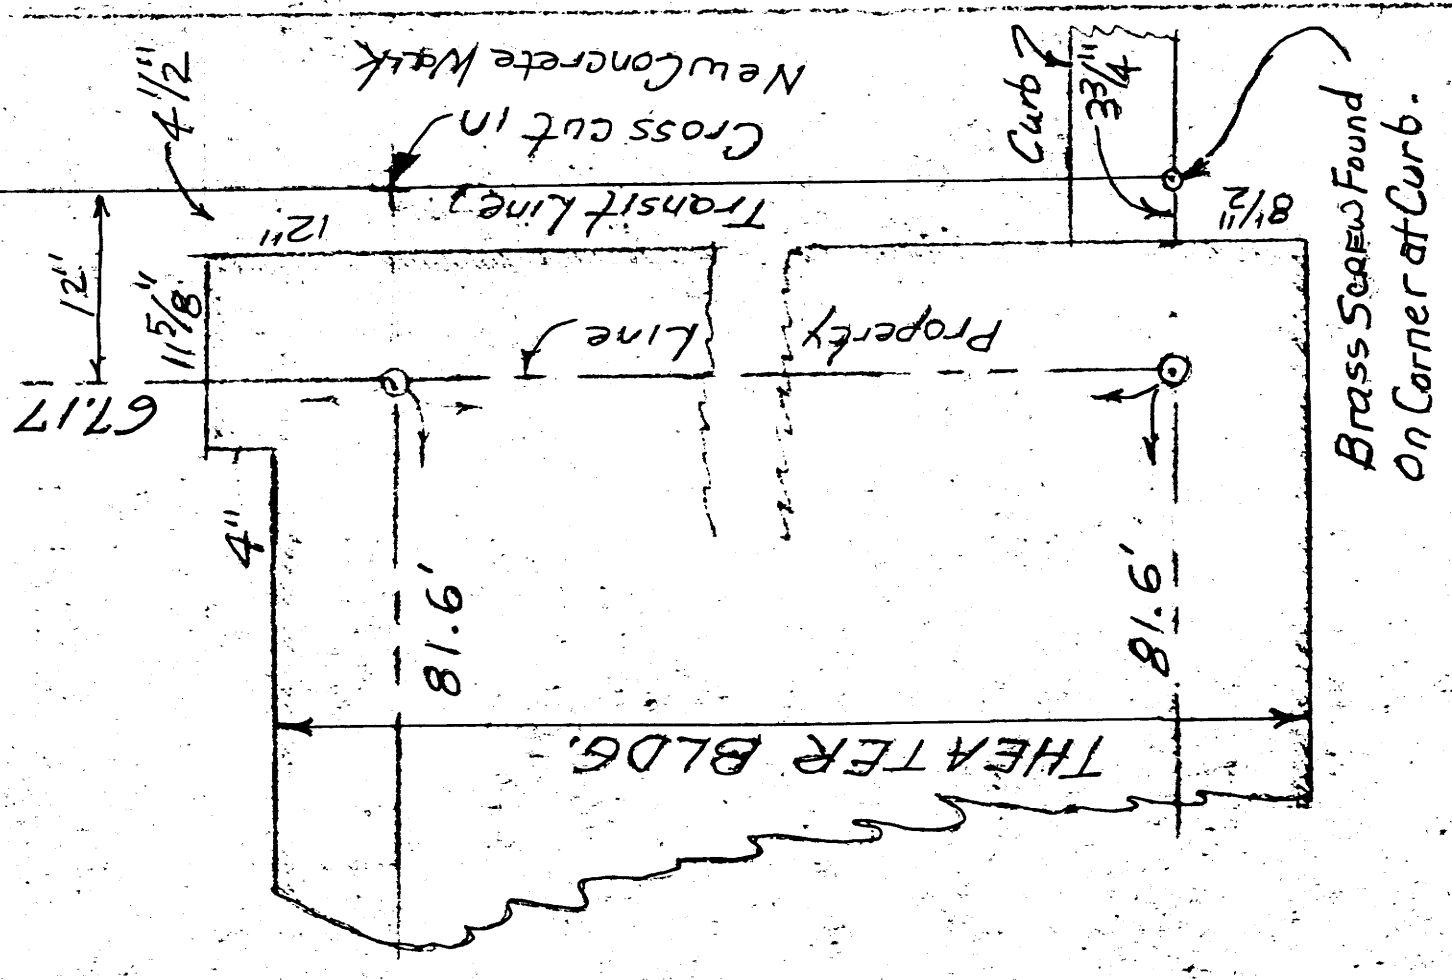

TIME OIL CO PARCEL
LOTS 9 & 10 BL. 50 RAIL FOUNDRY
ROSEBURG ORE.

SURVEYED BY
JAMES R. DAUGHERTY
CIVIL-SANITARY ENGINEER
ROSEBURG ORE.
JUNE 1959.
Scale 1"=5'