


PART OF PROPERTY OF  
**CHARLES MATTHEWS**  
Being 3 tracts in SEC 34-T27S-R7W W.M. Douglas Co. Ore.  
February 1951 Scale 1" = 100'

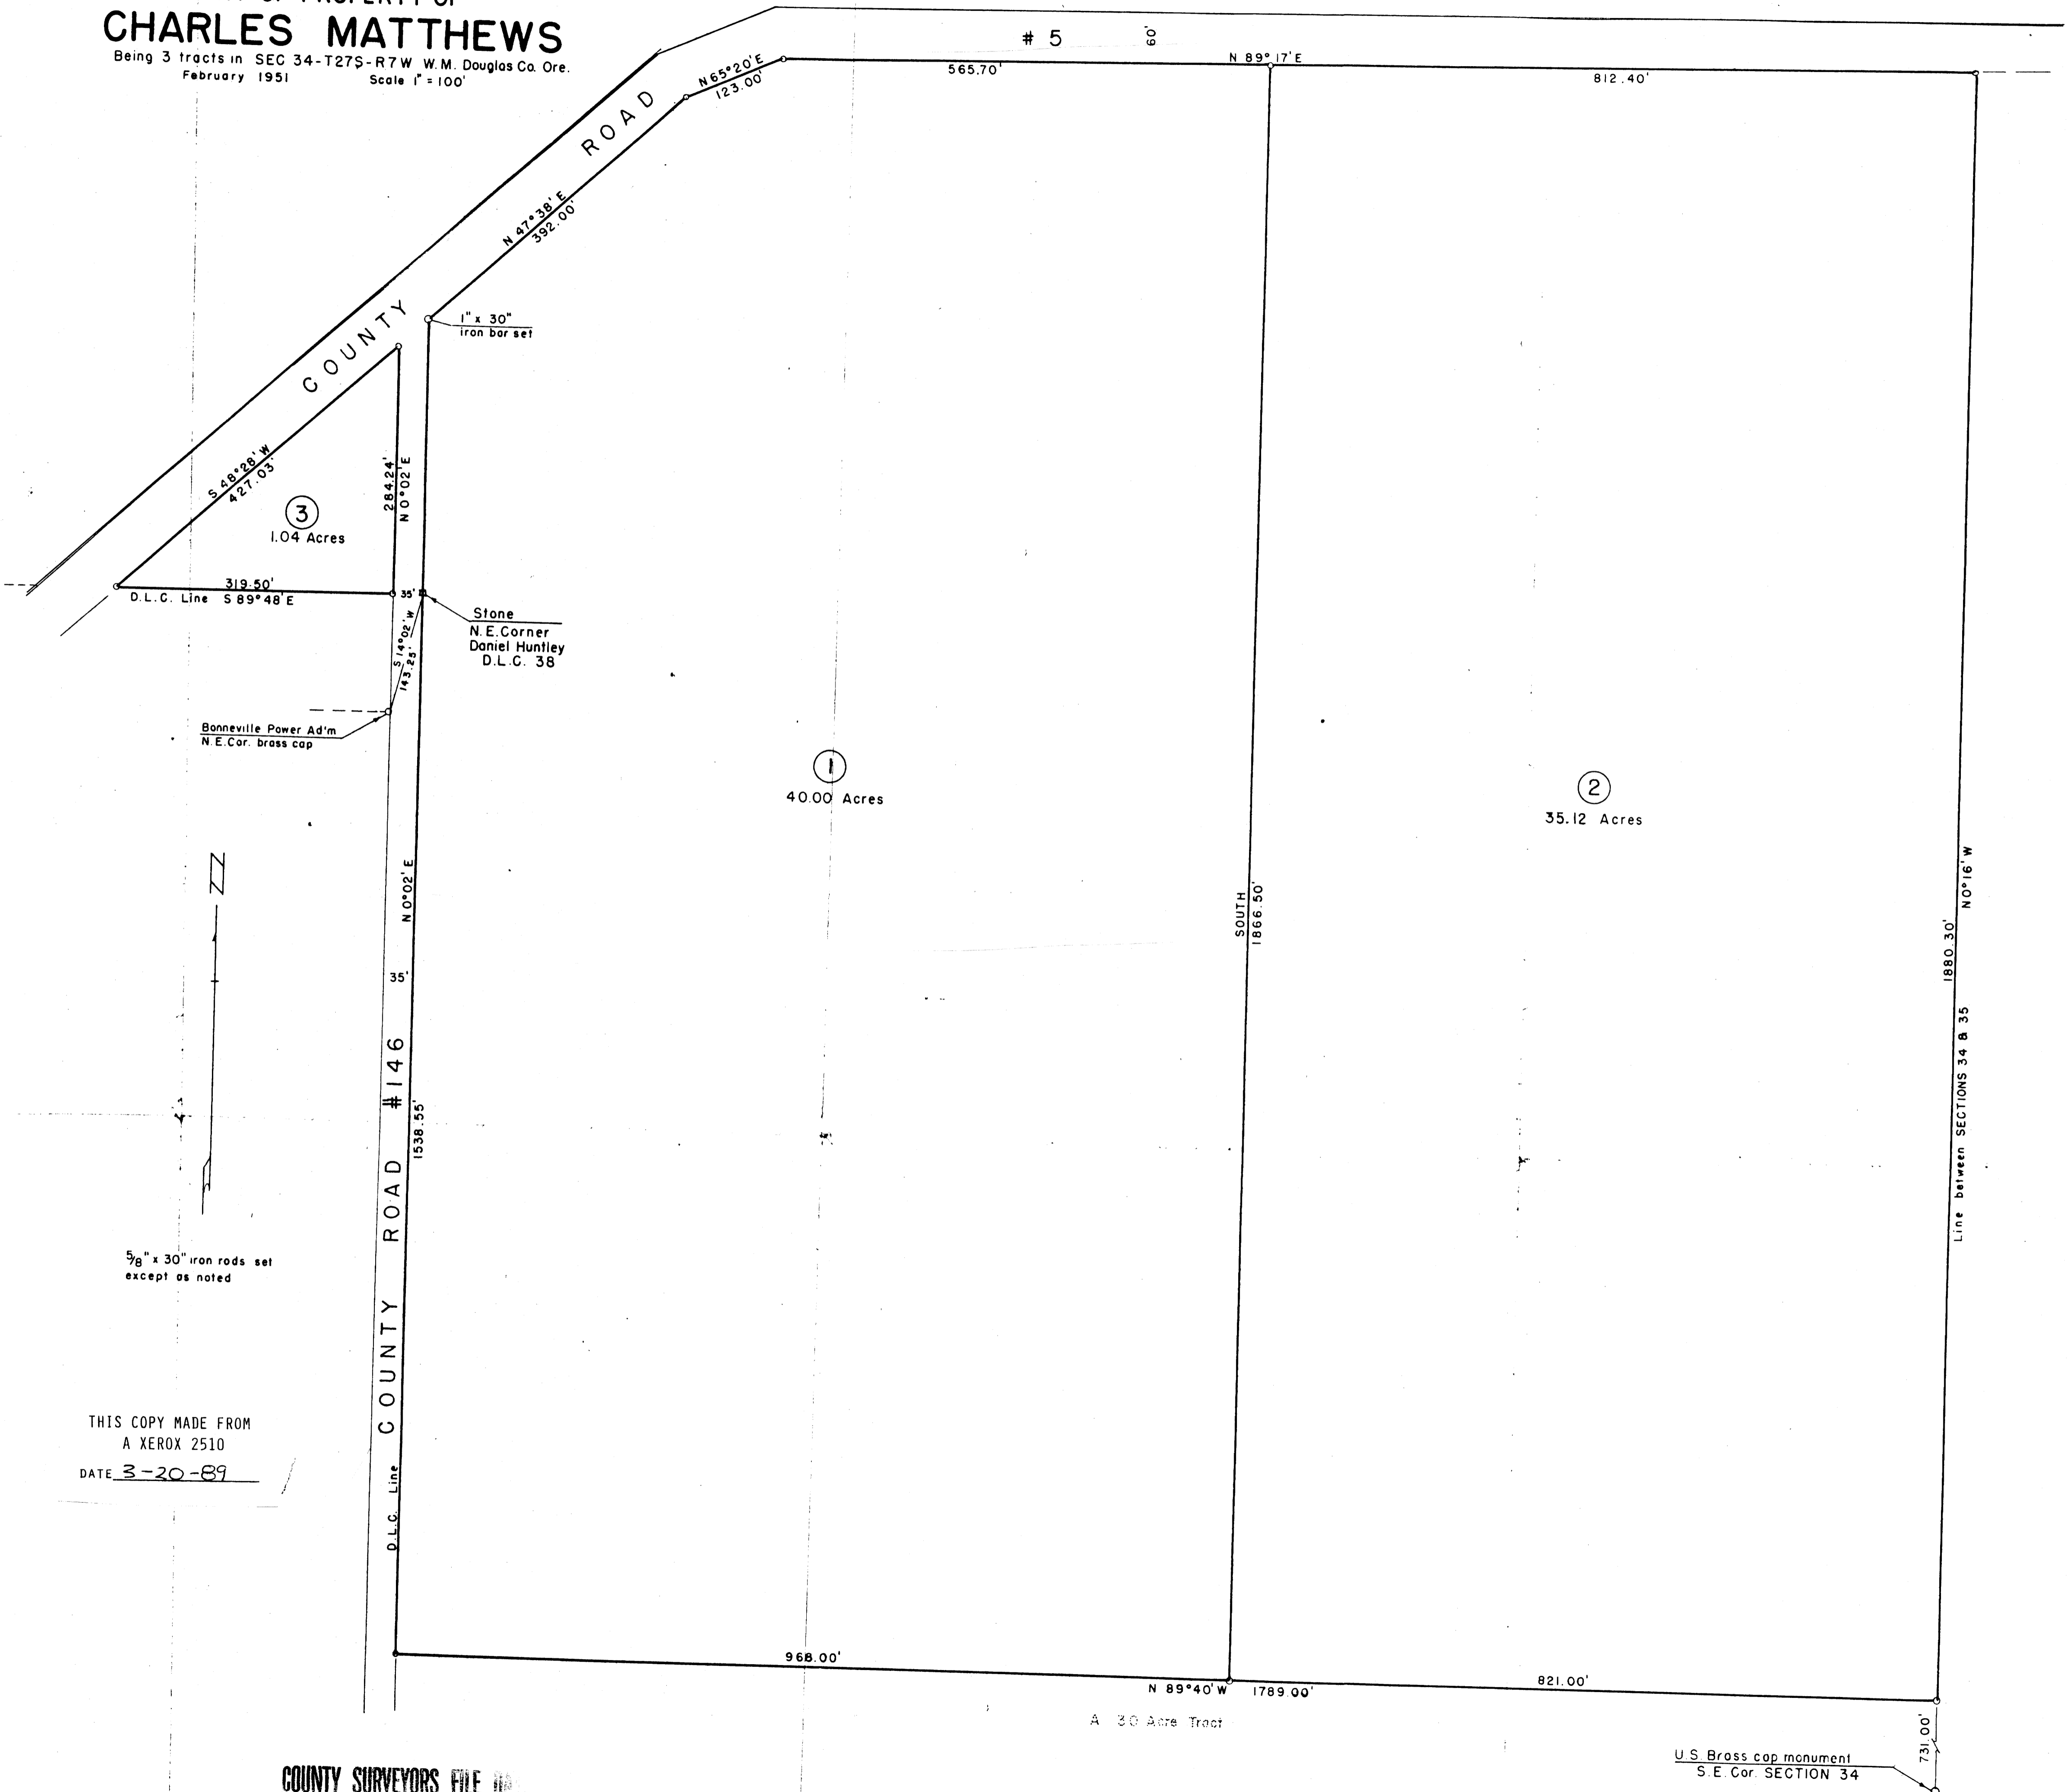

THIS COPY MADE FROM  
A XEROX 2510  
DATE 3-20-89