


**SURVEY TO SET PROPERTY CORNERS  
YOUNGS BAY LUMBER COMPANY  
IN KINNEYS IMPROVED PLAT; FIRST  
ADDITION OF BROOKSIDE TO ROSEBURG  
4 SECS 17-18-19-20, T27S, R5W, W.M.  
DOUGLAS CO. OREGON**

GRANT AND EVANS, ENGINEERS  
ROSEBURG OREGON  
SURVEYED - JUL - AUG - 33 - SCALE 1"=200'

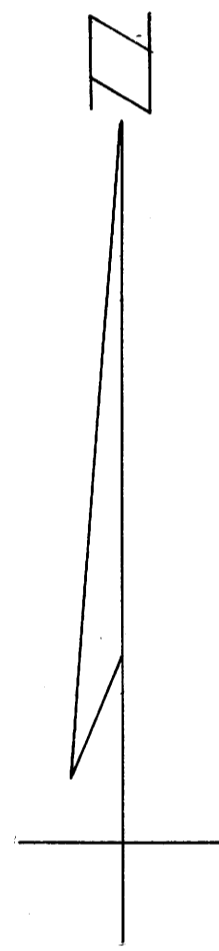

● INDICATES 1/2" IRON ROD SET.

○ INDICATES 3/4" IRON ROD SET  
UNLESS OTHERWISE NOTED

