


THIS COPY MADE FROM
A XEROX 2510
DATE 3-17-89

M 11-73

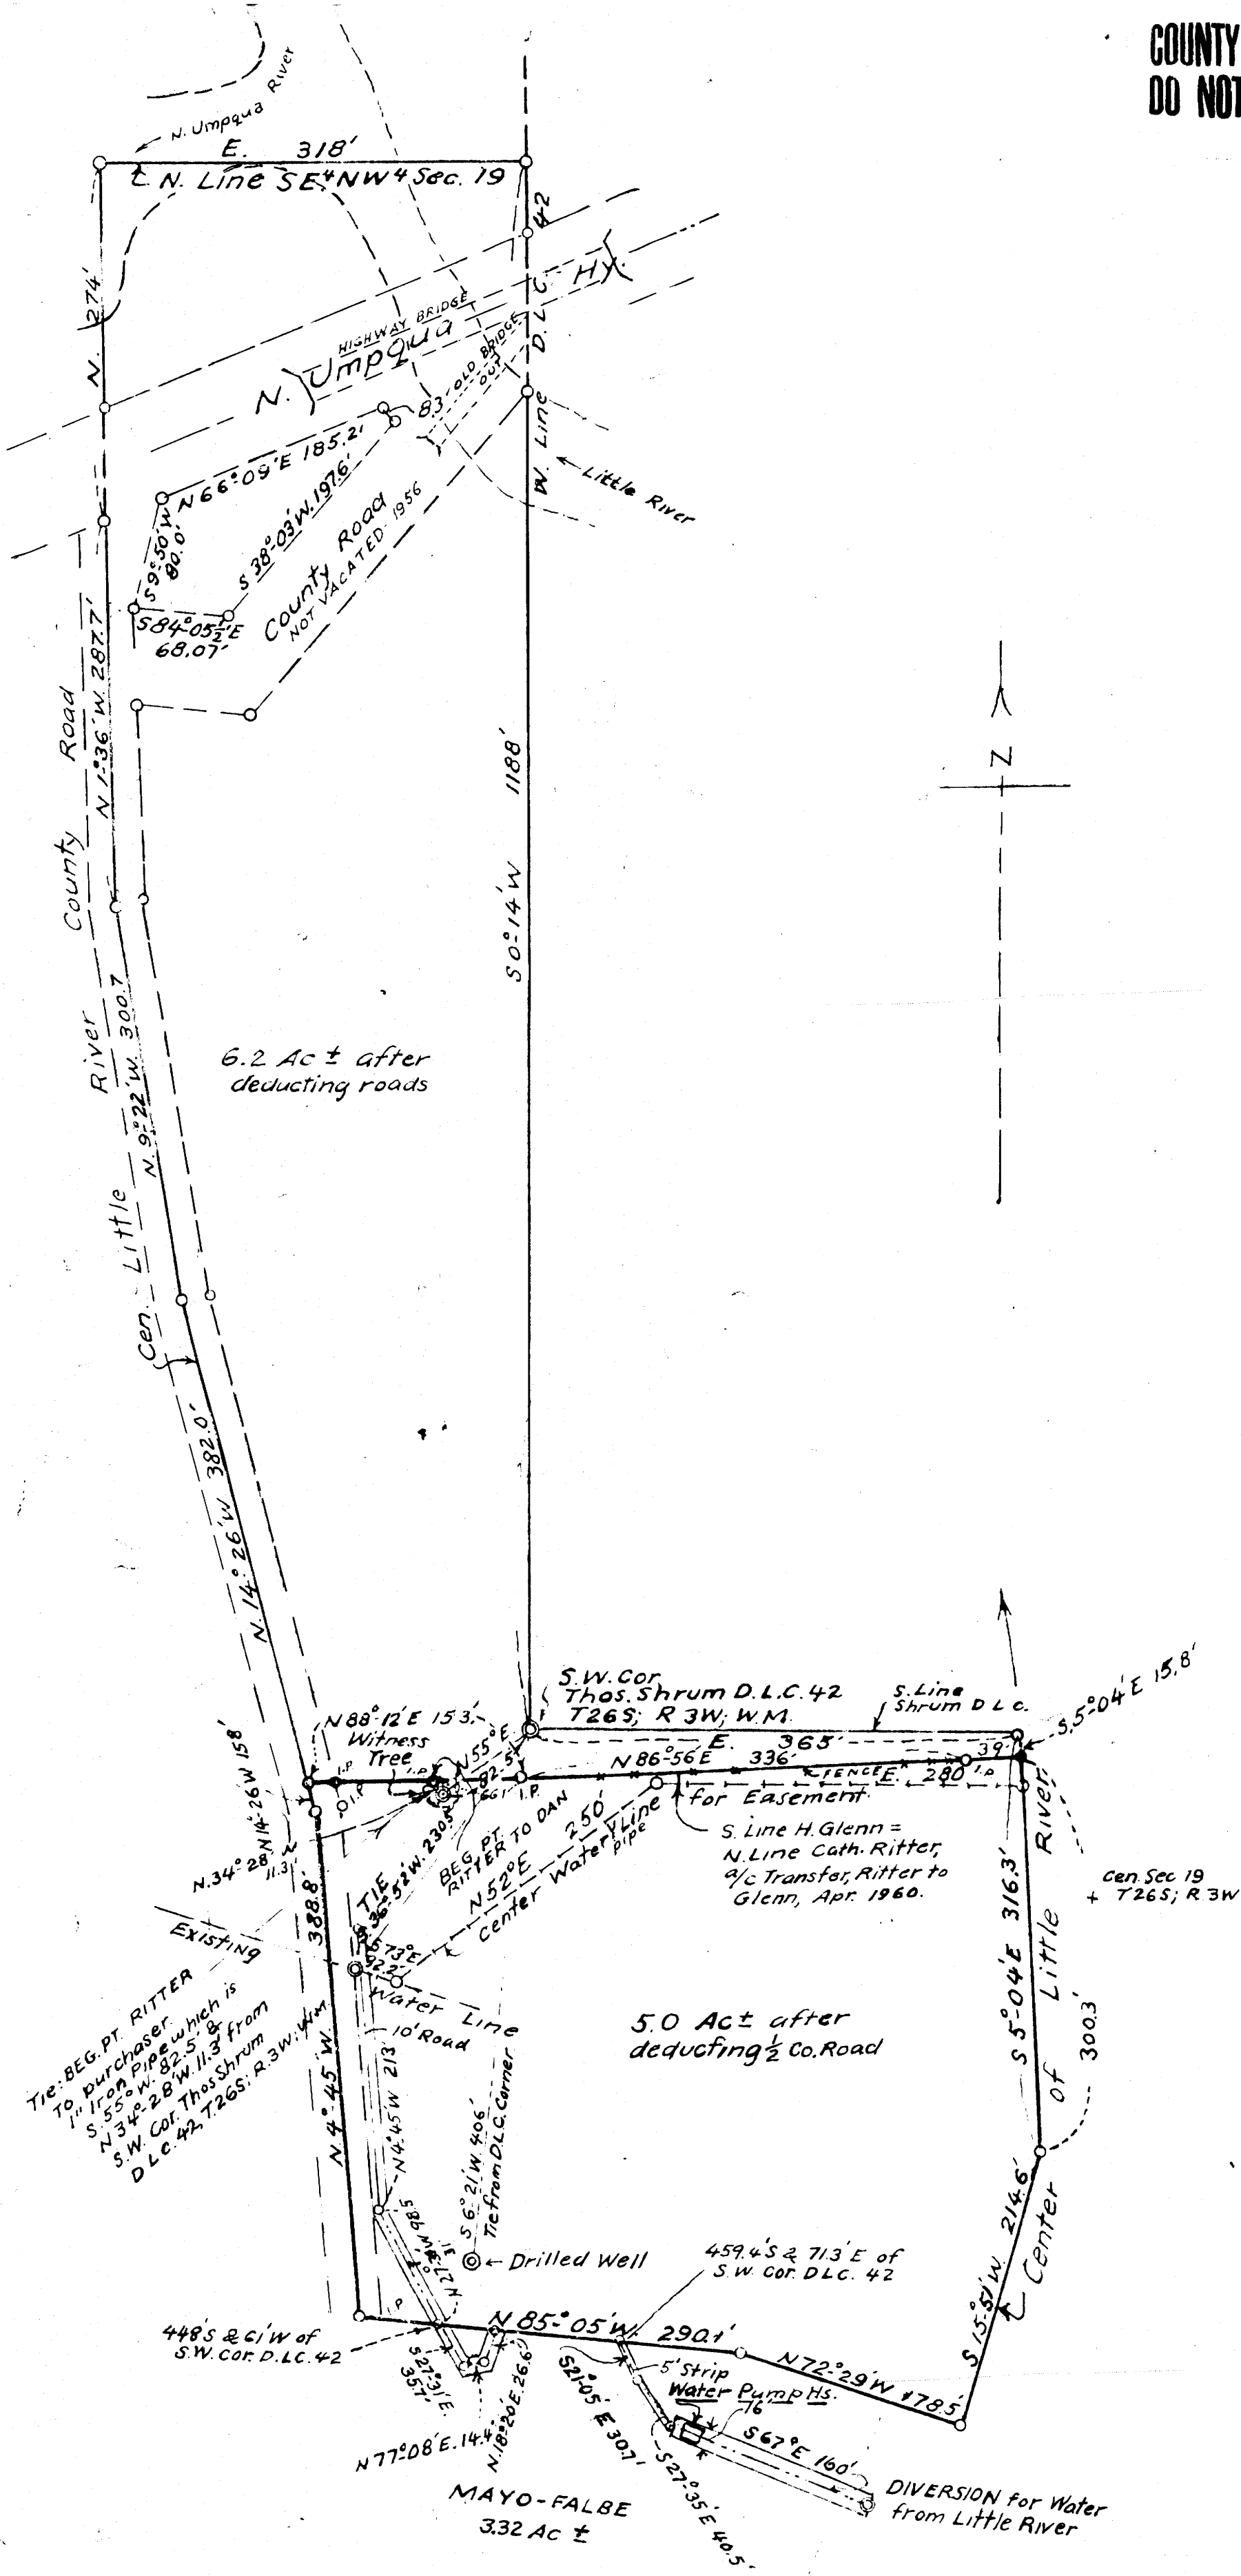

THIS COPY MADE FROM
A XEROX 2510
DATE 3-17-89

FILED
RECEIVED
OCT 24 1960
COUNTY SURVEYOR

Revised Apr. 1960

88

WALLEN TO RITTER
PORTION OF WALLEN RANCH, GLIDE, ORE
BETWEEN LITTLE RIVER ROAD & CENTER OF
LITTLE RIVER & THE THOS. SHRUM D.L.C. 42 IN
SEC. 19, T.26S, R.3W, W.M., DOUGLAS COUNTY
MAR 1956
1"=100 FT.

Arthur Boyer