


COUNTY SURVEYORS FILE  
DO NOT REMOVE FROM OFFICE

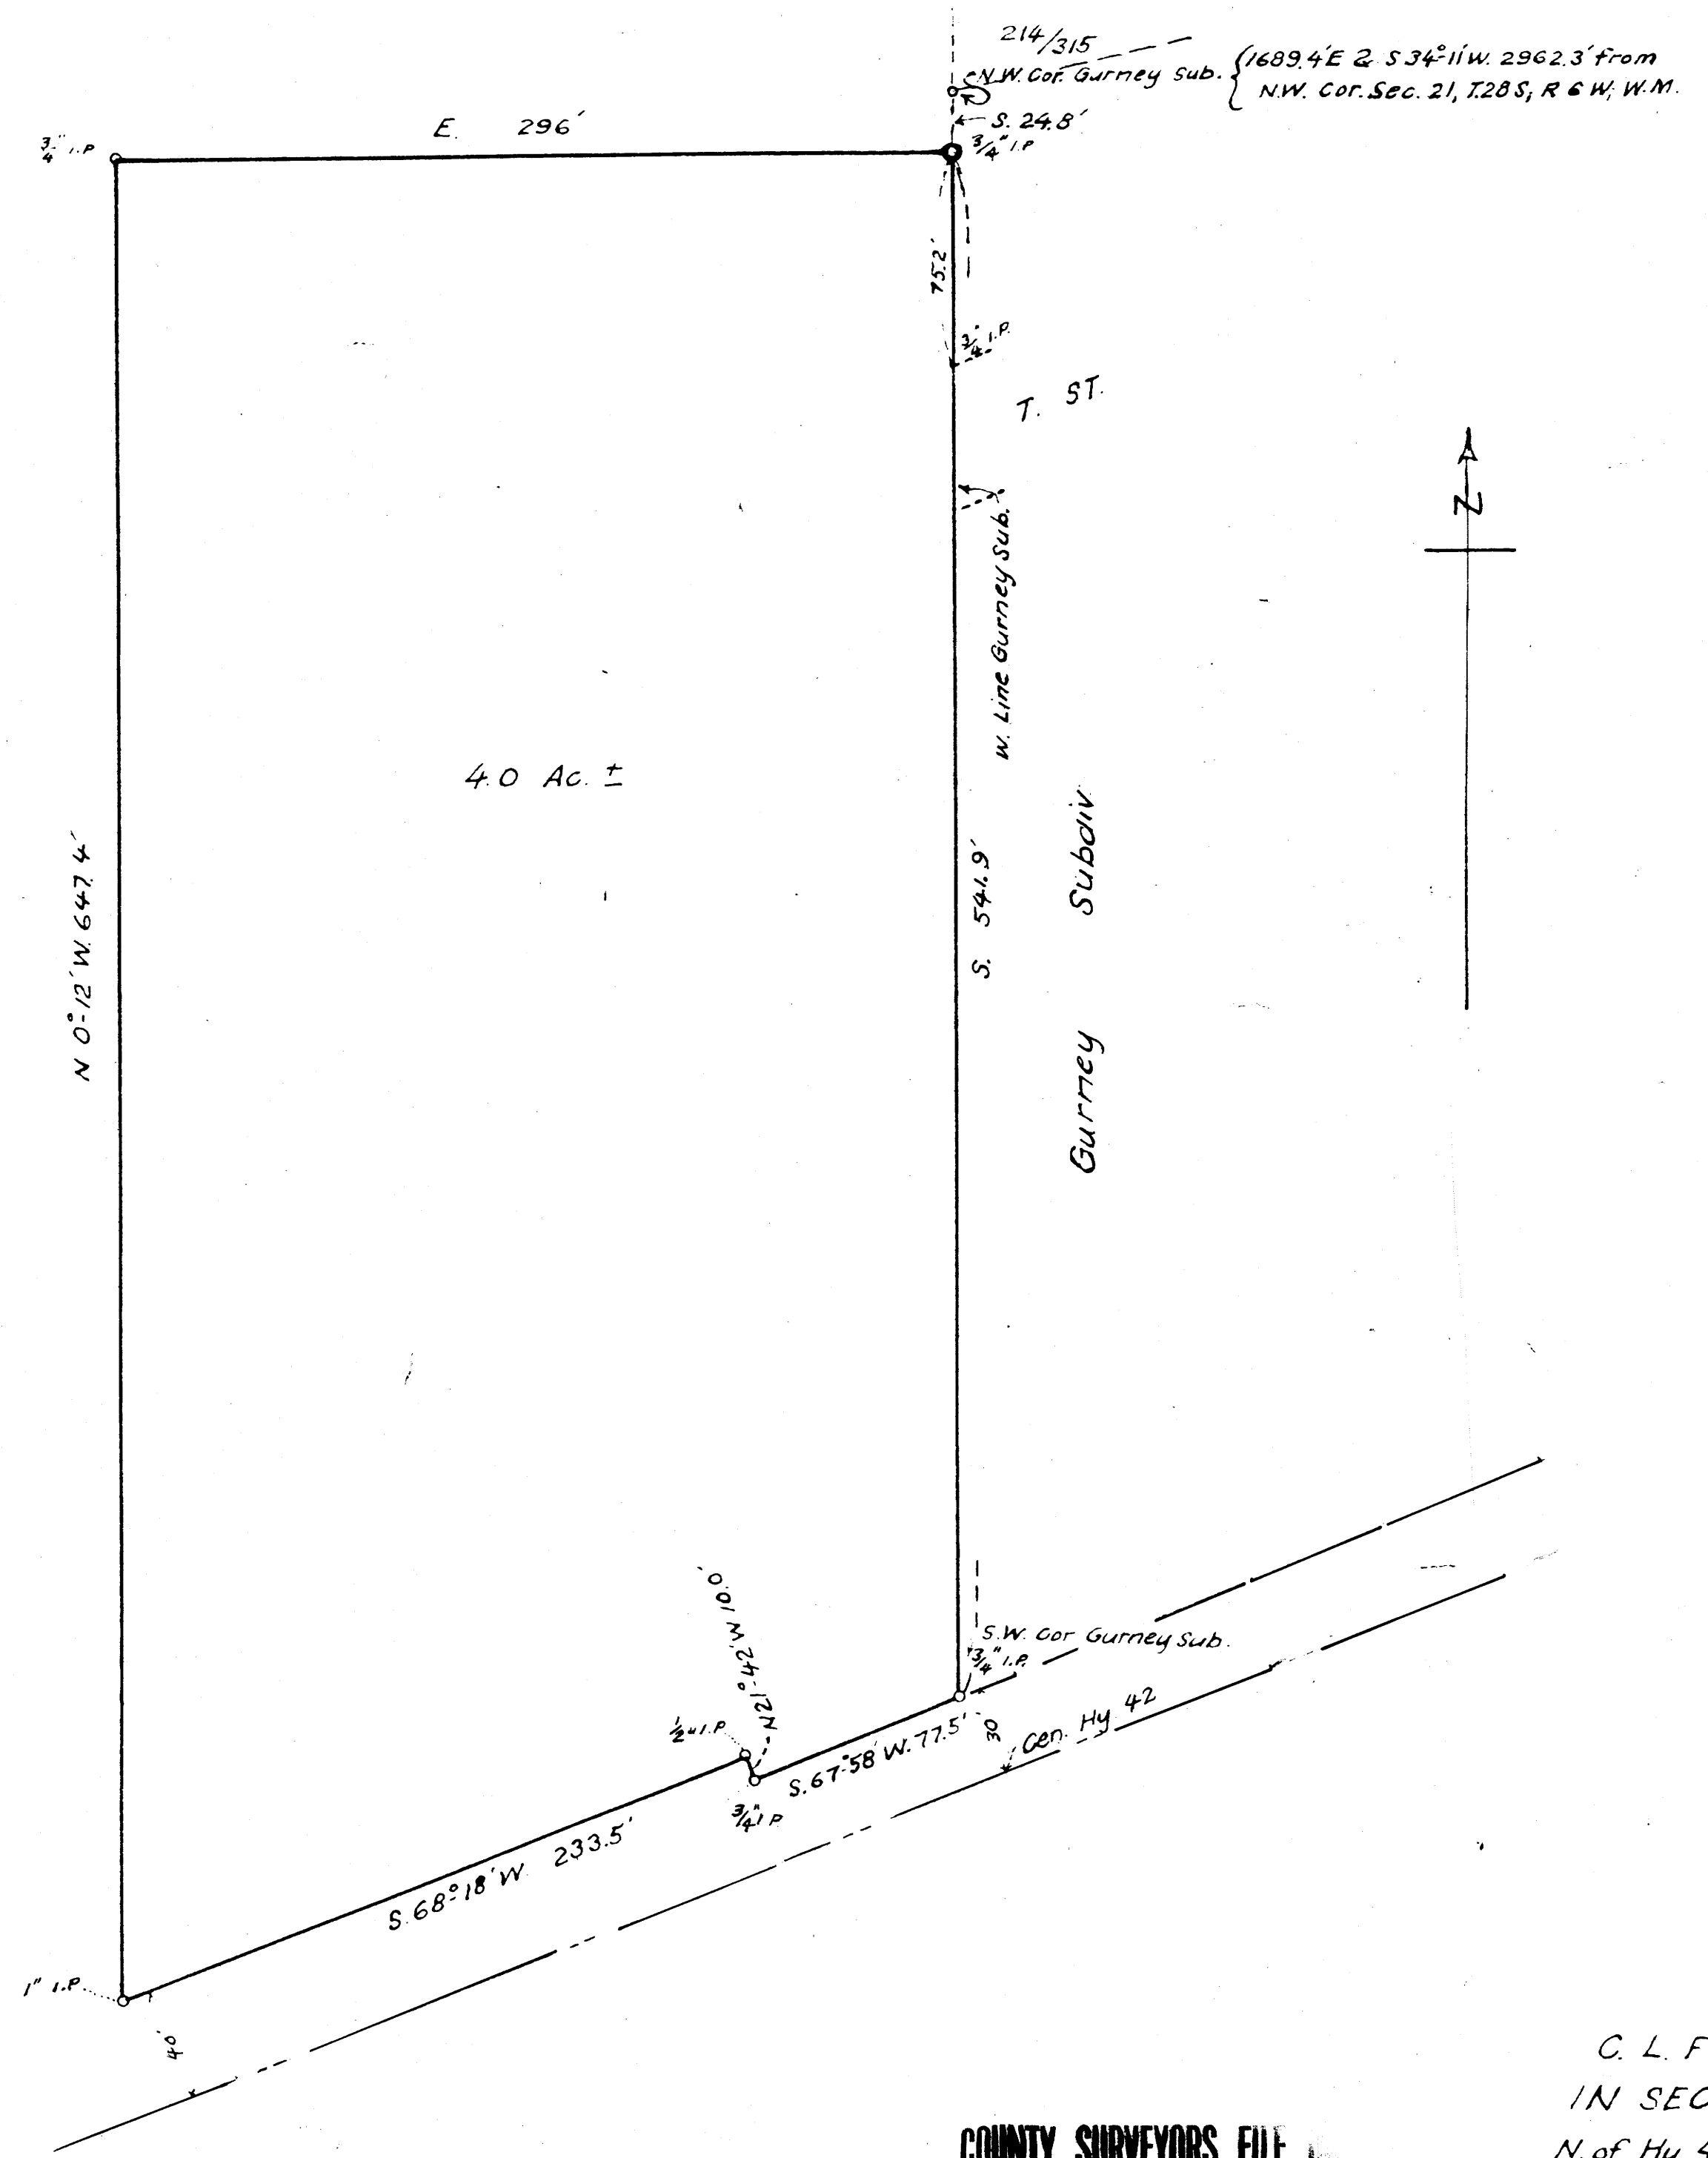

FILED  
OCT 24 1960

THIS COPY MADE FROM  
A XEROX 2510  
DATE 3-17-89

C. L. FULLERTON ACREAGE  
IN SEC. 20, T.28S; R.6W; WIL. MER.  
N. of Hy. 42 & W. of Gurney Subdivision  
Nov. 1959 1" = 50ft

*Arthur J. ...*

COUNTY SURVEYORS FILE  
DO NOT REMOVE FROM OFFICE