




COUNTY RECORDS FILE DATA
DO NOT REMOVE FROM OFFICE

ERNEST CHERRY PROPERTY
OAKLAND, ORE
JUNE 1950 FRED L. DOW
SCALE 1"=100' REG. ENG

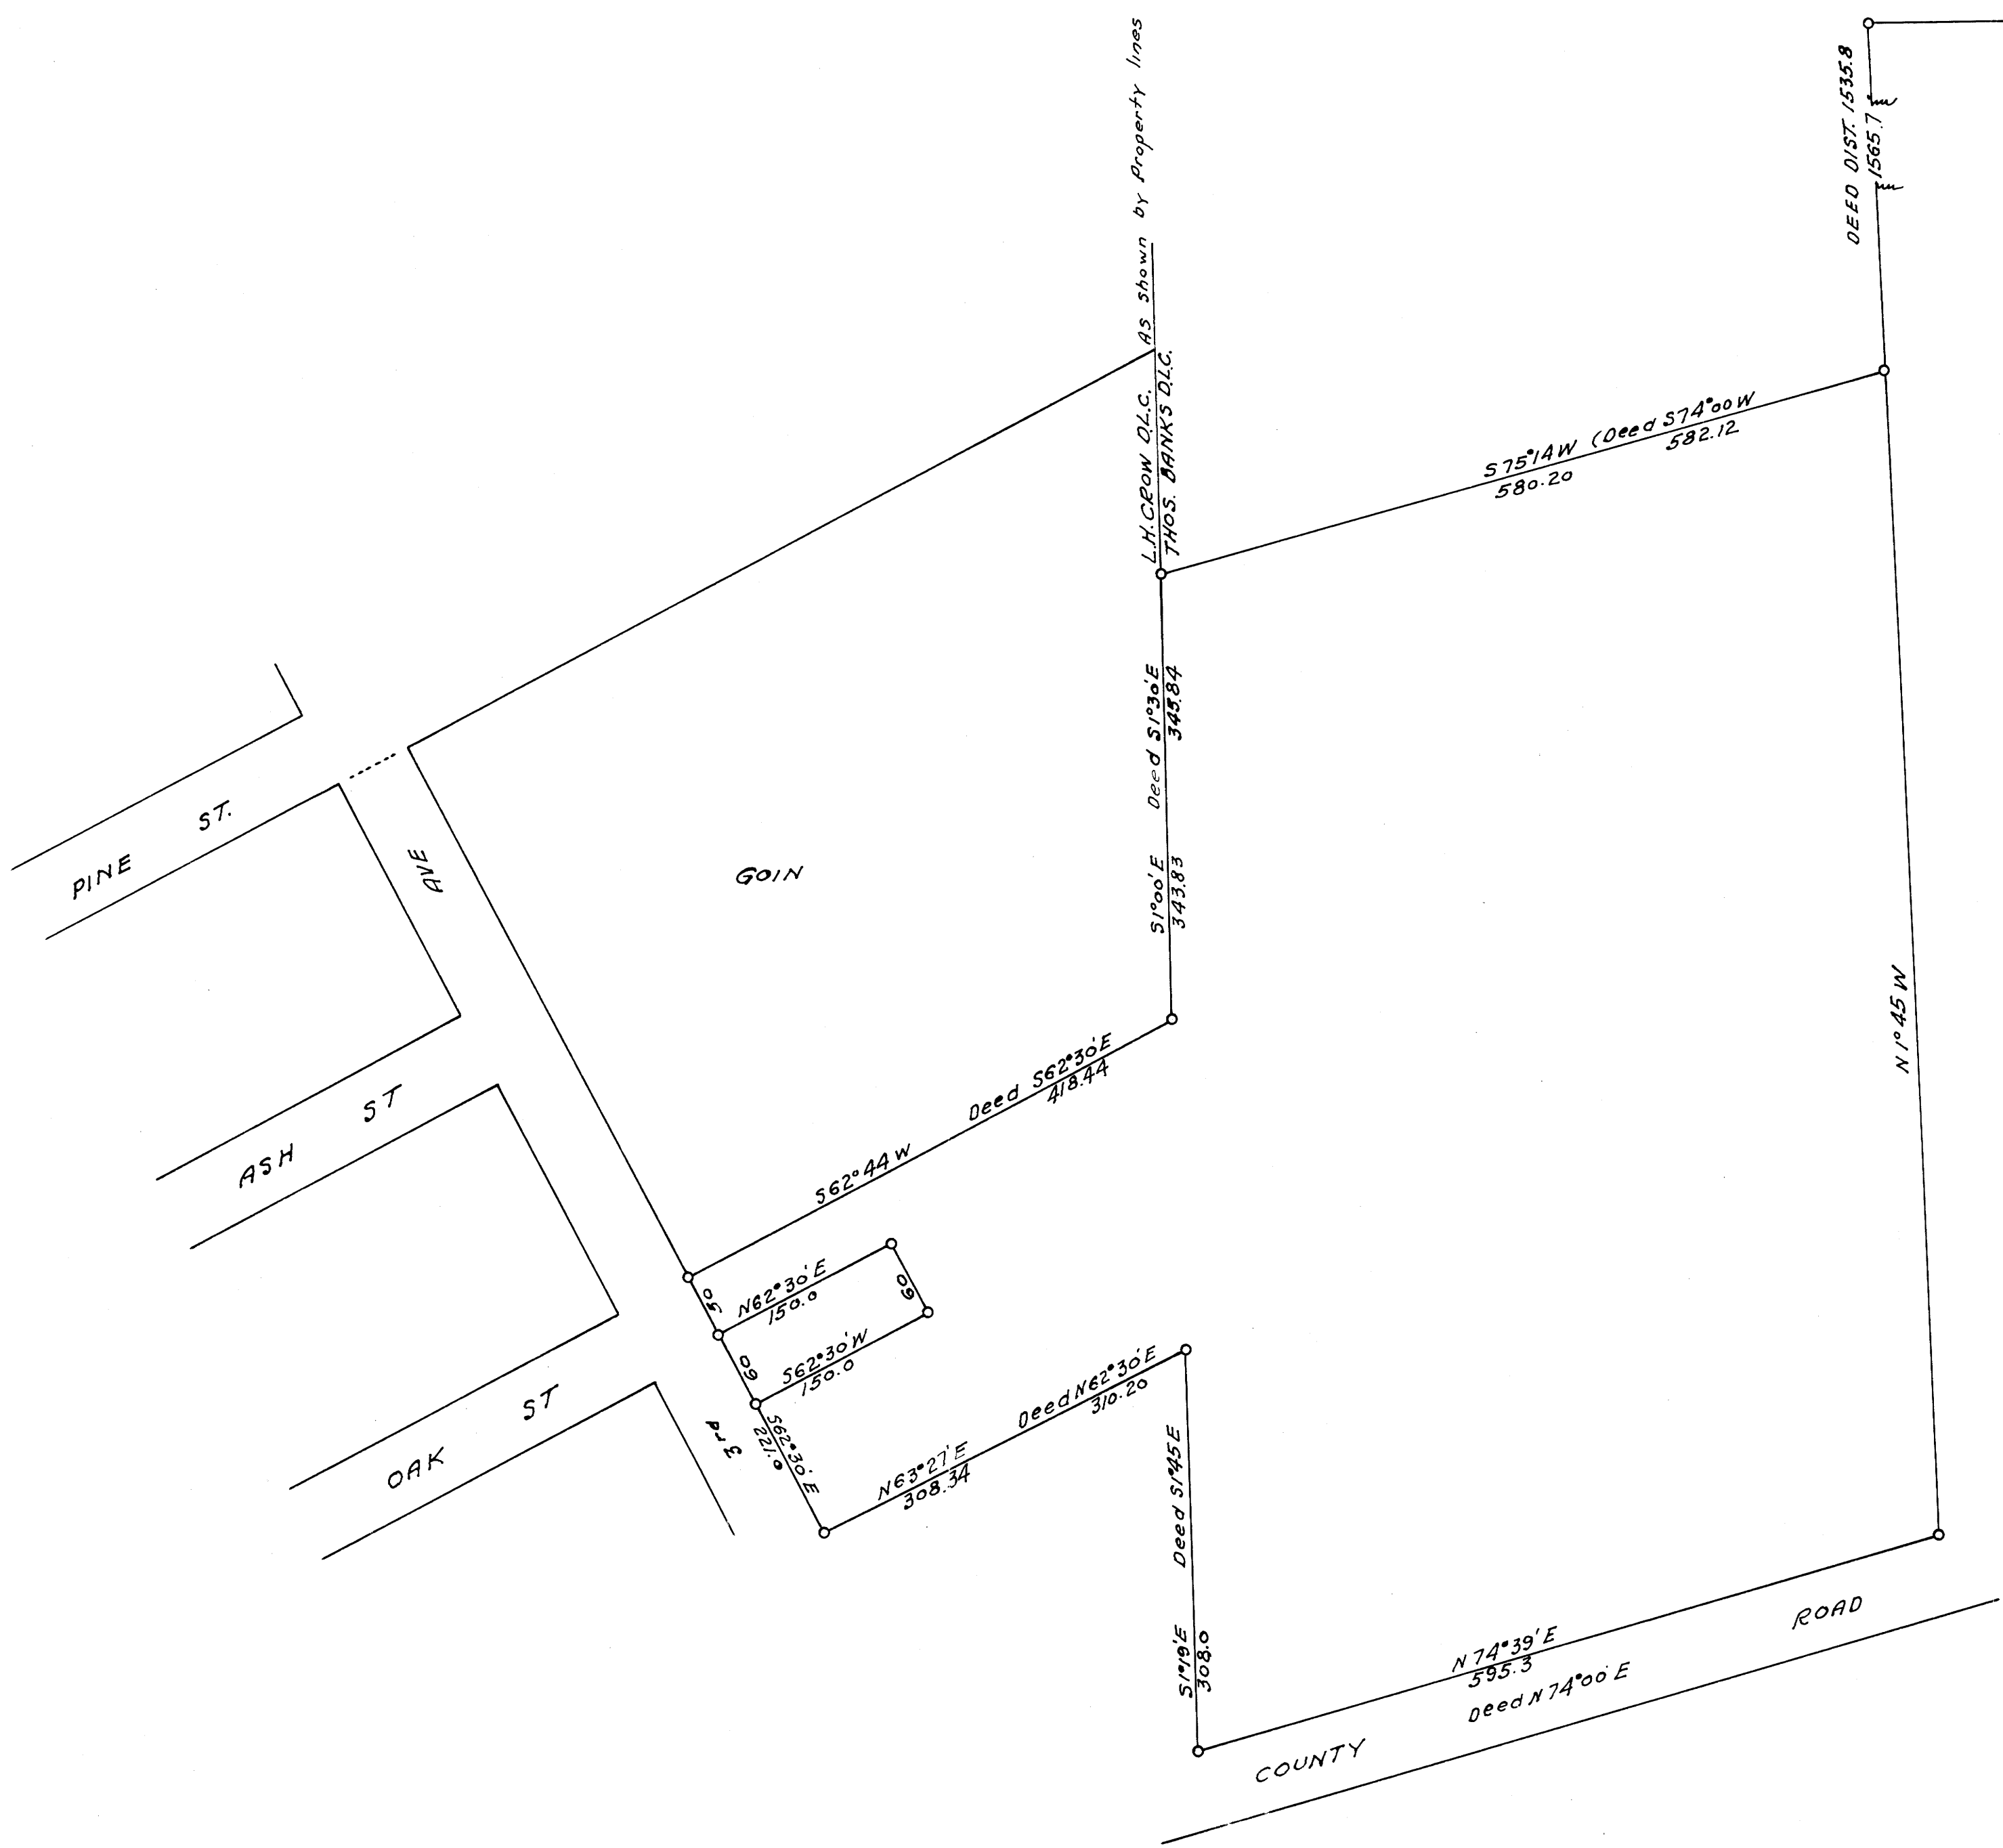

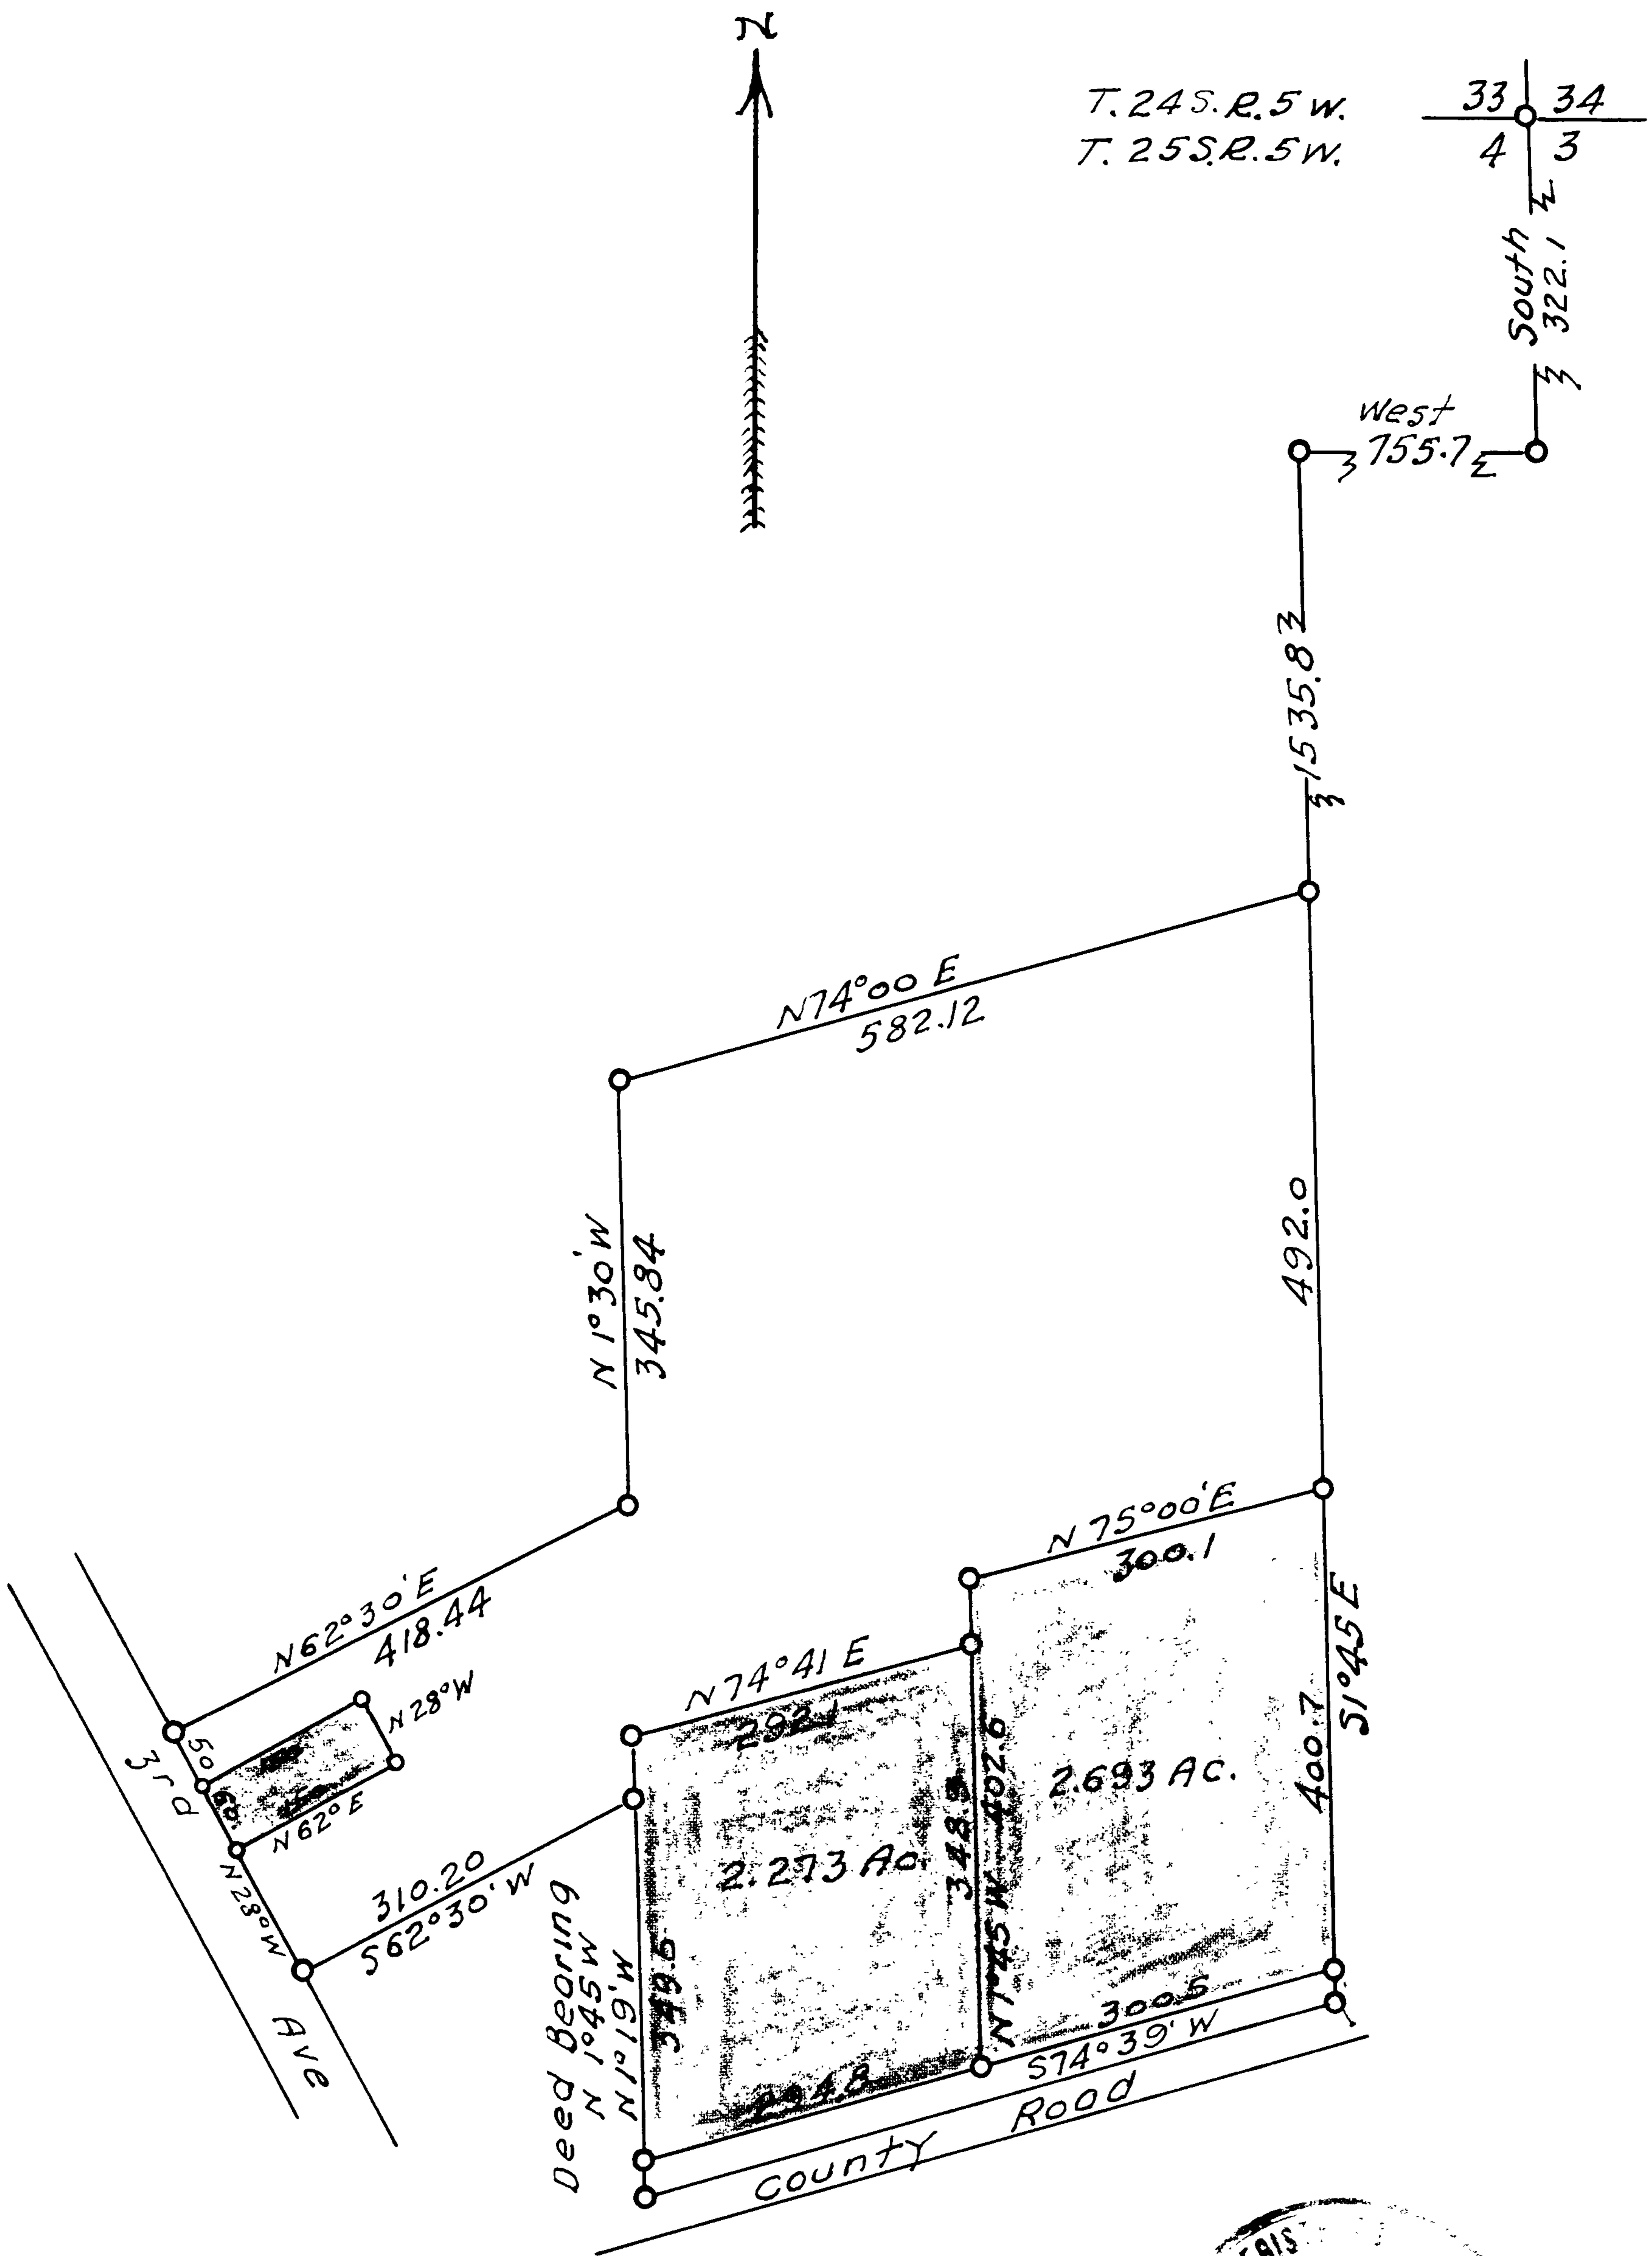

PROPERTY SURVEY
 FOR ERNEST CHERRY
 MAY 1949 FRED L. DOW
 SCALE 1"=200' REG ENG

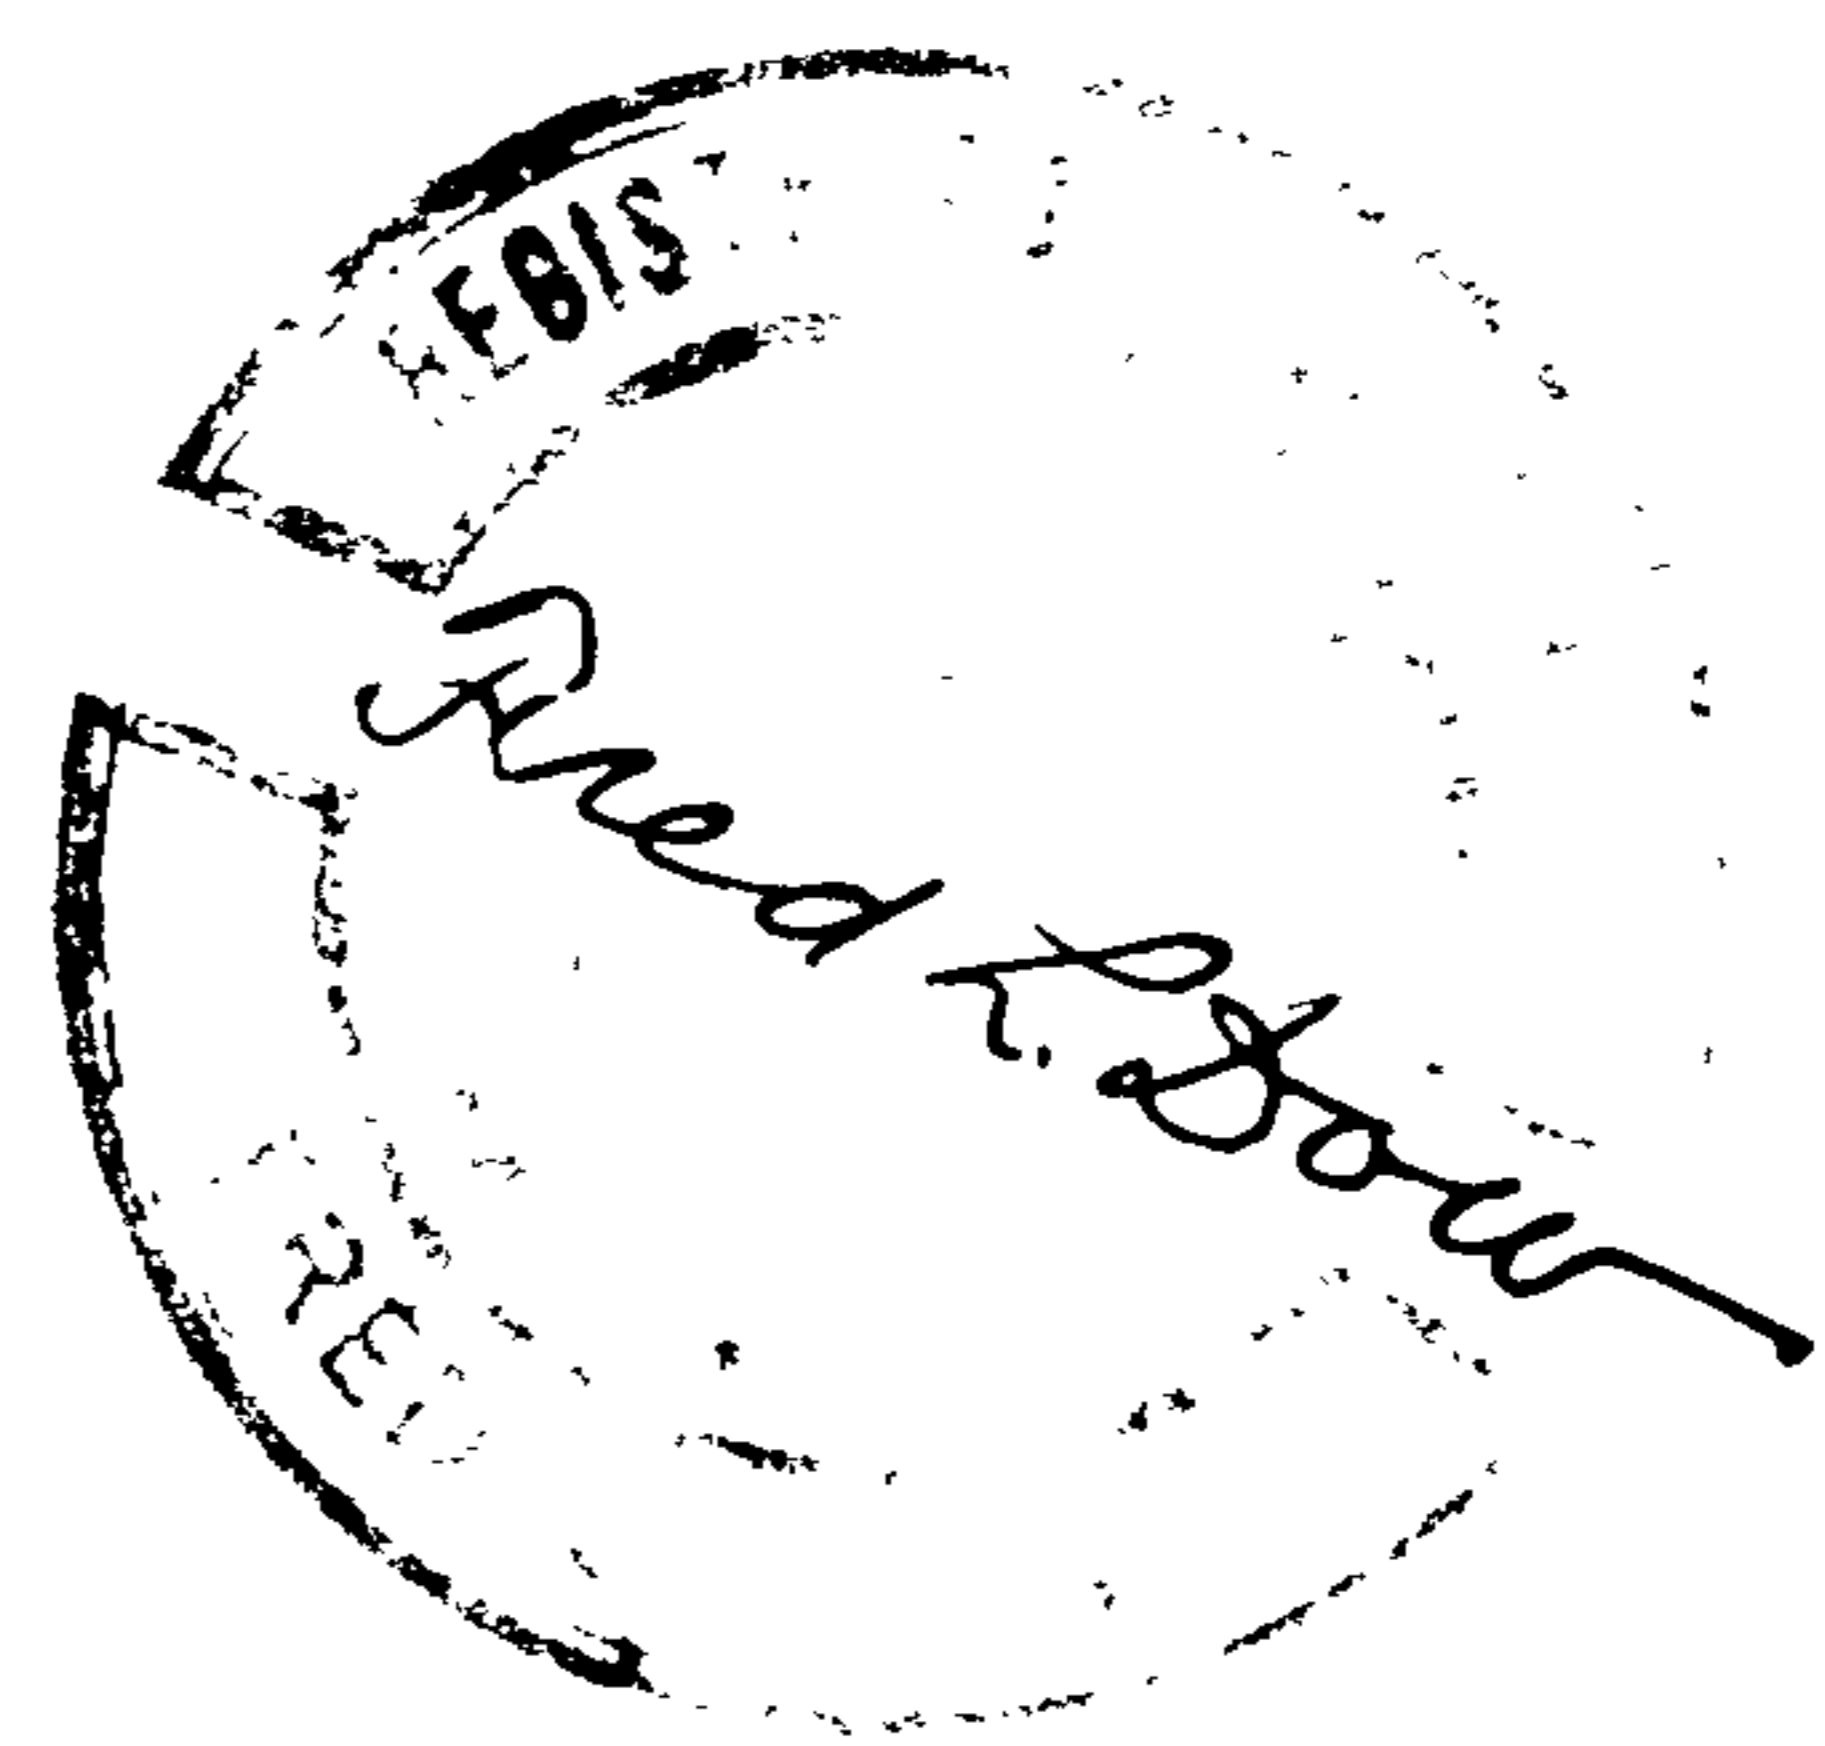

**COUNTY SURVEYORS FILE DATA
 DO NOT REMOVE FROM OFFICE**

CS FILE FOLDER

CONTAINS

MORE

INFORMATION