


CARL W. BROWNSON
OAKLAND

SEPTEMBER 1953
SCALE 1"=100'

FRED L. DOW
CIV. ENGINEER

NOTE:-
Bearings by Solar observation

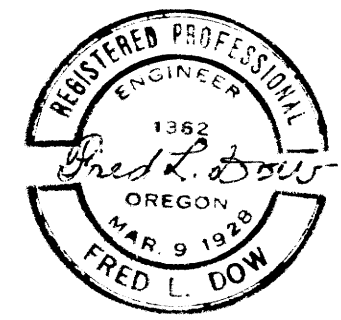

FILED
RECEIVED
NOV 27 1953
COUNTY SURVEYOR
DOUGLAS COUNTY, ORE.

An old Yew wood post found in place and accepted as the section corner. No witness trees found. Set 1"x40" steel shaft and established witness trees. A 26" Fir bears S55°E 27.3 ft. marked B.T. A 22" Fir bears S114°5E 55 ft. marked B.T.

Set 1"x36" Iron pipe
592.5
1144.3
1929 To Meander Corner by Field notes
NOTE:-
The property owners abutting the section line between sections 2 and 3 on the south side of the Umpqua River have agreed to accept the line as surveyed in Sept. 1953 as their division line between the properties, such agreement to be made to matter of record.
Set 1"x36" Iron pipe
609
Set 1"x18" Iron pipe

T.E. HIGGINBOTHAM
490.9
L. M. BULLOCK
3 2
10 11
T. 24 S. R. 7 W.

COUNTY SURVEYORS FILE DATA
DO NOT REMOVE FROM OFFICE