



COUNTY SURVEYORS FILE DATA  
DO NOT REMOVE FROM OFFICE

C.S. File 50/10  
Map File M12-4

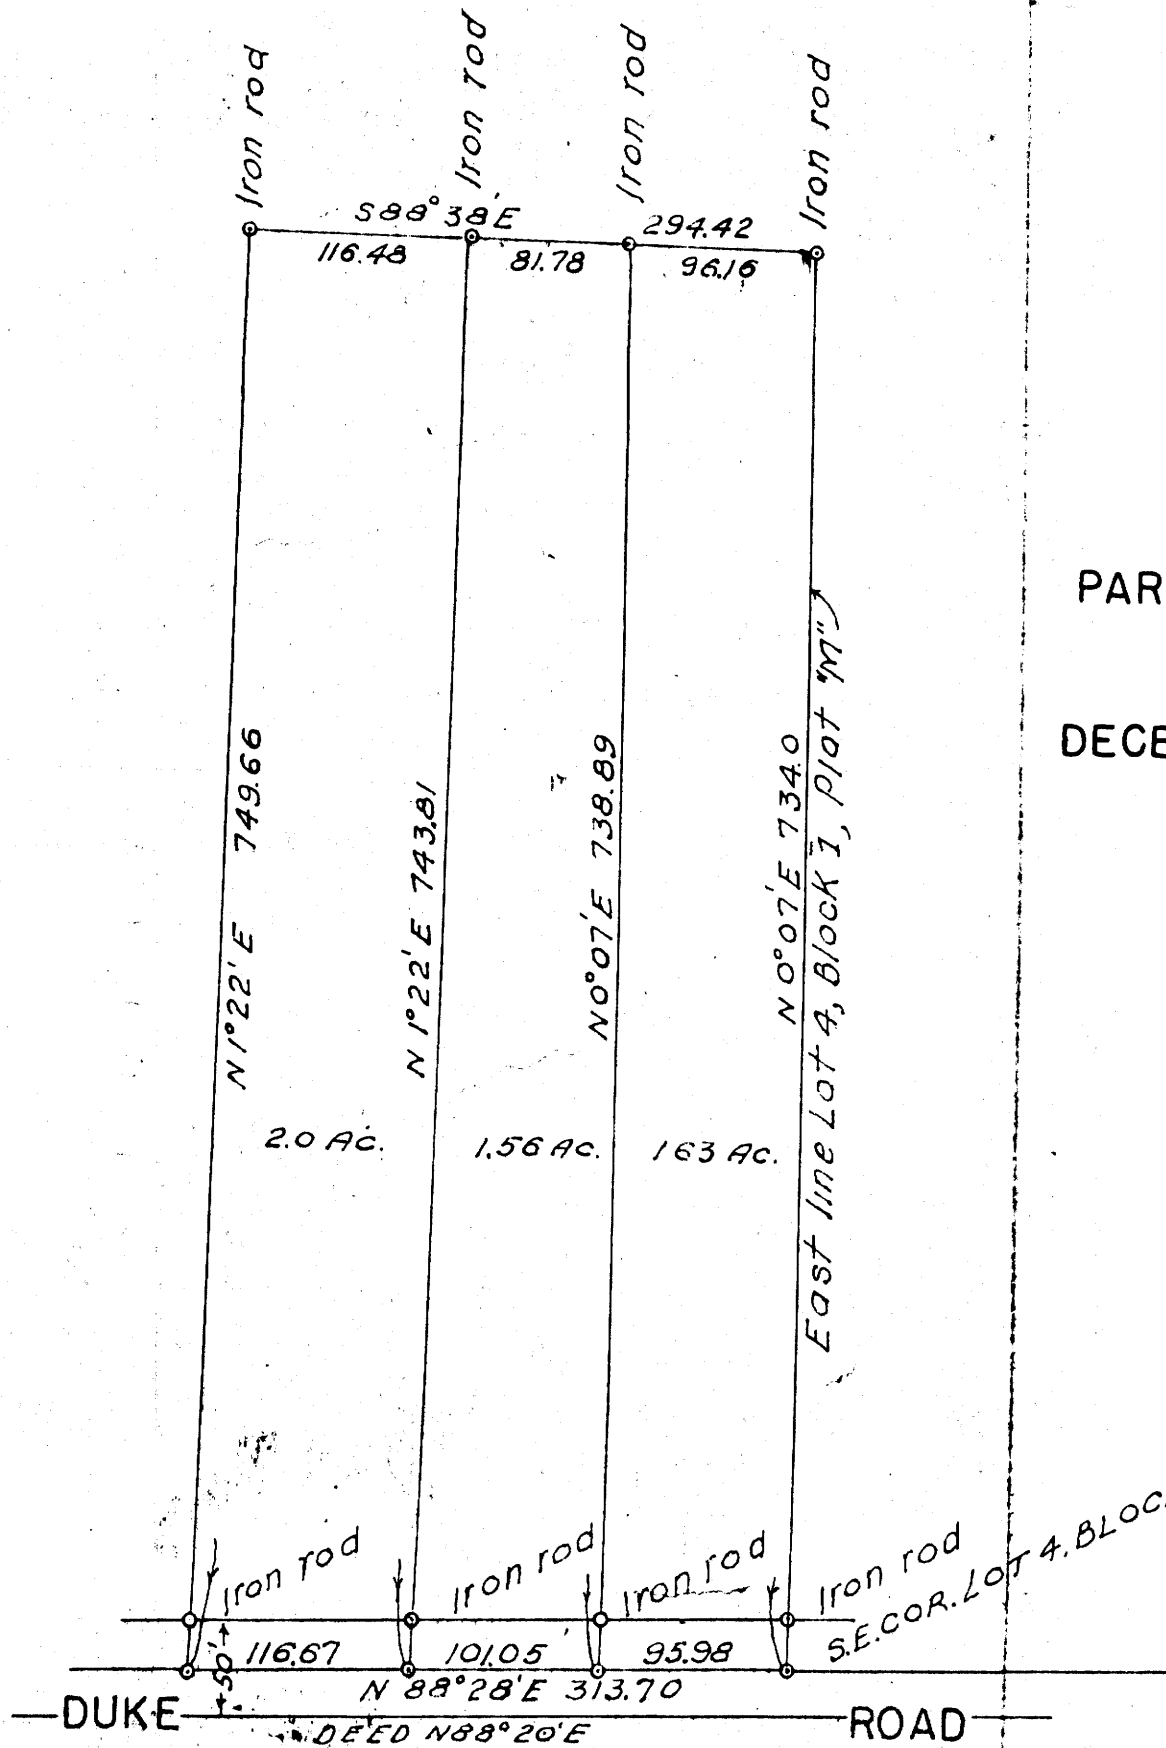

FREDERICK E. BLAKLEY  
SUTHERLIN  
PART OF LOT 4, BLOCK I, PLAT "M"  
S.L.&W.Co.  
DECEMBER 1954 SCALE 1"=100'

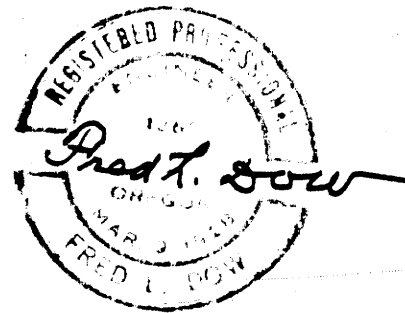

THIS COPY MADE FROM  
A XEROX 2510  
DATE 3-30-89

C.S. File 50/10  
Map File M12-4