


PLAT SHOWING LAND BOUNDARIES IN SECTIONS 4-8 & 9. T-29-S. R-6-W.

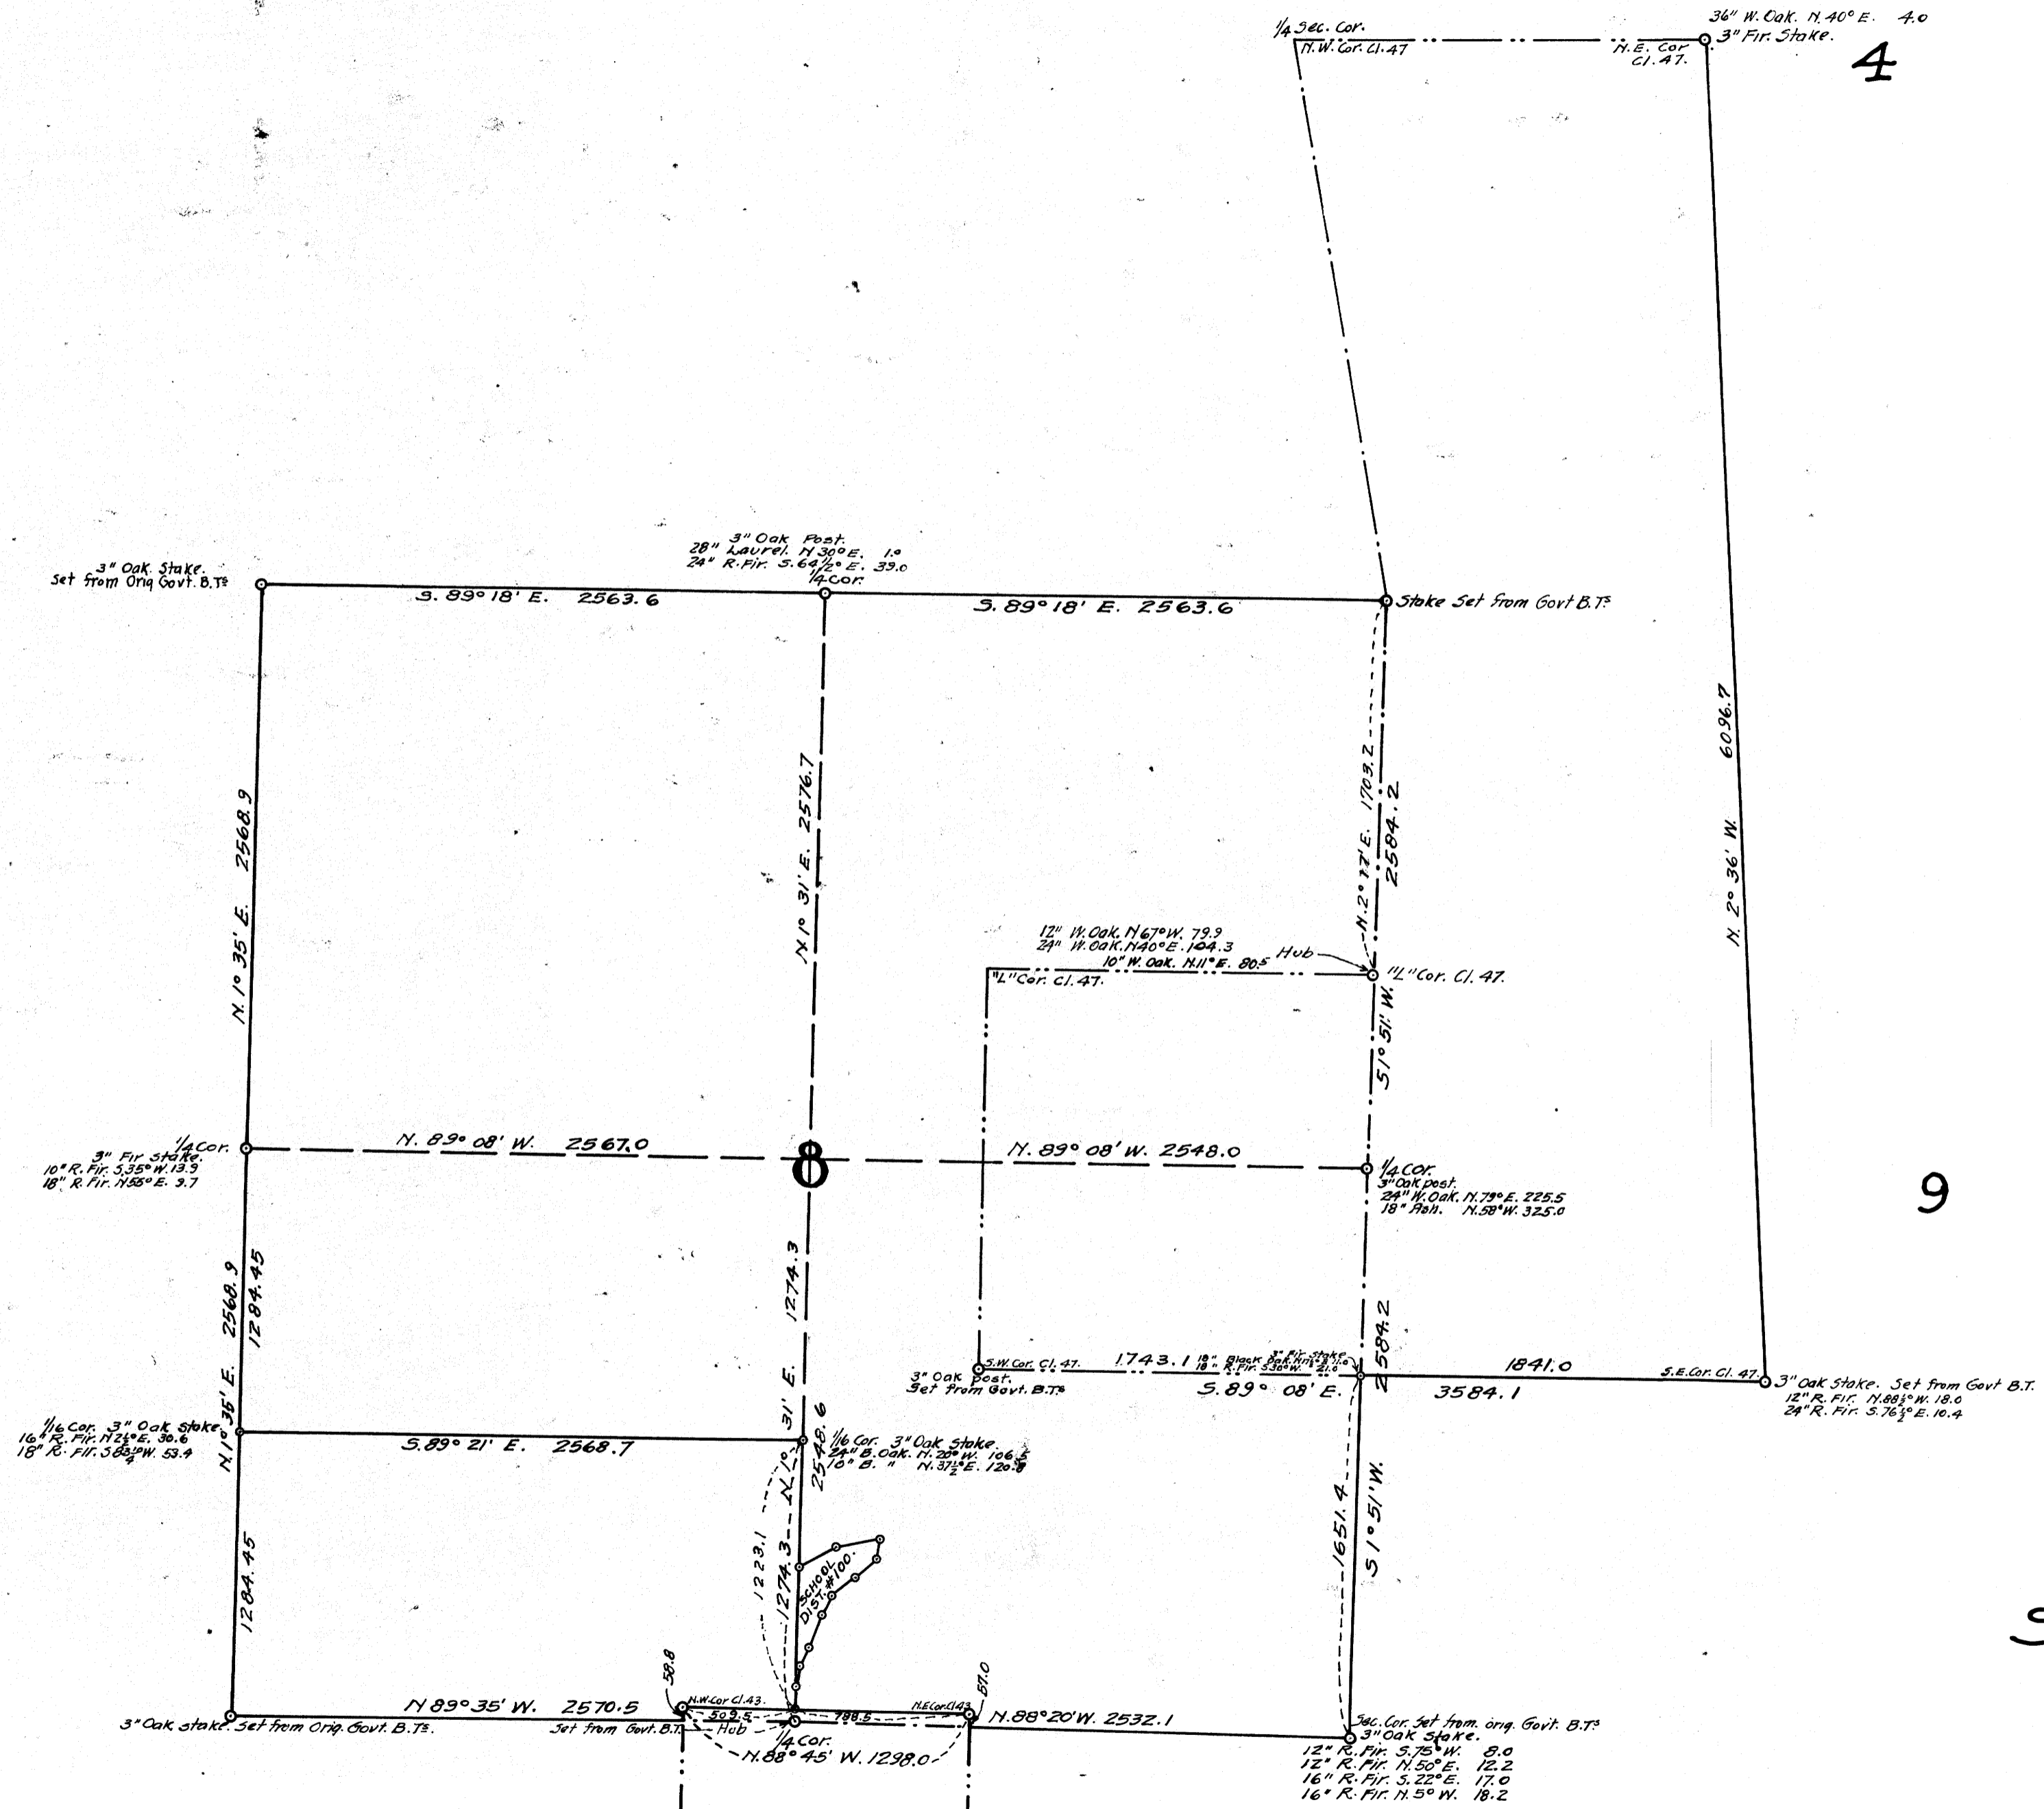

9

COUNTY SURVEYORS FILE
DO NOT REMOVE FROM OFFICE

SCALE 1" = 600'

Jan 27, 1917
E. H. Lemox

FROM THE OFFICE OF L.G. HICKS. 1-9-17.

C.S. FILE 21-9
MAP FILE M13-71

C.S. FILE 21-9
MAP FILE M13-71