


NOTE: Bearings Based On  $S 89^{\circ} 40' E$   
As Per The 1921 Survey By  
Cole.

COUNTY SURVEYOR'S OFFICE  
DOUGLAS COUNTY, OREGON

SURVEY TO MONUMENT CORNERS,  
SECTION 27, T26S., R6W., W.M.

FRED M DARBY COUNTY SURVEYOR  
SURVEYED OCT. 27, 1958 BY  
JAMES W BYRON-DEPUTY SCALE 1" = 50'  
SURVEYED FOR CO. PARK DEPT.

COUNTY SURVEYORS FILE DATA  
DO NOT REMOVE FROM OFFICE

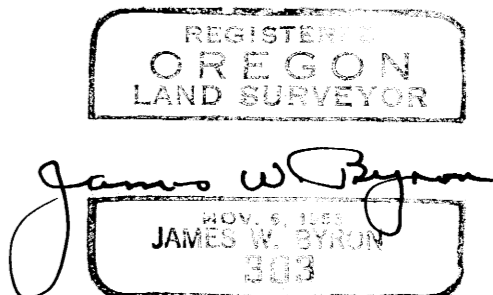

C.S. File 49/120  
M13-8

C.S. File 49/120  
M13-8