


FILED
RECEIVED
COUNTY SURVEYOR
DEW CLAS COUNTY, ORE.

M 14-6

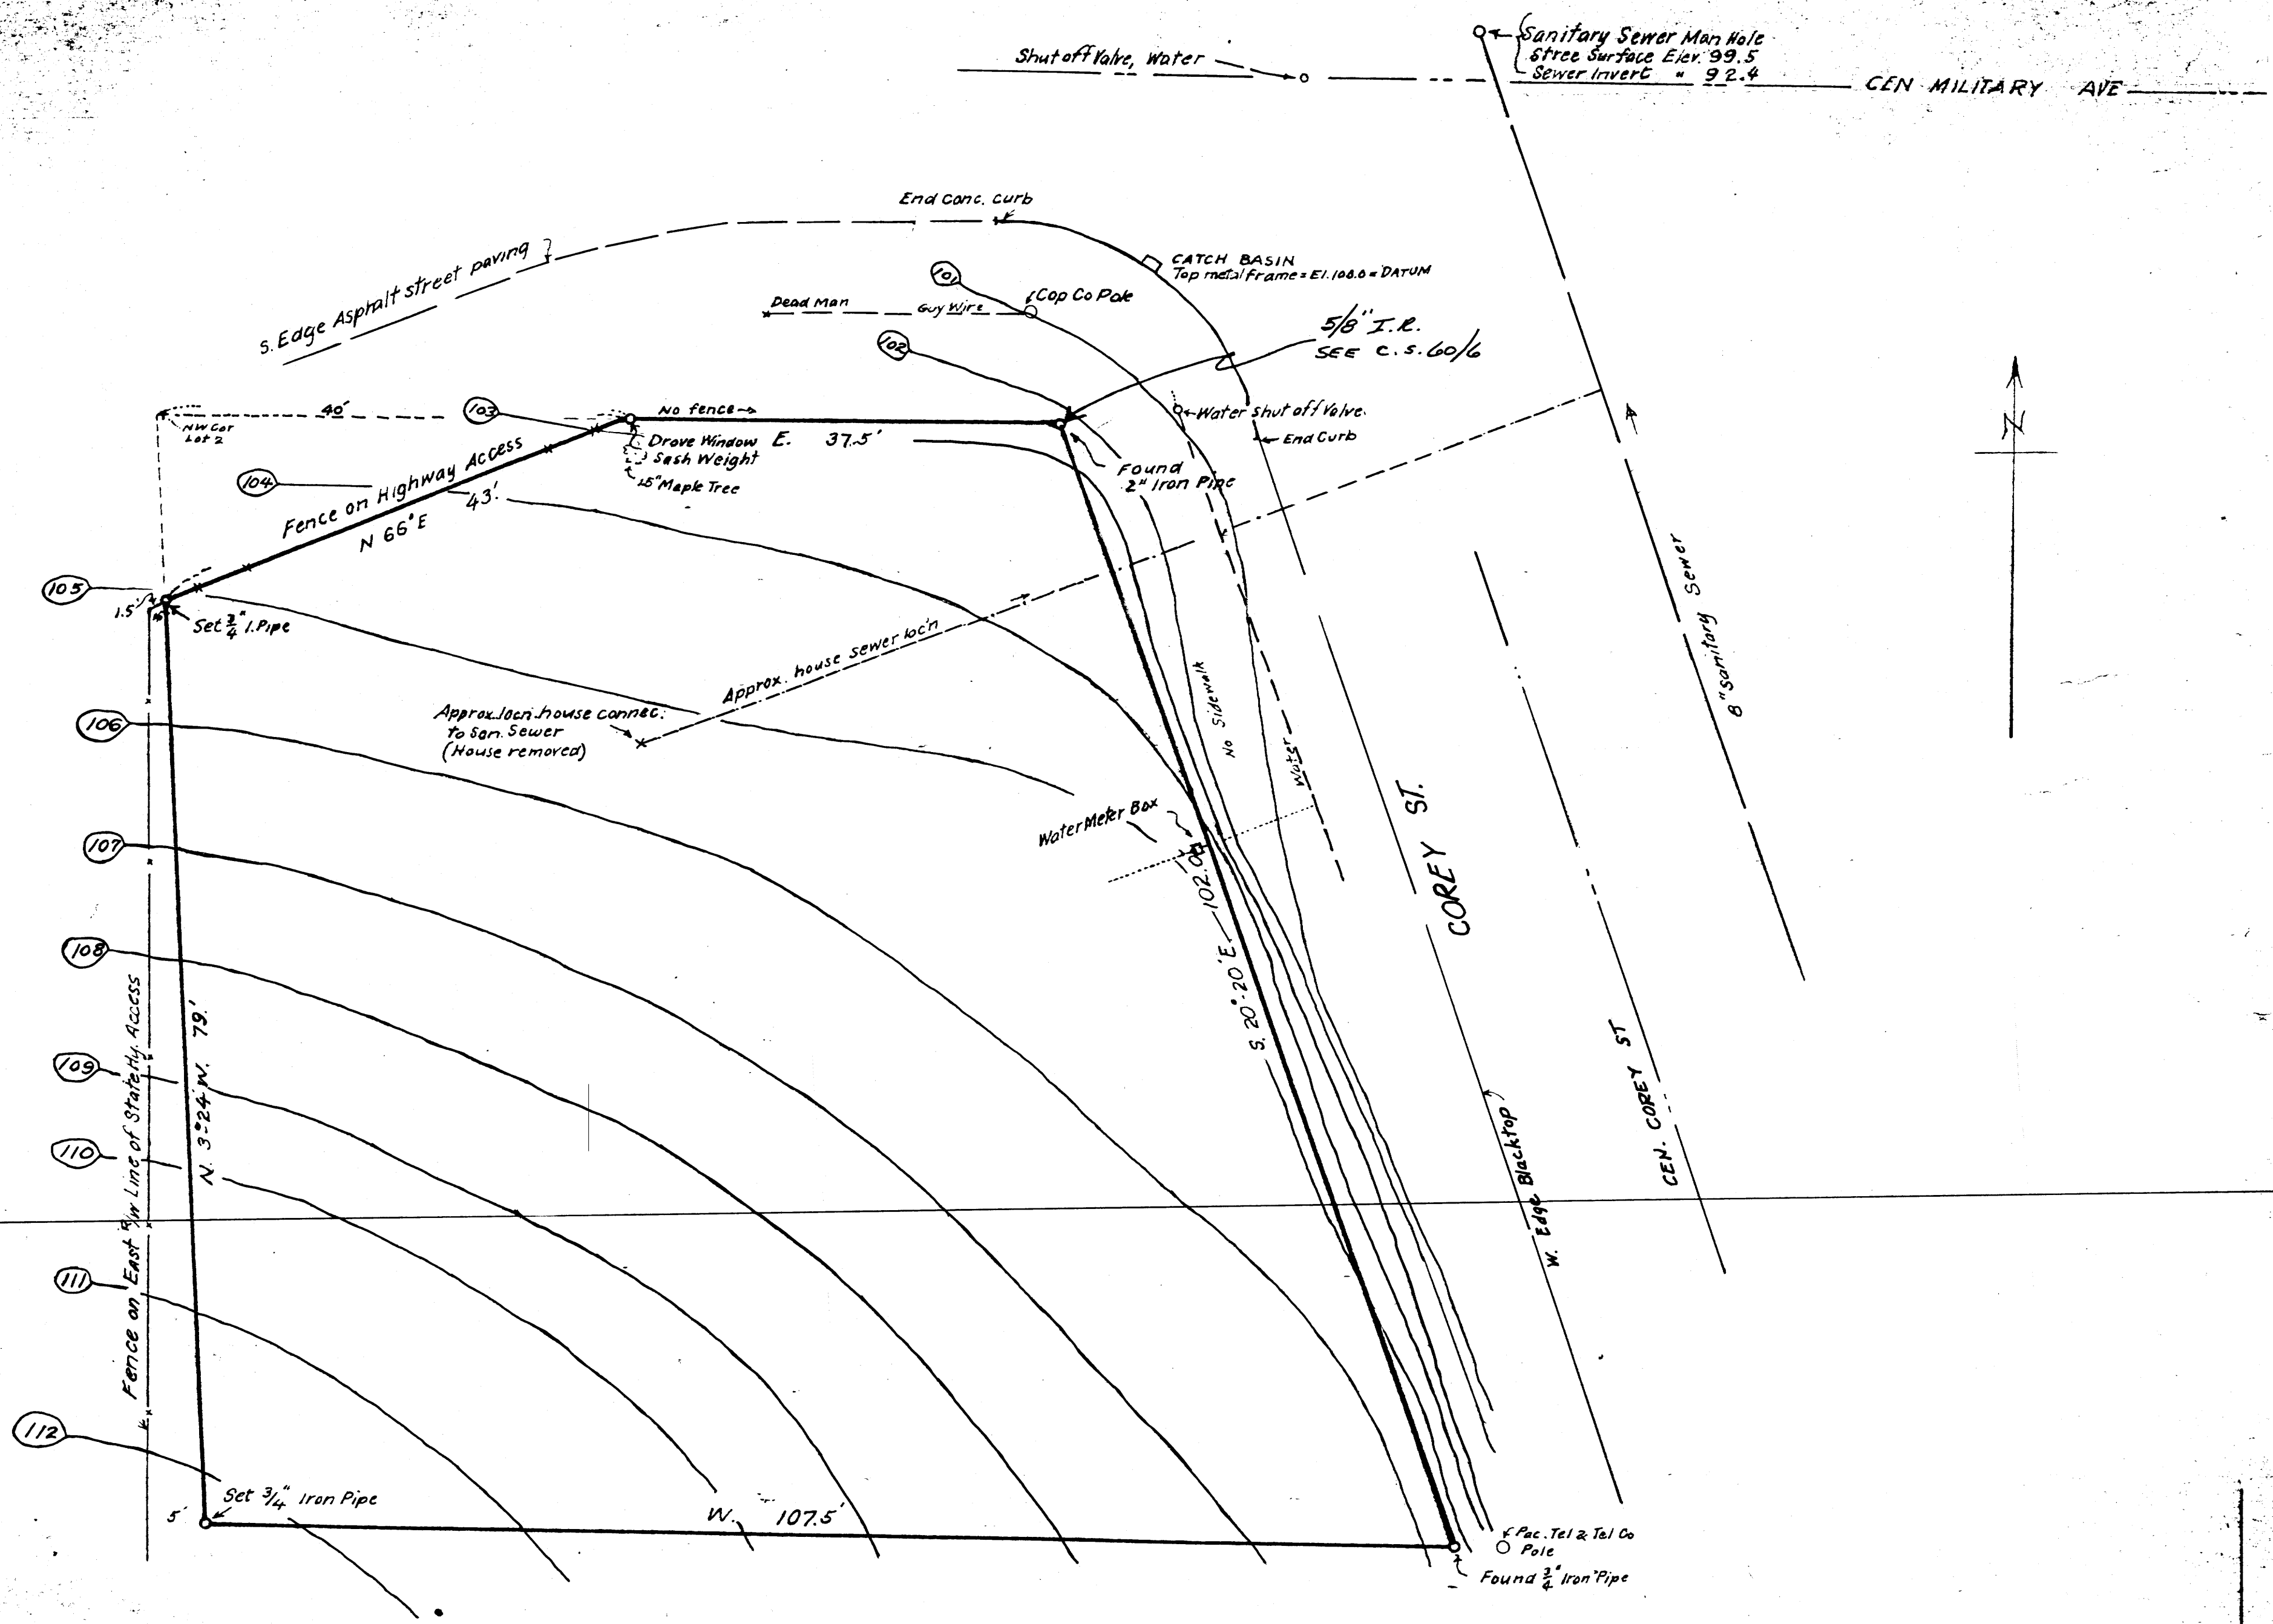

CAMP GAYLOR 732 W GOREY

DALE WOODRUFF ET UX.
 Lots 1 & 2, Cannon & Chafflers Add.
 to Roseburg, Ore.
 Nov. 1958

Arthur [Signature]

COUNTY SURVEYORS FILE DATA
DO NOT REMOVE FROM OFFICE

M 14-6