


COUNTY SURVEYORS FILE DA
DO NOT REMOVE FROM OFFICE

Location of 1 Acre Tract in
Lot 18 of First Addition to
Eden Orchards
Scale 1" = 100'

Found a Stone that lined with
fence on the South line of D.L.C.
No. 43, it was 7437.0 ft. East of S.W.
Cor. D.L.C. No. 43 and 25.4 ft. from
bearing tree. Set 1 1/4" x 3/16" I.P. with
brass disk, stamped "T275 R7W
D.L.C. 43 S.E. 1/4 Cor. R.L.S. 120"
From which a 30" white Oak
bears N 34° 45' W - 25.4 ft.
July 26 1948 G.A. Barnhart
J.A. Barnhart

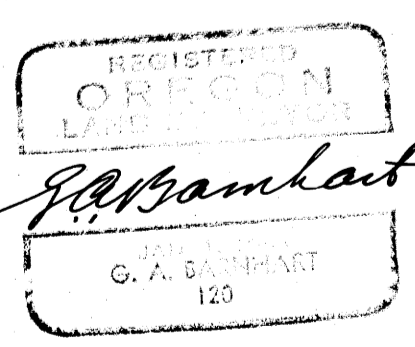

CS FILE FOLDER

CONTAINS

MORE

INFORMATION