


FILED
RECEIVED
COUNTY SURVEYOR
DOUGLAS COUNTY, ORE.

M 14-7

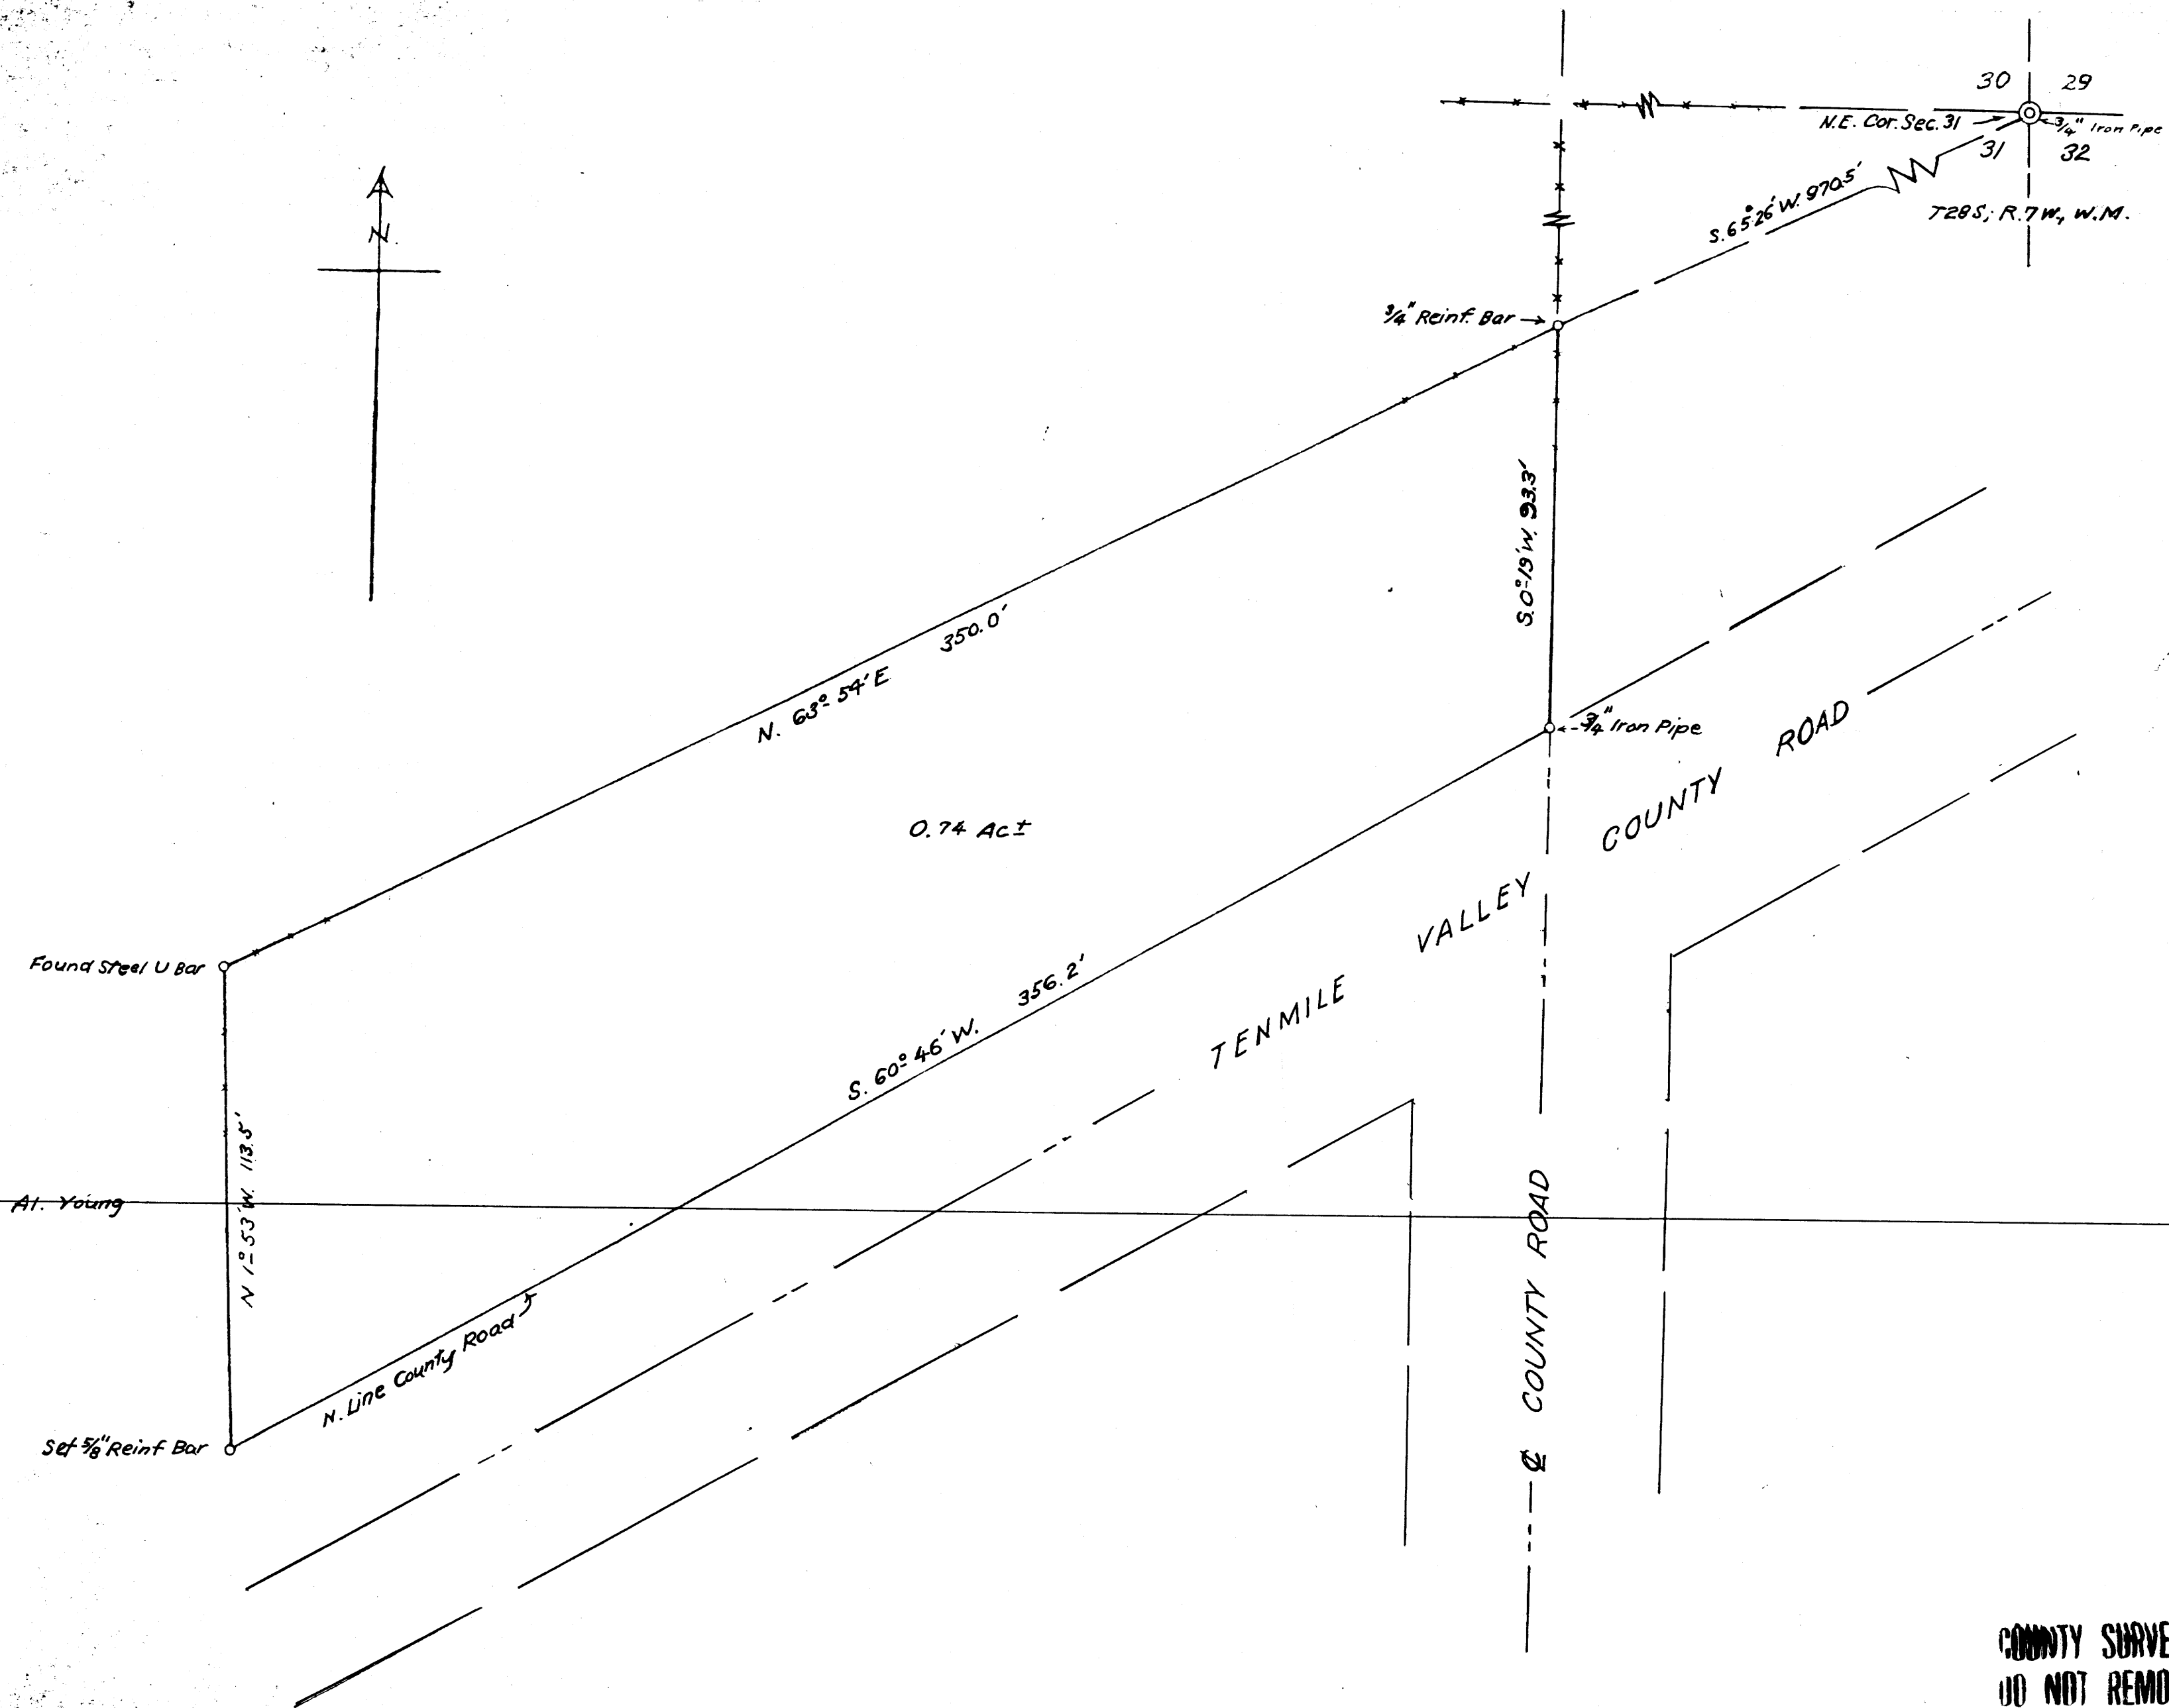

COUNTY SURVEYORS FILE DATA
DO NOT REMOVE FROM OFFICE

CHESTER HOWARD
TENMILE, ORE.
TRACT OF LAND FOR TRANSFER
IN NE⁴NE⁴ SEC. 31 T28S, R7W, W11 MER.
FEB. 1959
Arthur Howard

M 14-7