


FILED  
RECEIVED  
JUN 2 1959  
COUNTY SURVEYOR

THIS COPY MADE FROM  
A XEROX 2510  
DATE 5-8-89

**COUNTY SURVEYORS FILE IN  
DO NOT REMOVE FROM OFFICE**

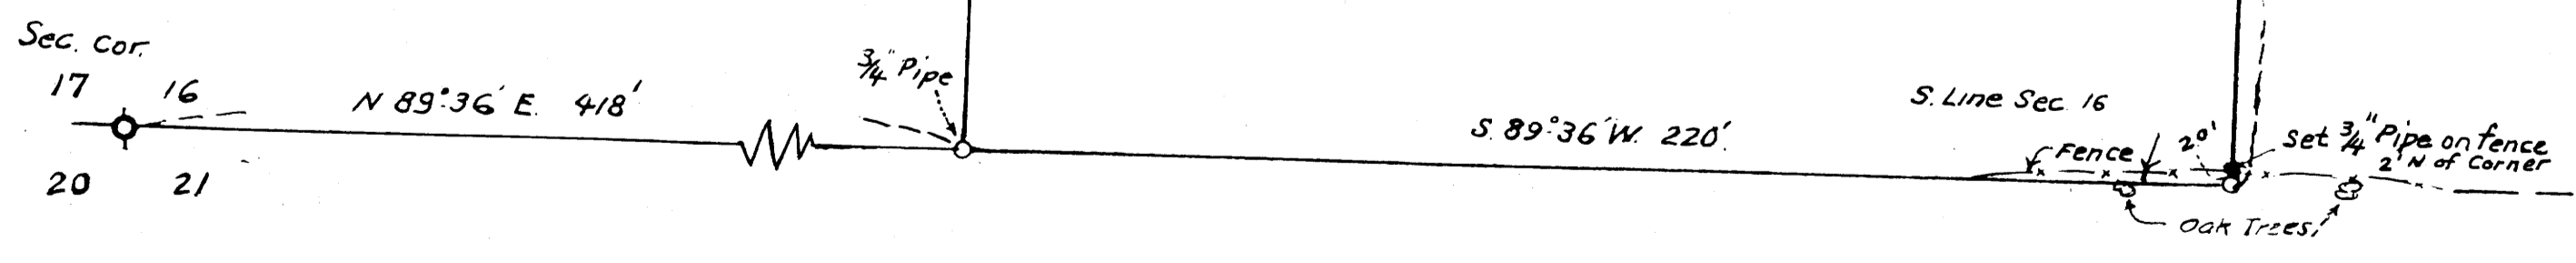

WINSTON-DILLARD WATER DISTRICT  
ACREAGE FROM ROY C. & MARY BURKS  
FOR TANK SITE  
IN SEC. 16, T28S, R. 6W, W. 1M, DOUGLAS COUNTY, ORE.  
MAY, 1959  
*A. H. ...* 1" = 30 FT.