


M 14-74

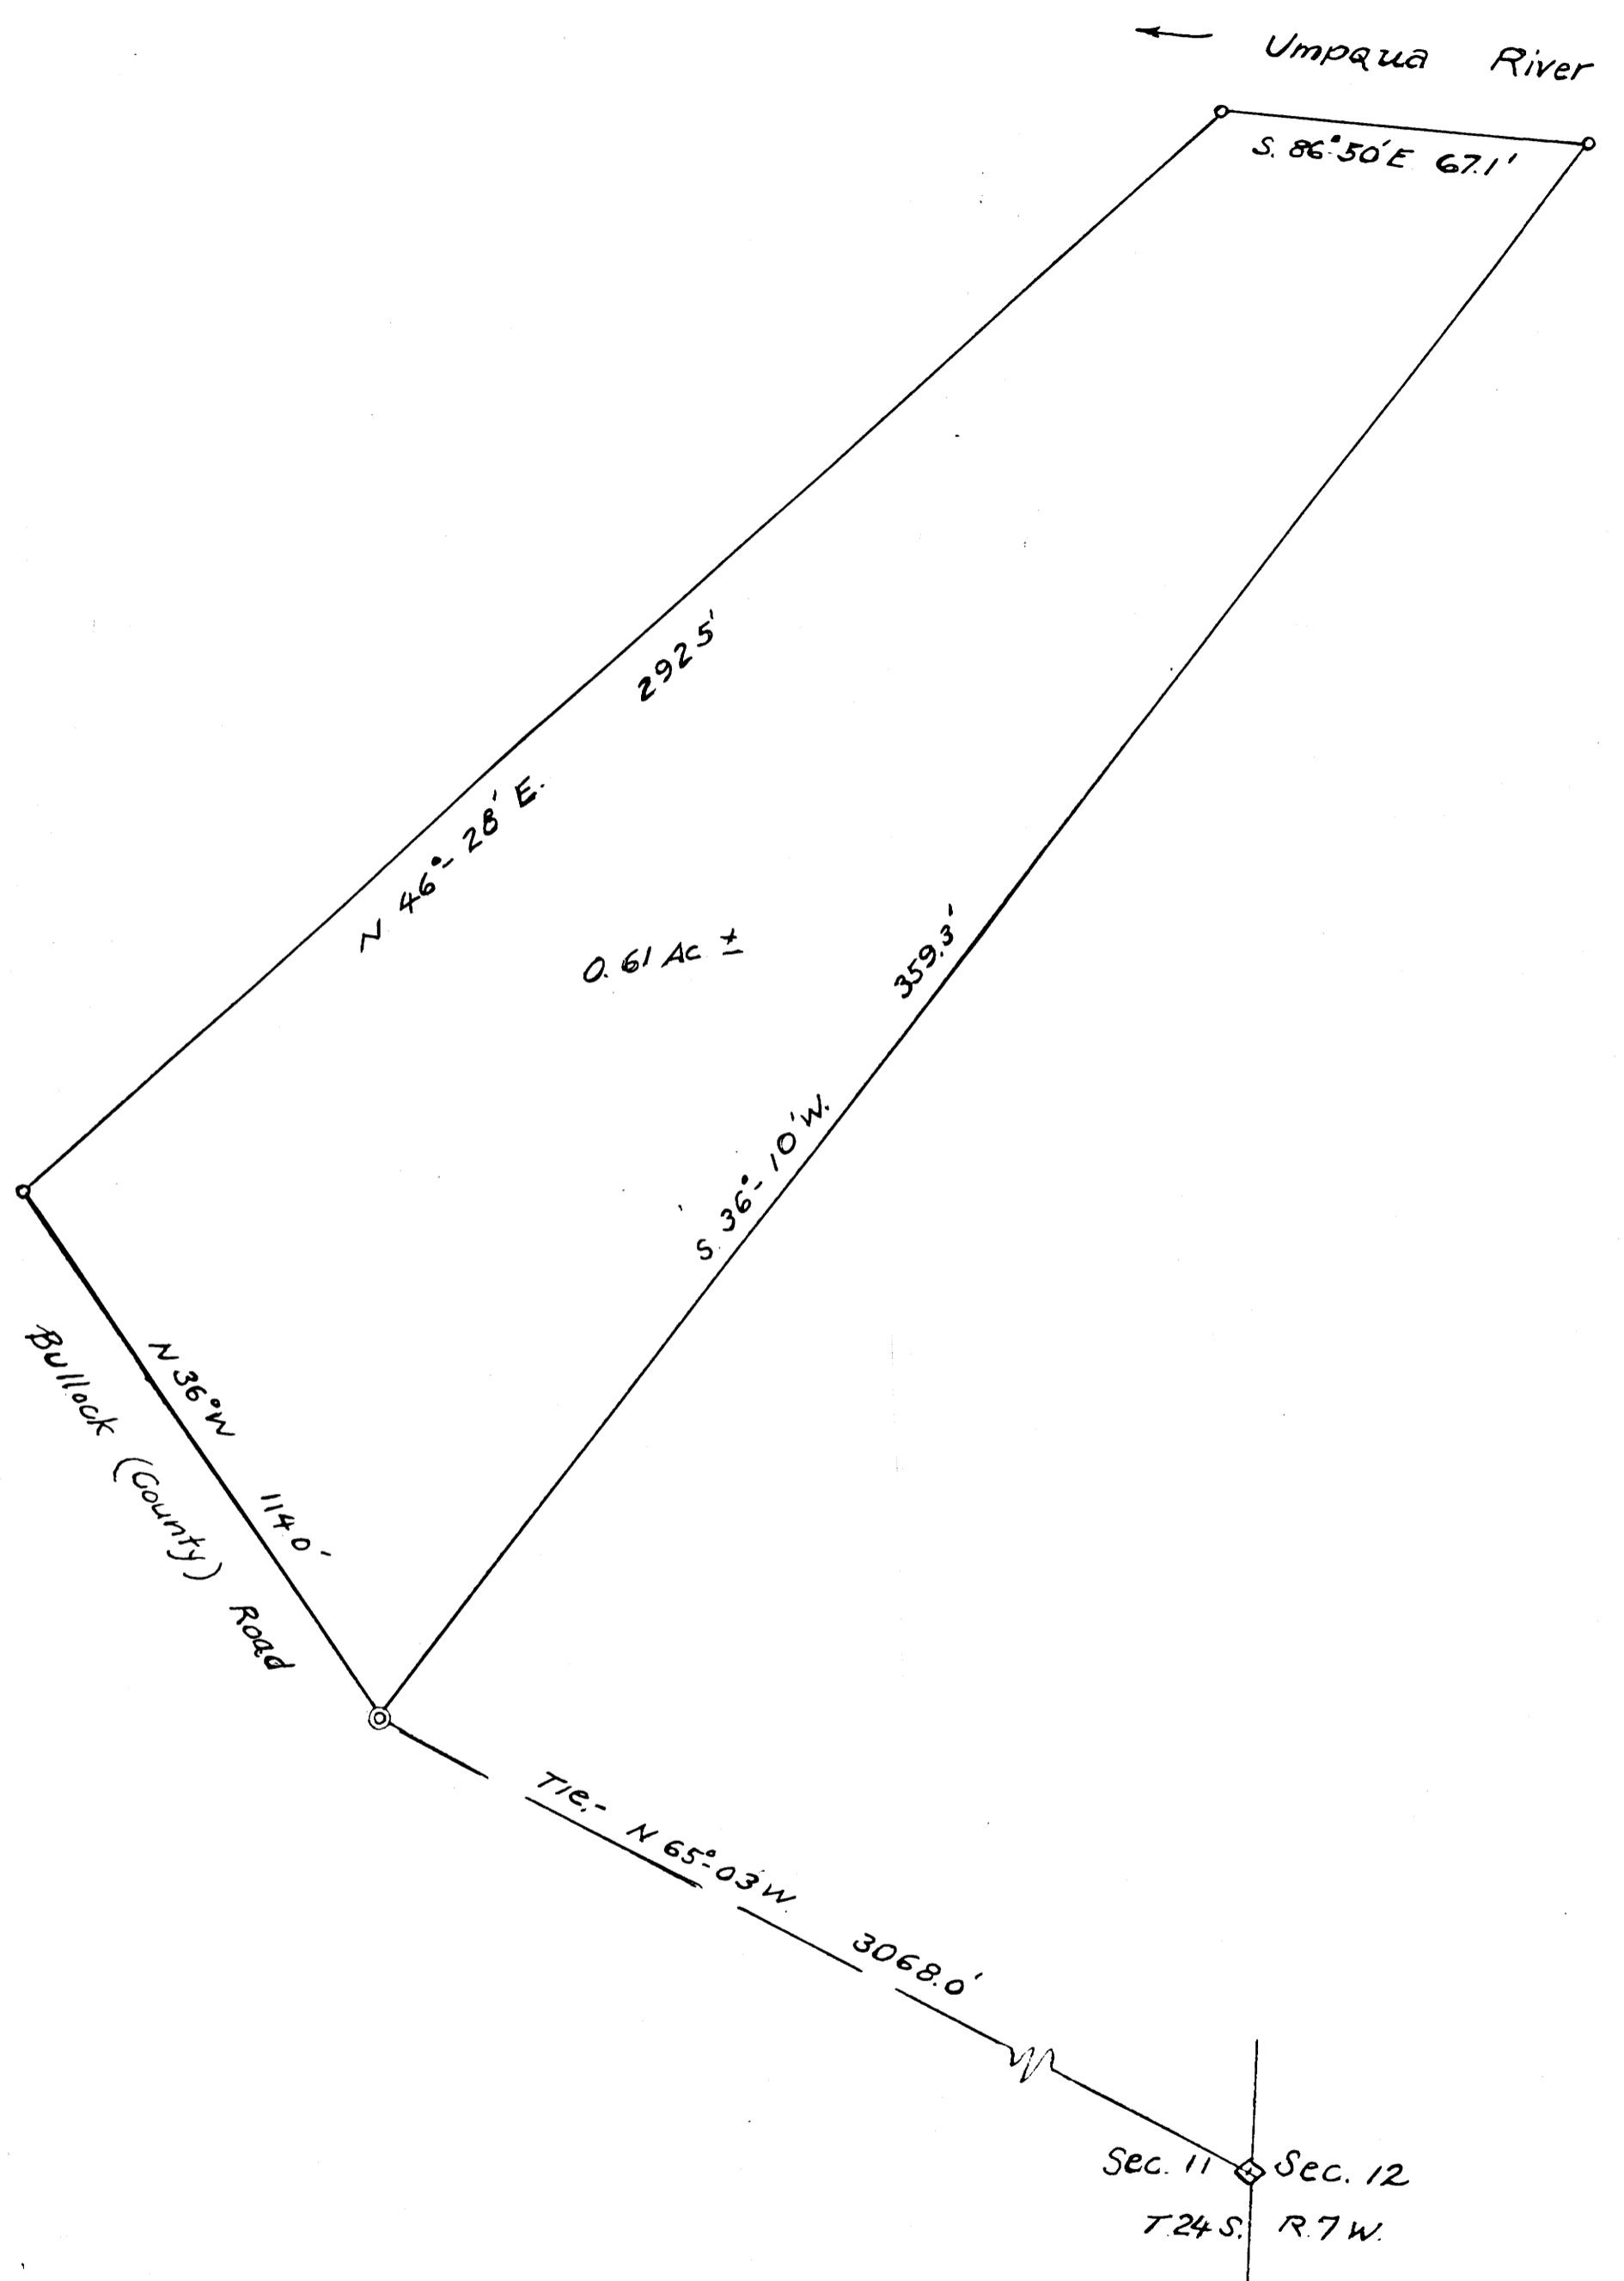

THIS COPY MADE FROM  
A XEROX 2510  
DATE 5-8-89

MILO BULLOCK,  
OAKLAND, OREGON  
0.61 Ac. ± TRACT IN SEC. 11,  
T. 24 S. R. 7 W. WILMER  
MAY, 1959  
1" = 30 FT.  
*Arthur Boyer*

COUNTY SURVEYORS FILE  
DO NOT REMOVE FROM OFFICE

FILED  
RECEIVED  
JUN 2 1959  
COUNTY SURVEYOR  
DEUSHAUS COUNTY OFFICE

MAP FILE M 14-74