

COUNTY SURVEYORS FILE DATA
DO NOT REMOVE FROM OFFICE

SURVEY FOR DEED DESCRIPTION SEC. 33, T. 30 S., R. 2 W., W. M.


SURVEYED FOR: G. M. McDERMOTT

JUNE, 1959

SURVEYED BY: G. R. LECKLIDER - ENG'R.

SCALE: 1" = 30'

- DENOTES CORNER FOUND
- DENOTES 1/2" IRON ROD SET

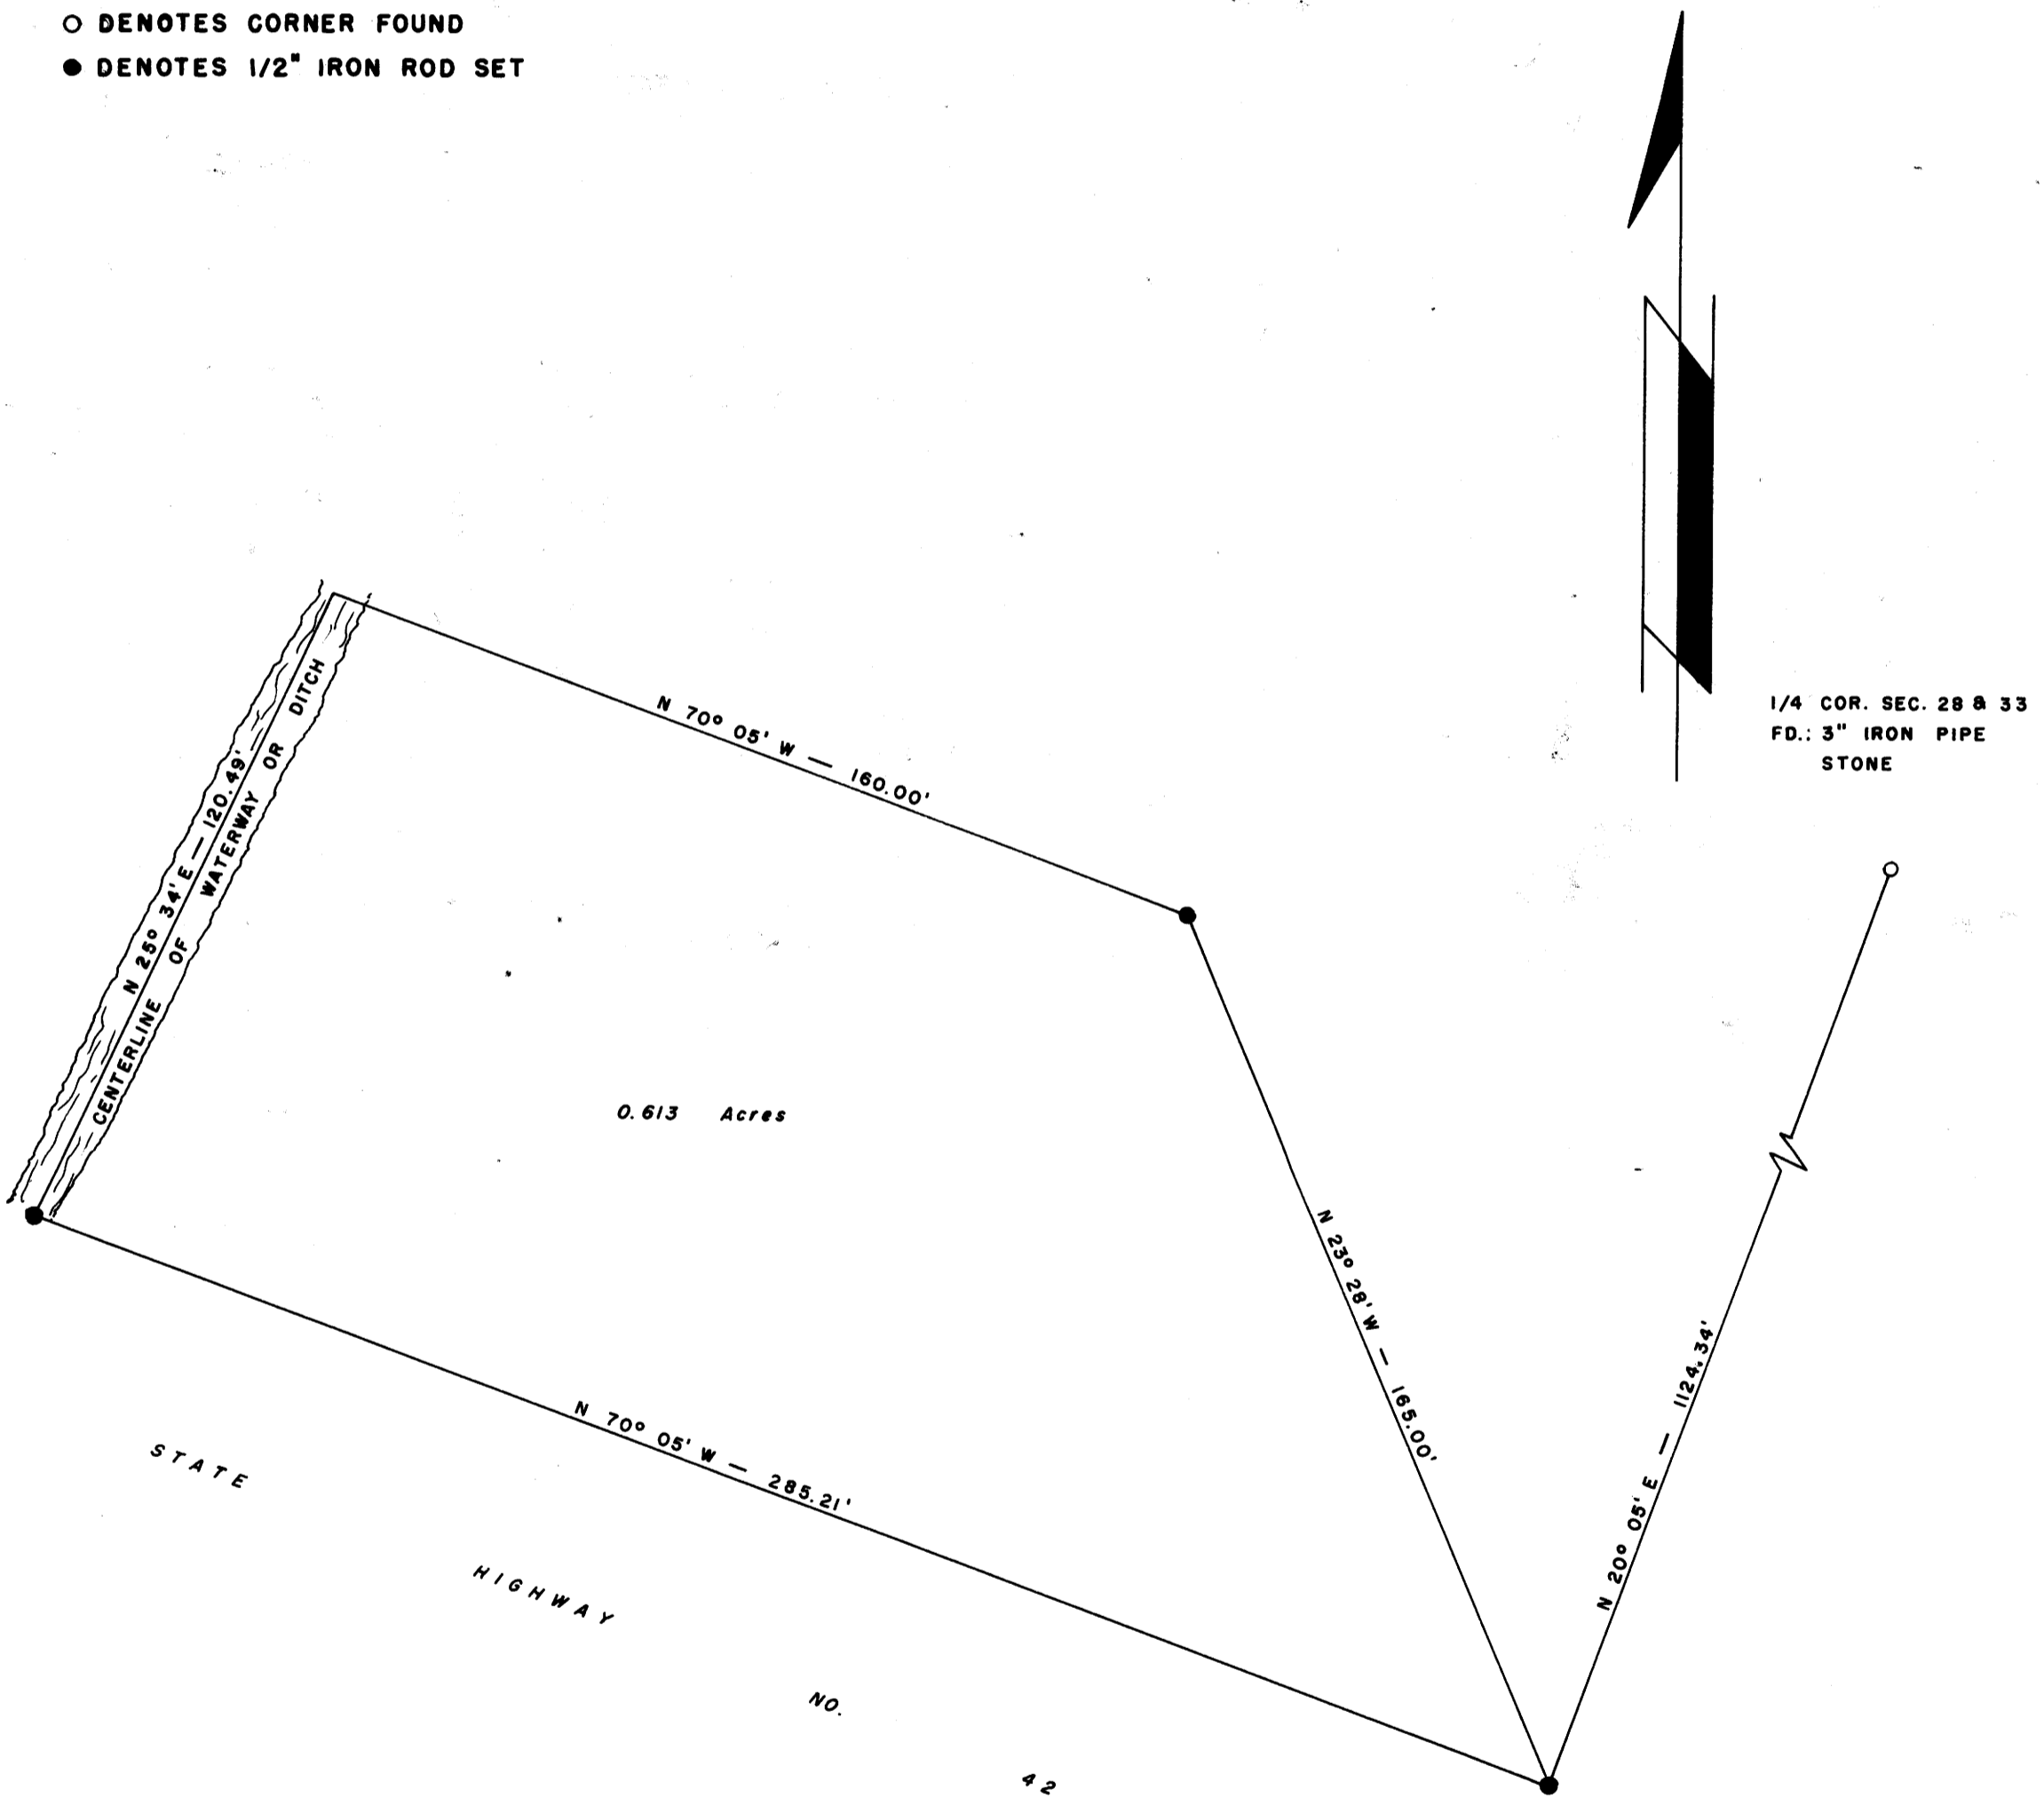

NOTE:
ALL BEARINGS BASED ON SOLAR OBSERVATION

FILED
RECEIVED

JUN 16 1959

COUNTY SURVEYOR
DOUGLAS COUNTY, ORE.

REGISTERED PROFESSIONAL
ENGINEER
1959
G. R. LECKLIDER
DOUGLAS COUNTY, ORE.

G. Robert Lecklider