


12 1/4 CORNER
13

T 22 S. R 6 W

EAST 686.4

EAST 283.92

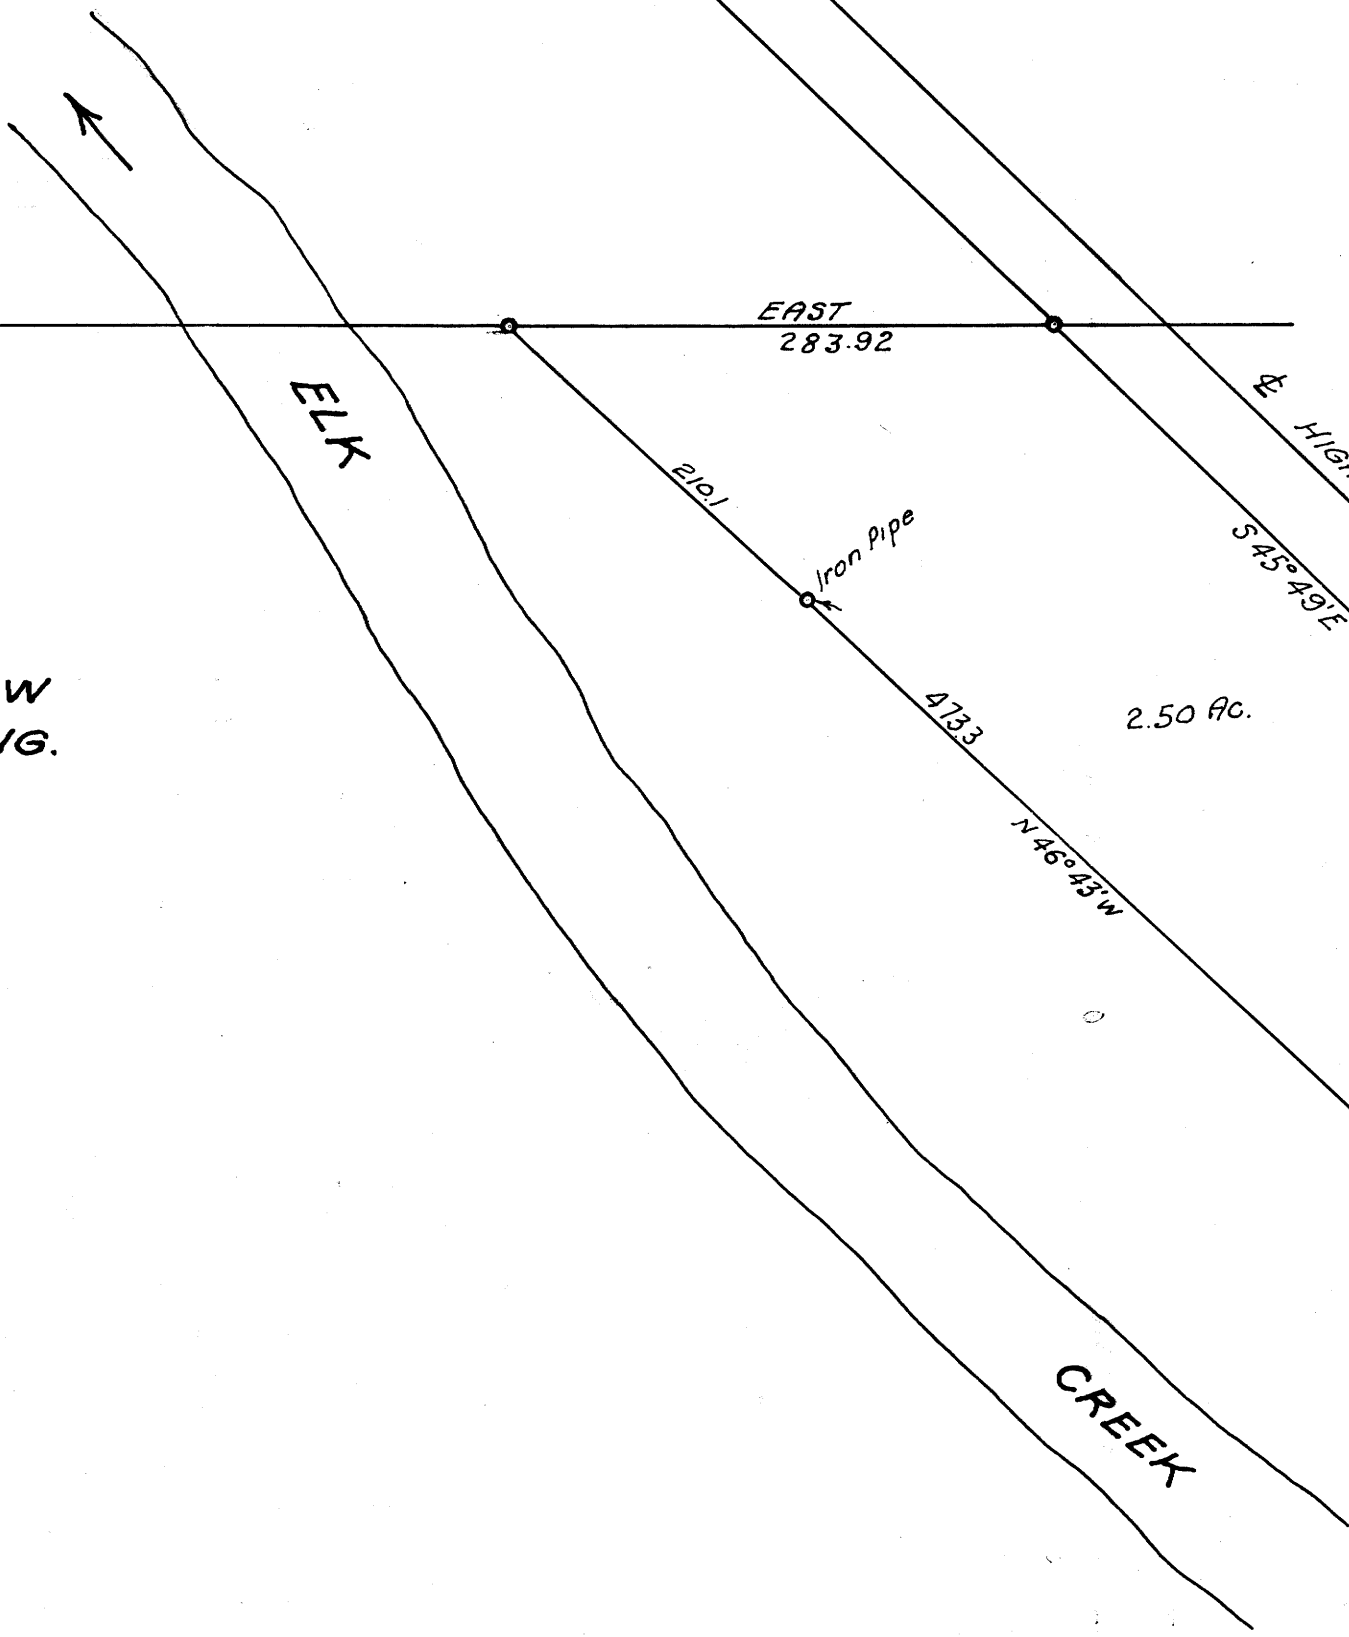

ELROY SMITH
DRAIN OREGON
FEBRUARY 53 FRED L. DOW
SCALE 1"=100' CIV. ENG.

COUNTY SURVEYORS FILE DATA
DO NOT REMOVE FROM OFFICE

2.50 AC.

HIGHWAY No 38

Iron Pipe

210.1

473.3

N 46° 43' W

188.70
S 36° 11' W

CREEK

ELK

Fred
Fred
L.

CHIC.