


COUNTY SURVEYORS FILE DATA  
DO NOT REMOVE FROM OFFICE

MAP  
SHOWING LANDS SURVEYED.  
IN  
LOTS 2-3 BLOCK-1  
GLENARY FRUIT LANDS  
SCALE-1"=100'

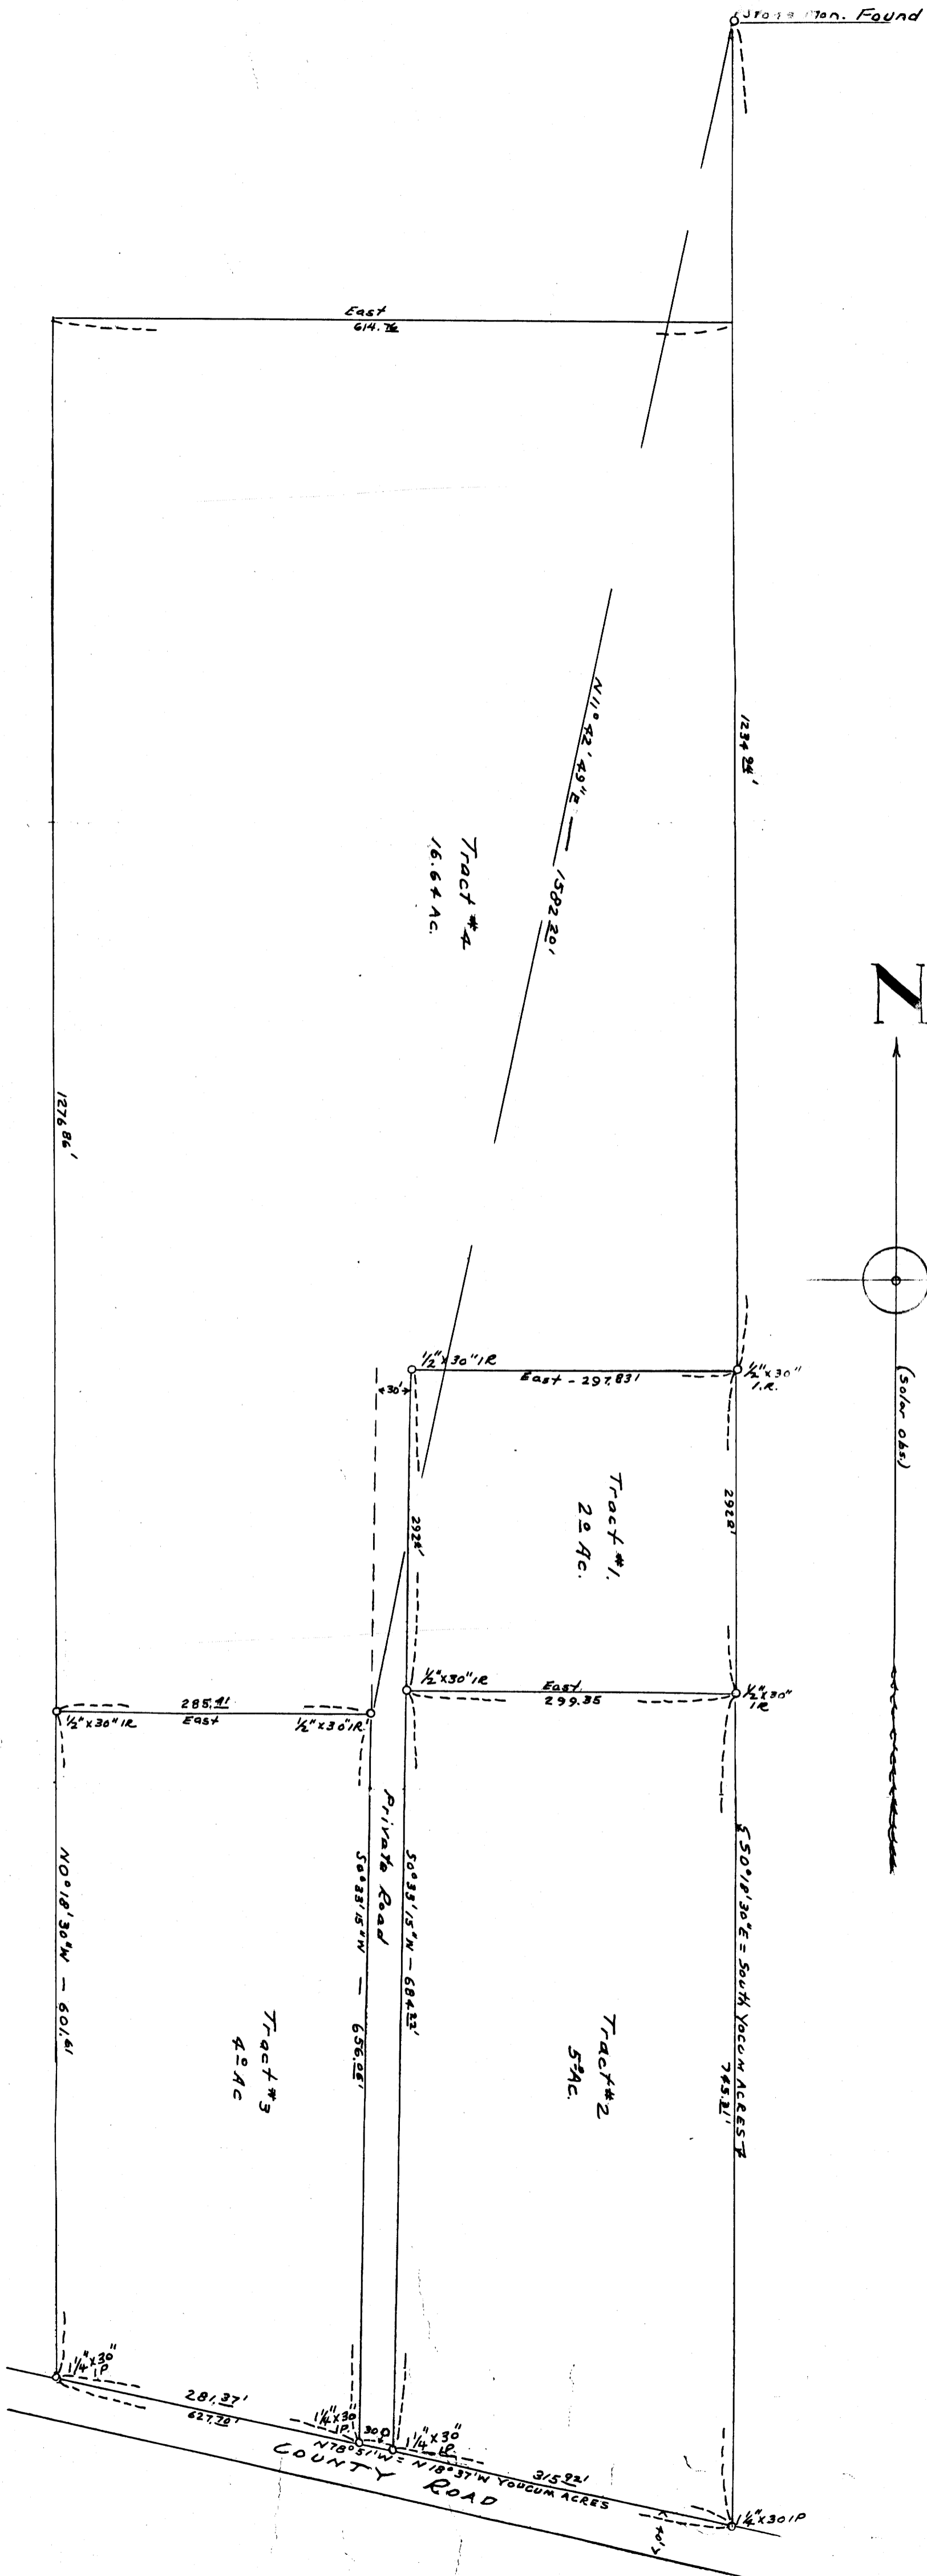

THIS COPY MADE FROM  
A XEROX 2510  
DATE \_\_\_\_\_

*Edwin J. Bradford*