


5 4
1/4 Cor. - Fd. 2 old B.T. stumps
Set I.P. - mkd new B.T.s
18" Fir - N63°W 28.6
16" Fir - N88°E 29.0

663.93

3
1/4 Cor. - Set 1/2" x 30" I. Rod.
3" x 3" x 30" post alongside
West
Set points to define line

N0°37'E 1327.86
663.93

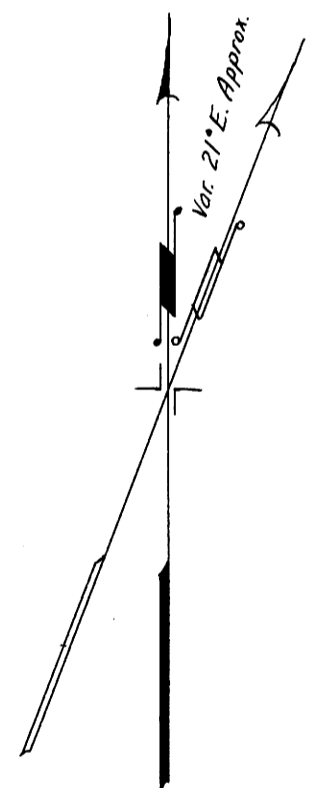

20
S.W. Cor. Lot 66 - Eden Orchards
Fd. 1" x 30" I.P.
Dedicated Road
Fd. I.P.



COUNTY SURVEYOR'S OFFICE
DOUGLAS COUNTY, OREGON
SURVEY TO ESTABLISH N.E. CORNER
OF S.E. 1/4, S.E. 1/4, SEC. 5, T27S., R7W.
BEN. B. IRVING COUNTY SURVEYOR
SURVEYED DEC. 20, 1948. SCALE 1"=100'

COUNTY SURVEYORS FILE NO.
DO NOT REMOVE FROM FILE