


Fd. Rock, N.W.  
Cor. Roberts  
D.L.C. No. 46

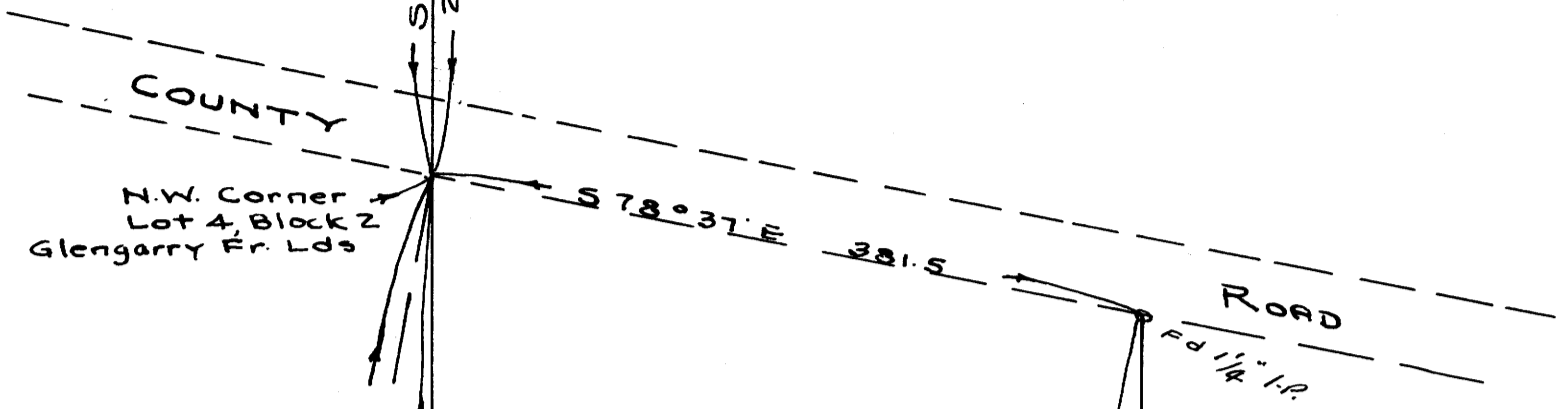

N.W. Corner  
Lot 4, Block 2  
Glengarry Fr. Lds

GLENGARRY FRUIT LANDS

817.2  
906.6

BLOCK

LOT 3

LOT 4


LOT 5

N 100° 19' E

South

1009.5

South

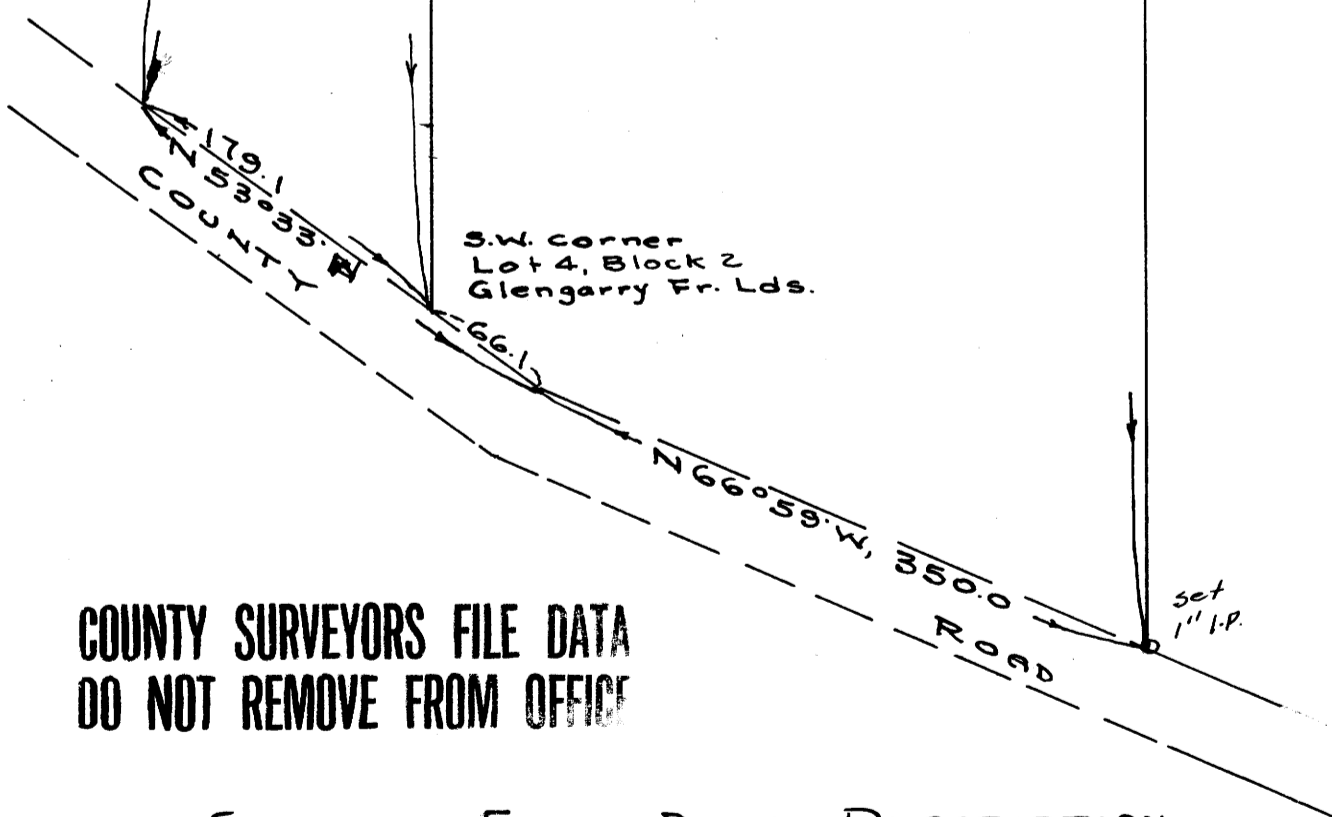

S.W. Corner  
Lot 4, Block 2  
Glengarry Fr. Lds.

COUNTY SURVEYORS FILE DATA  
DO NOT REMOVE FROM OFFICE

SURVEY FOR DEED DESCRIPTION  
IN LOT 3 BLOCK 2  
GLENGARRY FRUIT LANDS  
D.L.C. No. 47, T285, R6W WM.

SURVEYED AND PLATTED, AUGUST 1952  
BY A.R. EVANS CIVIL ENGINEER  
ROSEBURG, ORE.

SCALE 1" = 100'

41-106

C.S File 41-1106

Map File M.15+8

