




○ = Pipe found
⊗ = 1/4" x 30" Pipe set

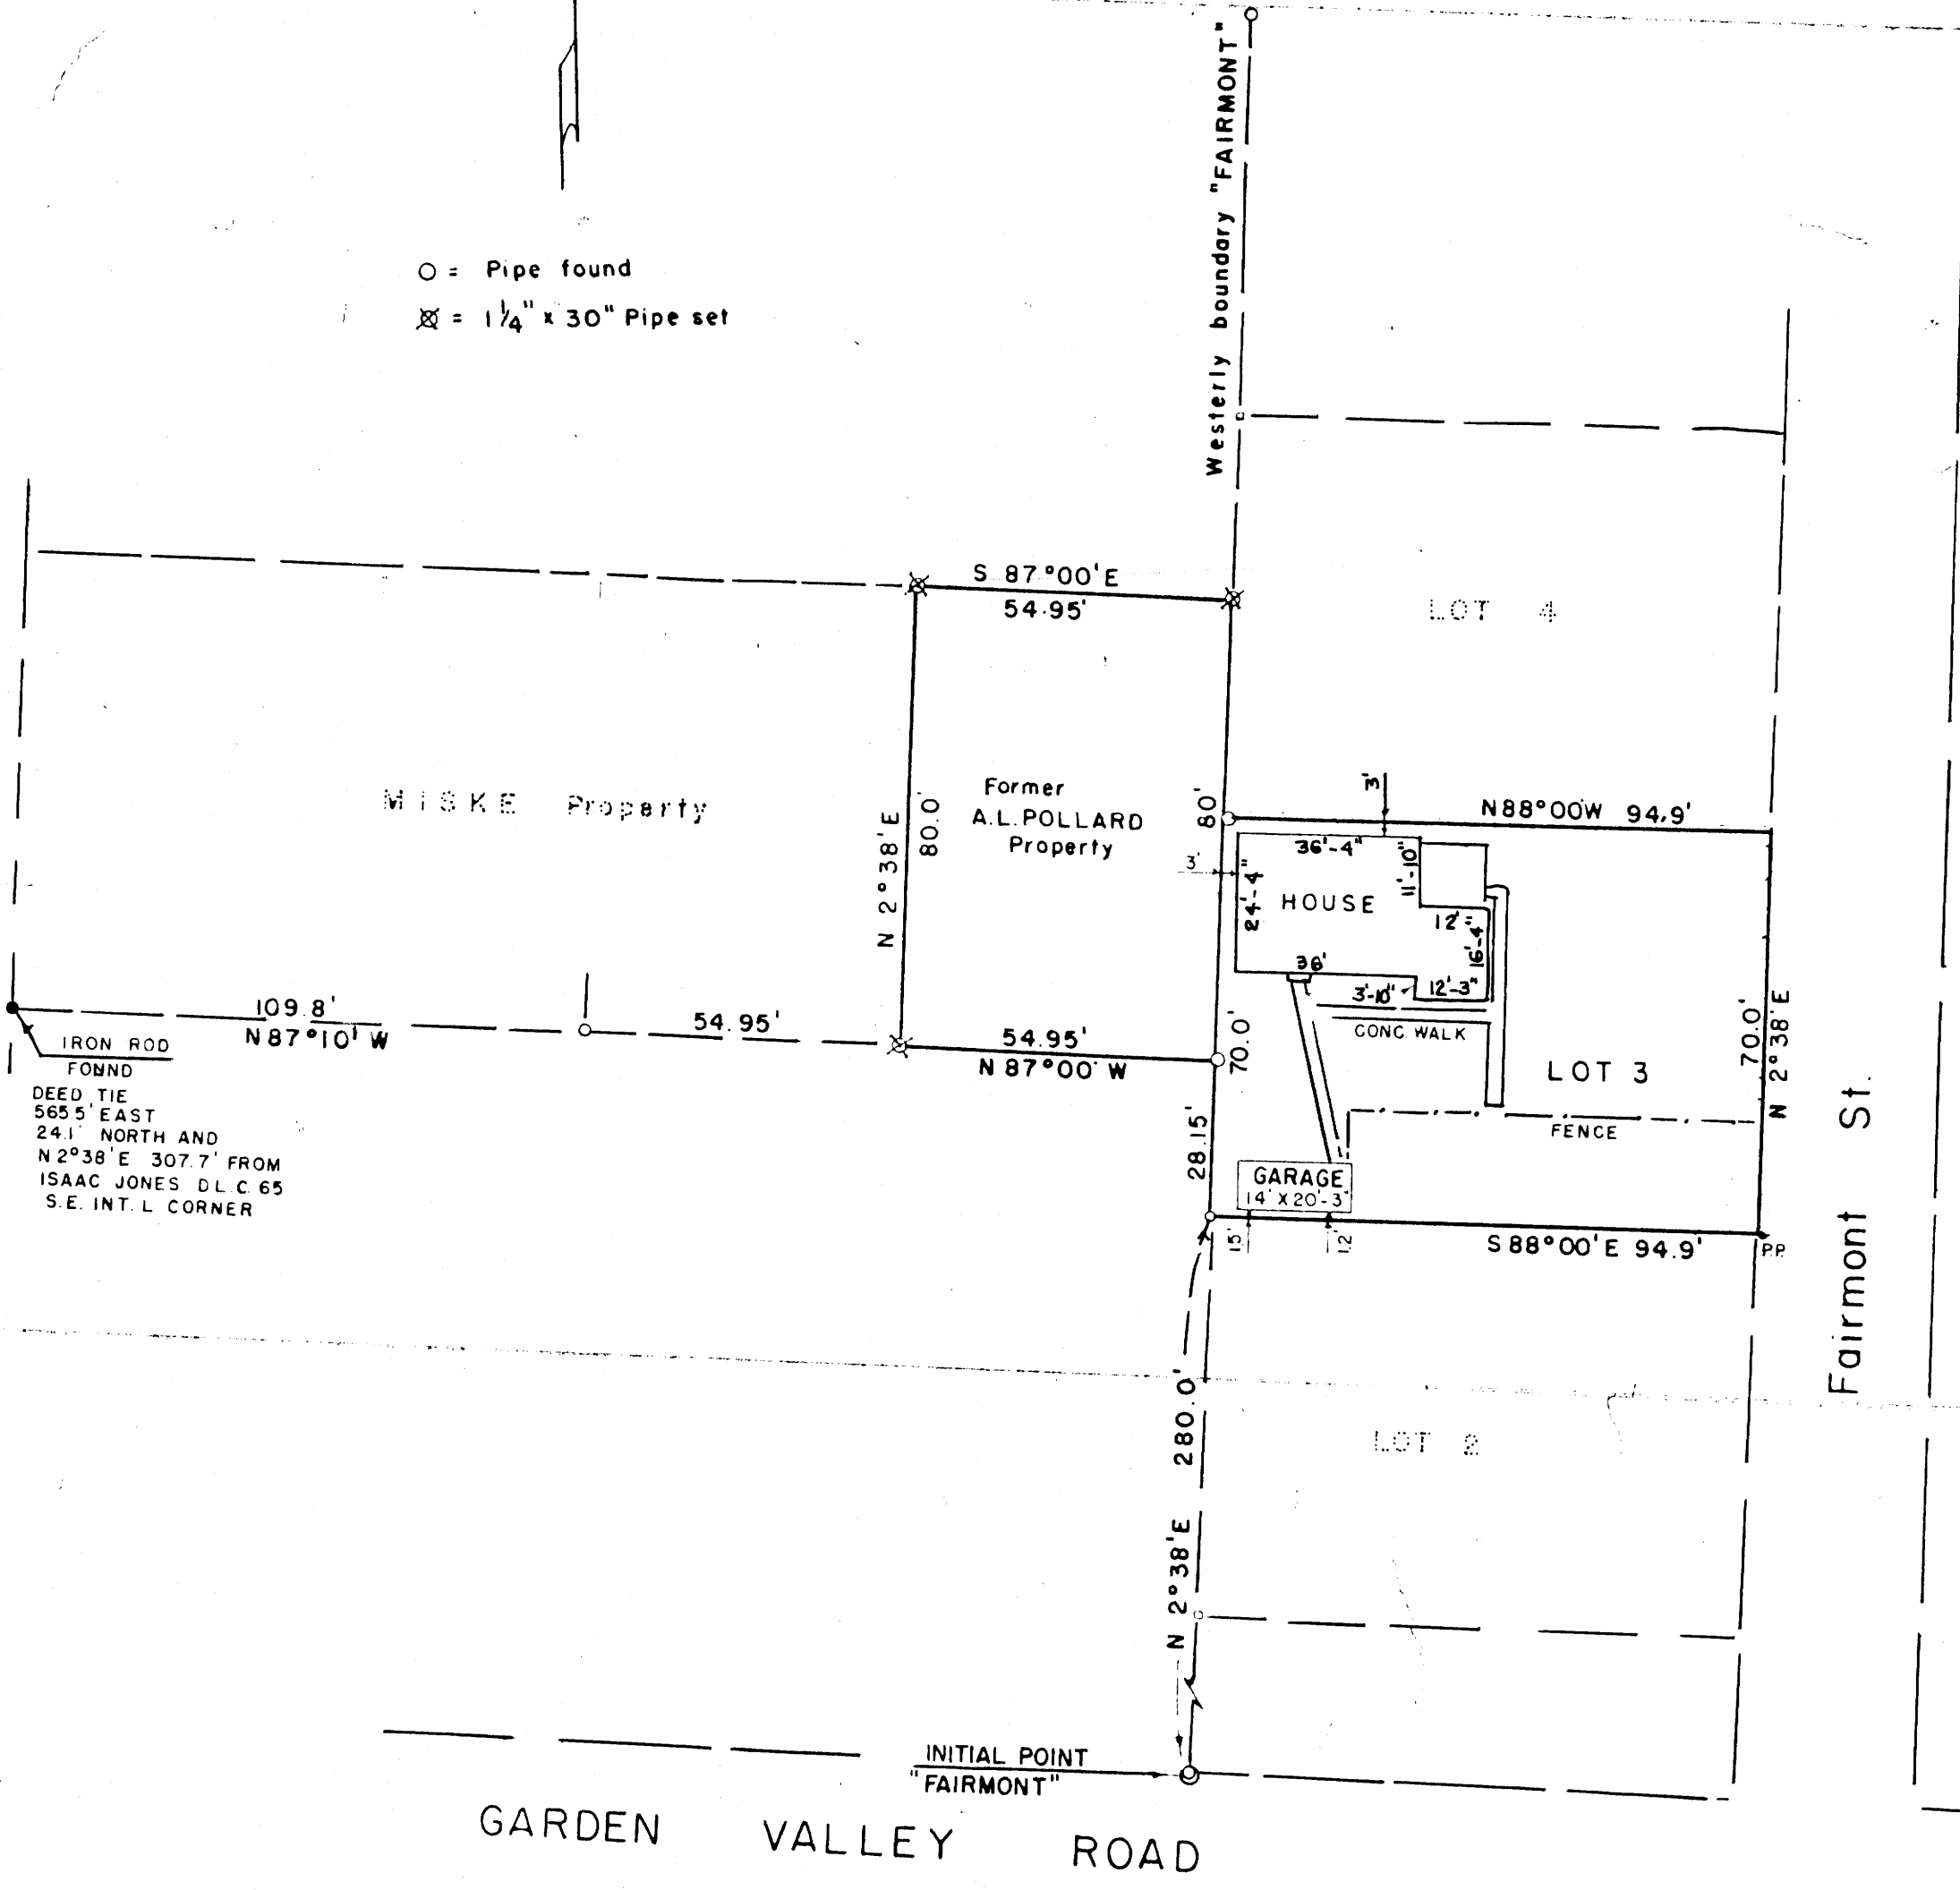

DEED TIE
565.5' EAST
24.1' NORTH AND
N 2°38' E 307.7' FROM
ISAAC JONES DL C 65
S.E. INT. L CORNER

PLAT OF
THOS. H. HAIRE Property
In and adjacent to "FAIRMONT"

ROSEBURG, OREGON
March 1954 Scale 1" = 30'

FILED
RECEIVED
DEC 30 1955
COUNTY SURVEYOR

COUNTY SURVEYORS FILE
DO NOT REMOVE FROM OFFICE

THIS COPY MADE FROM
A XEROX 2510
DATE 6-7-89

Sec. 13, T27S, R6W