
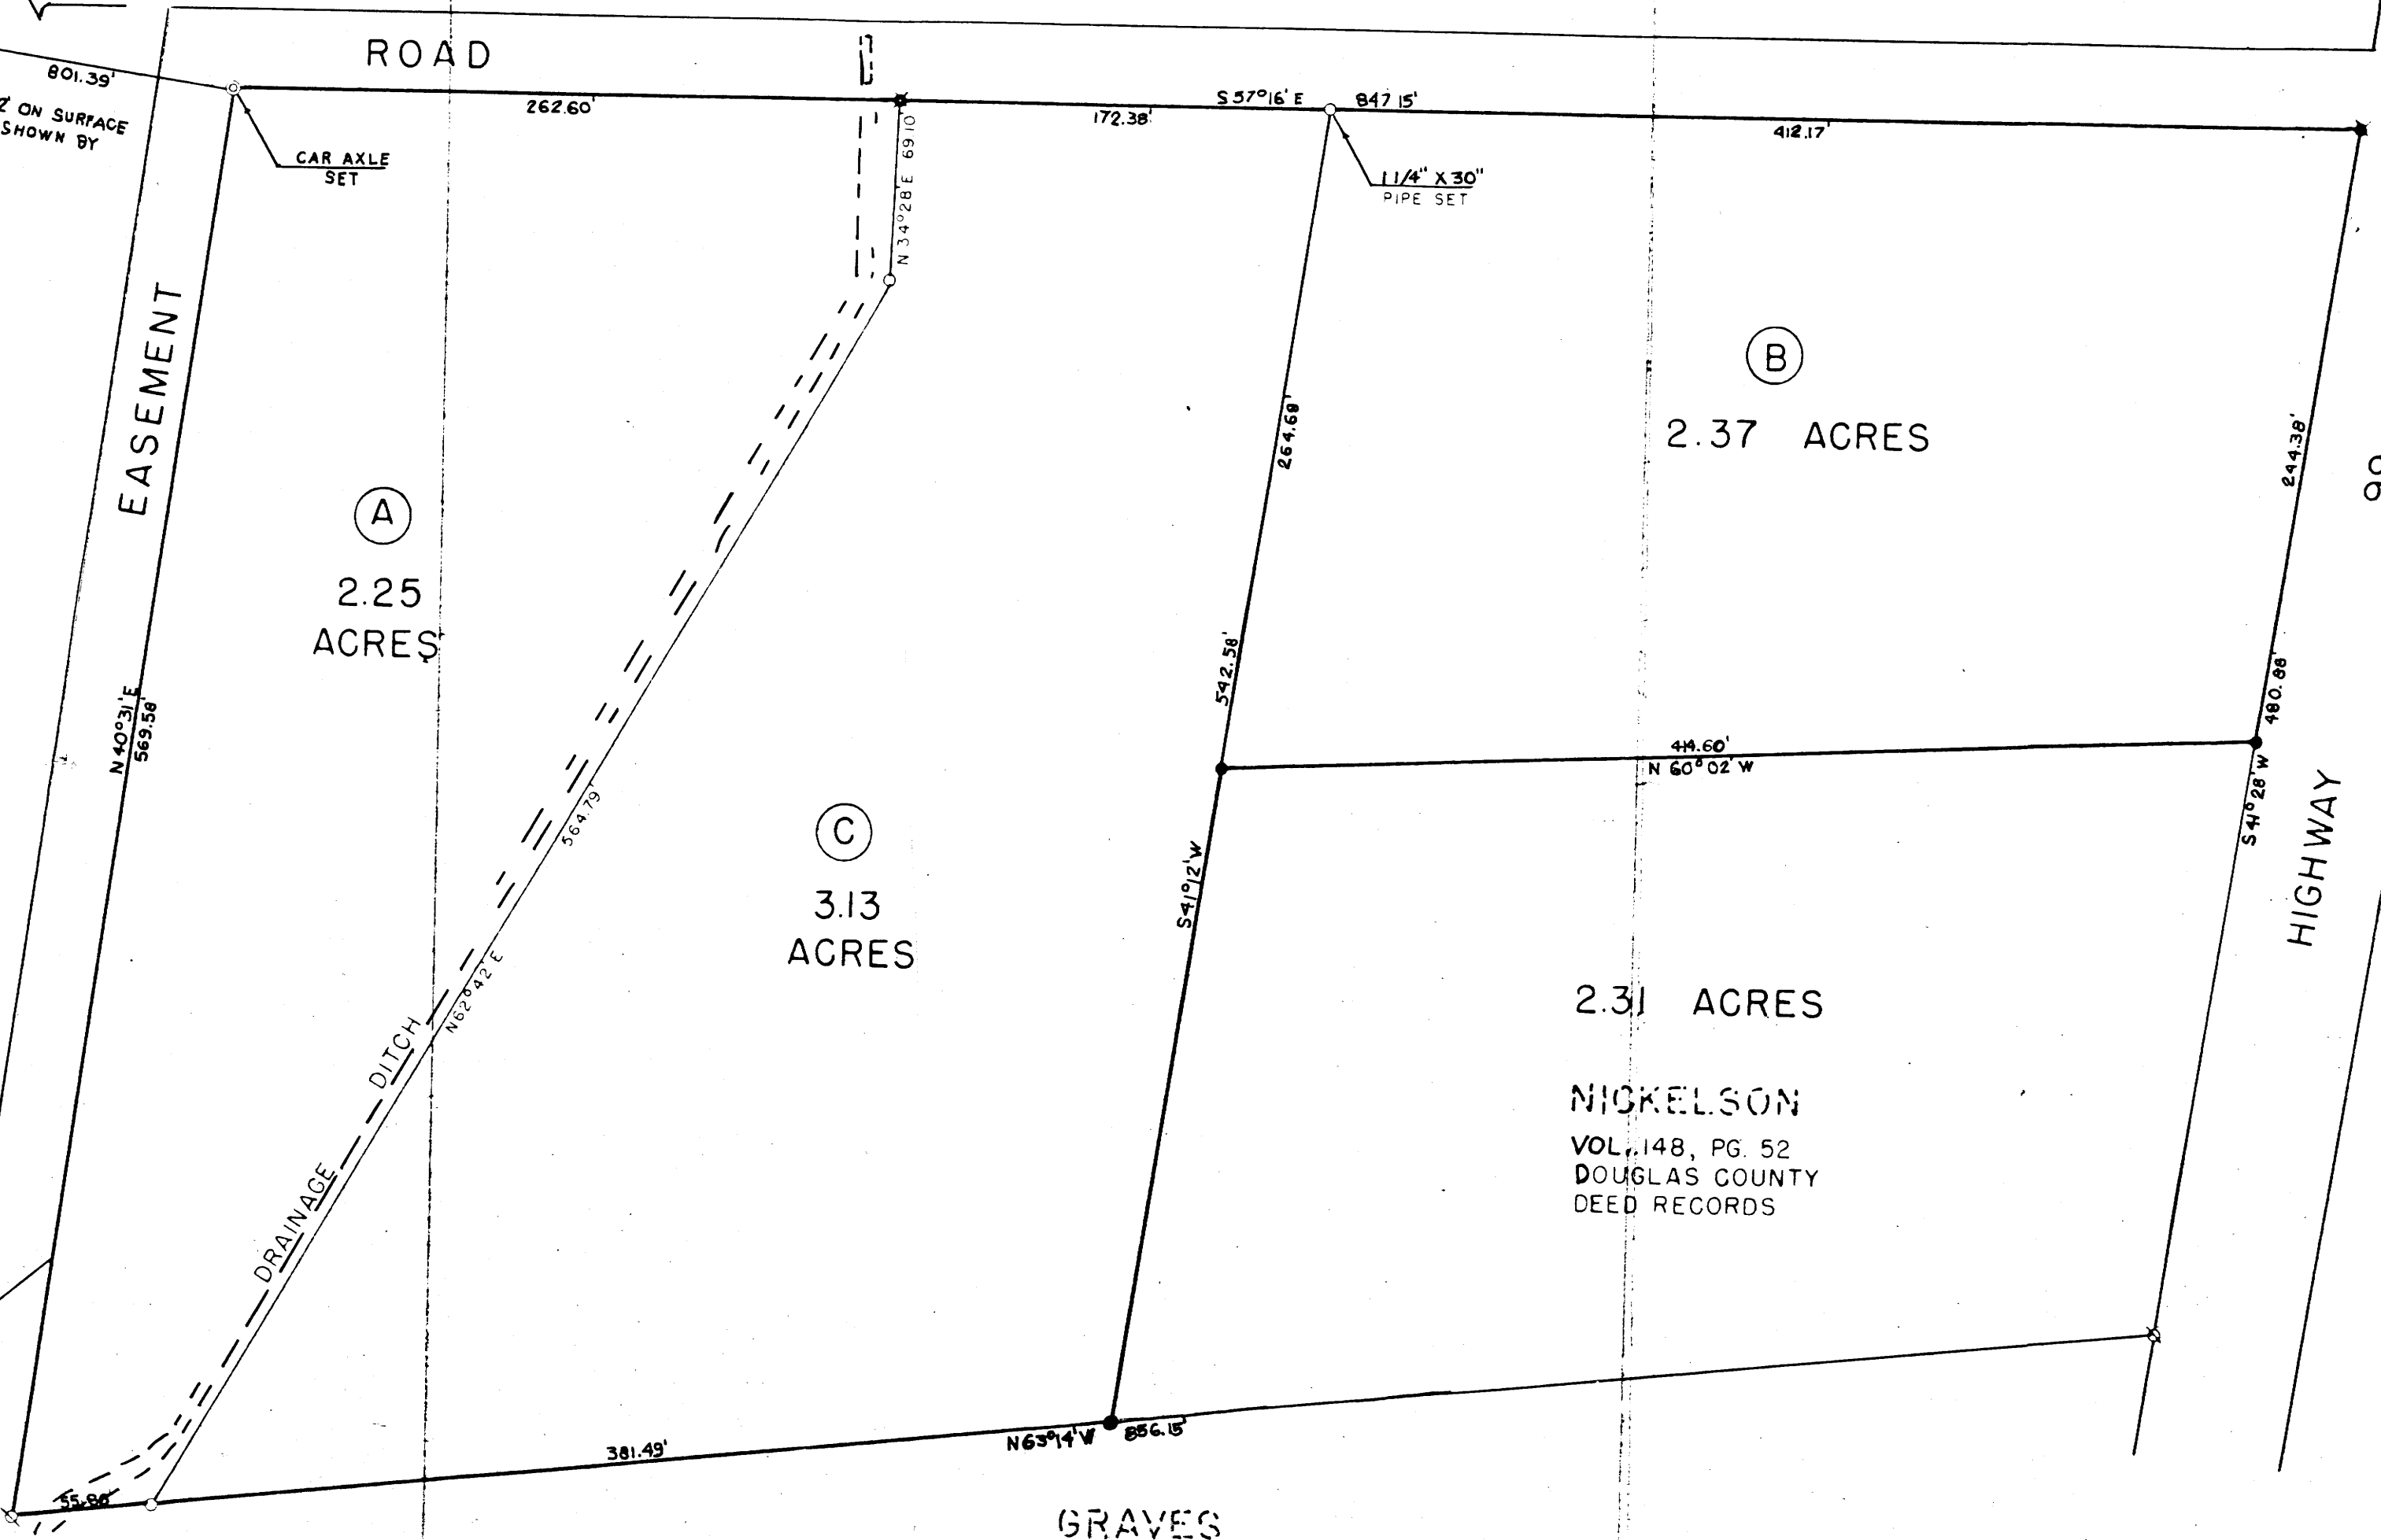


FILED
RECEIVED
DEC 30 1955
COUNTY SURVEYOR
DOUGLAS COUNTY, ORE

FISK FRUIT FARMS

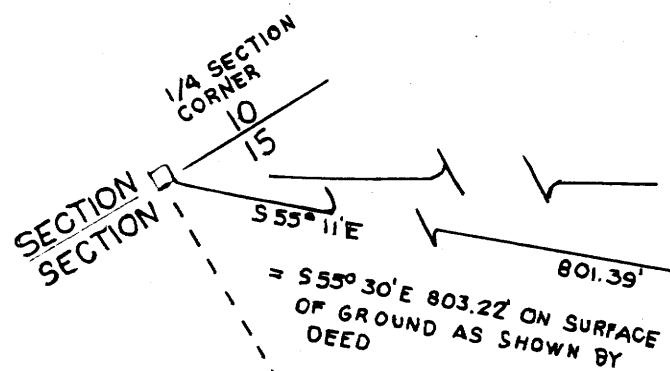

GARRICK

- 5/8" x 24" IRON ROD SET
- || 5/8" x 30" IRON ROD SET
- || 1 1/4" x 24" PIPE SET
- || PIPE FOUND

Percy C. Armstrong

DATE 6-7-89
THIS COPY MADE FROM
A XEROX 2510

PLAT OF
JOHN S. HARP PROPERTY

N SECTION 15, T28S, R6W, W.M. - DOUGLAS COUNTY, OREGON
OCTOBER, 1951

SCALE 1"=60'

COUNTY SURVEYORS FILE
DO NOT REMOVE FROM OFFICE

C.S. File 42/52