
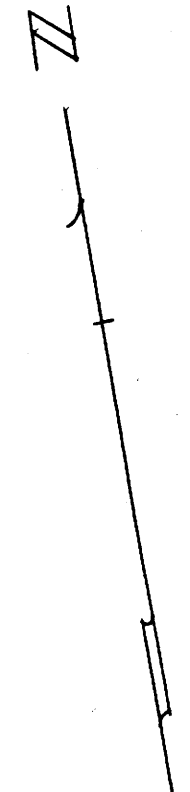


C.S. 42/57  
M16-18

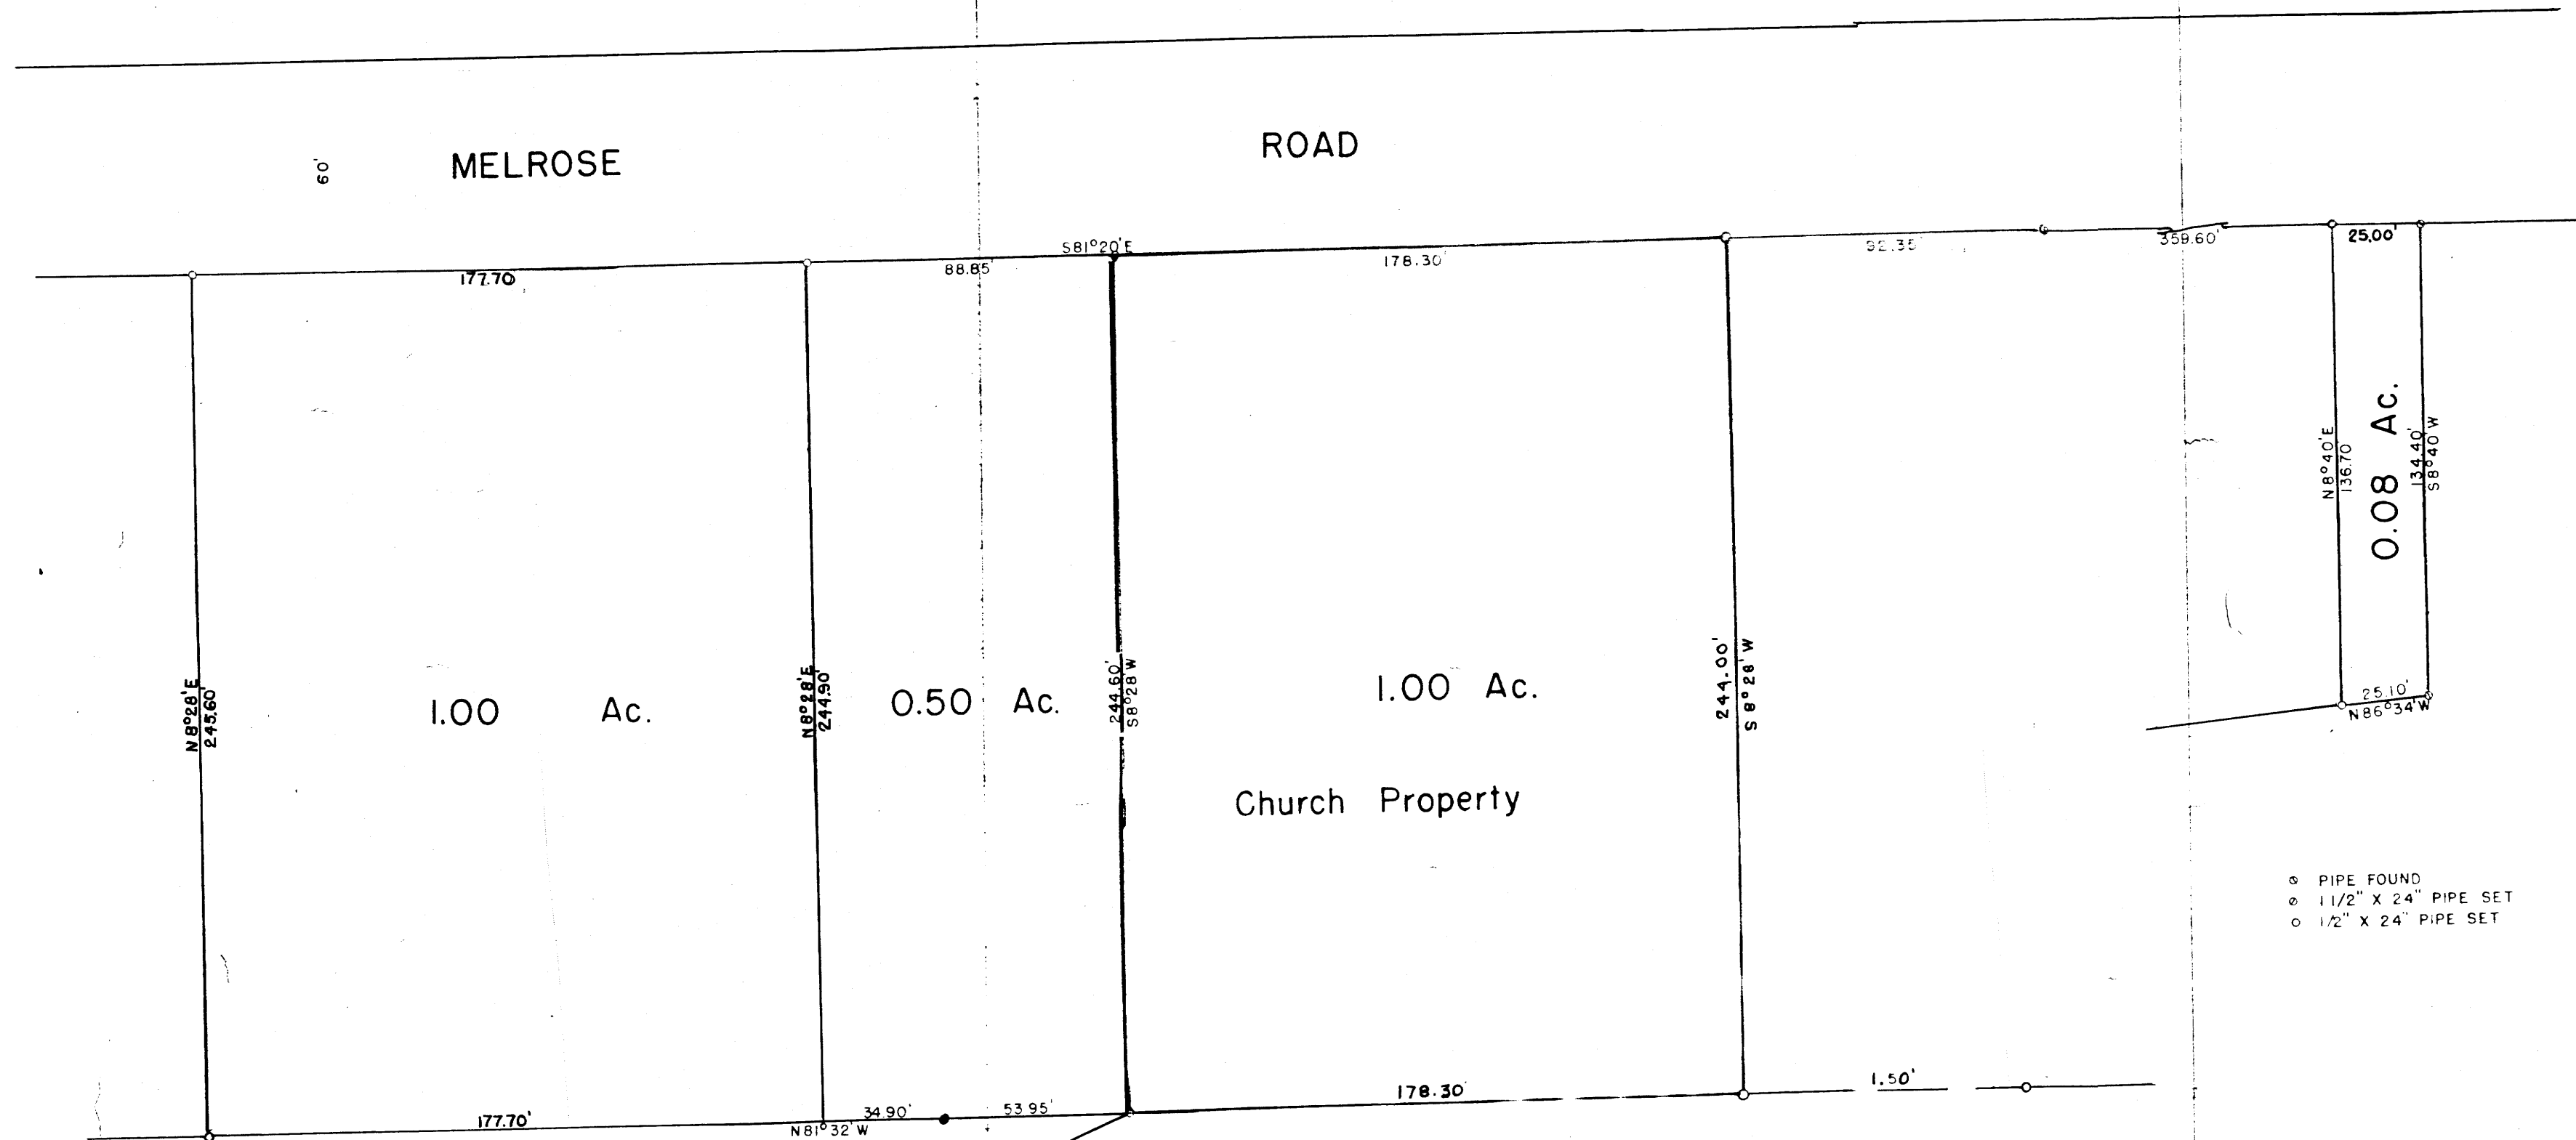

- o PIPE FOUND
- o 1 1/2" X 24" PIPE SET
- o 1/2" X 24" PIPE SET

**COUNTY SURVEYORS FILE**  
**DO NOT REMOVE FROM OFFICE**

PLAT OF PART OF  
**F. A. WILLIAMS PROPERTY**  
IN SECTION 6, T27S, R6W, W.M., DOUGLAS COUNTY, OREGON  
JUNE, 1952 SCALE 4" = 40'  
REVISED JUNE, 1954 TO SHOW "THUR" PROPERTY

*Ferry O. Armstrong*

THIS COPY MADE FROM  
A XEROX 2510  
DATE 6-7-89

C.S. 42/57  
M16-18

FILED  
RECEIVED  
DEC 30 1955  
COUNTY SURVEYOR

C.S. File 42/57