

Found 1" iron pipe

4 3

Sections 3+4, T. 23 S., R. 7 W., W.M.

Scale 1" = 500 ft.

Dec. 1955

For Ed. JONES

The purpose of this survey was to set the 1/4 Cor. Sects. 3+4.

The survey was started at the cor. sects. 3, 4, 9, 10, a 3/4" iron pipe set by BAKER. we went North (starting with a mag. var. N21°E.) on a TRAVERS to the closing corners of sections 3+4 which is a 1 inch iron pipe with 3 B.Ts

- 36" fir S28°W. 180.0 FT.
- 24" Laurel S47°W 63.0 FT.
- 20" fir S26°E 55.0 FT

The 1/4 Sect, Cor. and The South 1/6 Cor. was set by offsets from this TRAVERS

COUNTY SURVEYORS WILL DO NOT REMOVE FROM

Set A 36" Angle iron with a BRASS CAP MARKED SURVEY POINT
 Wilford N. Haines
 for 1/4 Cor. MARKED
 A 16" fir S32°35'W. 43.2'
 A 14" fir N73°30'E. 44.6'

N. 00° 08' E.

2609.0

1299.3


Set A 36" Angle iron with a BRASS CAP MARKED SURVEY POINT
 Wilford N. Haines
 MARKED
 A. 16" fir S66°35'W. 40.6 ft
 A 30" fir N28°30'W. 26.5 ft.

1/6

1299.3

Found 3/4 inch iron pipe

4 3
9 10

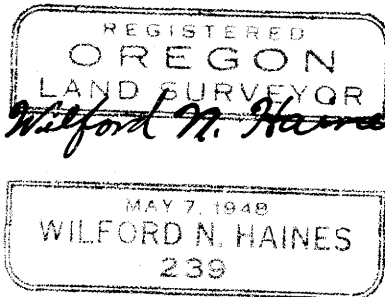

FILED RECEIVED

JAN 6 1956

COUNTY SURVEYOR DOUGLAS COUNTY, ORE.

C. S. File No. 42/84

C.S. File 42/84

Map File M/6-23