


1/4 SEC. COR.
SECS. 23 & 24
N 68°23'W
8'80.521°38'E 130'
14'80.578°27'W 95'



COPCO SUBSTATION SITE
VOL 91, PAGE 346 DEED REC.
VOL 86, PAGE 397

5 Acres ±

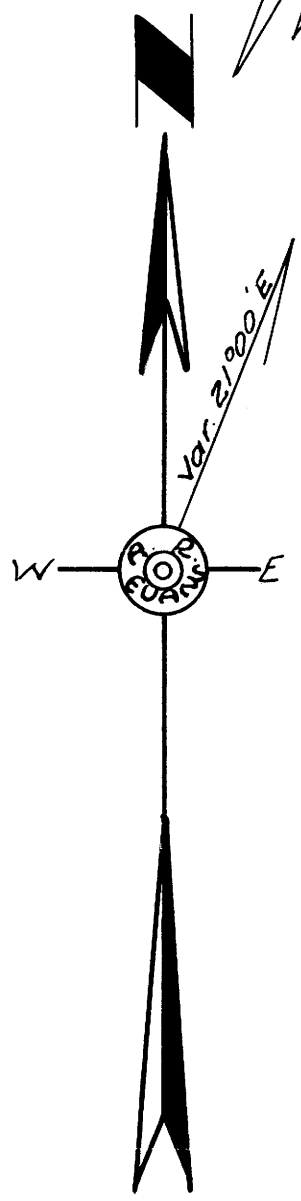

**COUNTY SURVEYOR'S OFFICE
DOUGLAS COUNTY OREGON
SURVEY FOR DEED DESCRIPTION
SECTION 24, T27S., R5W. W.M.**
BEN B. IRVING COUNTY SURVEYOR
SURVEYED 12-1-47, BY A. R. EVANS
SCALE 1" = 100'

COUNTY SURVEYORS FILE DATA
DO NOT REMOVE FROM OFFICE