




Scale 1" = 60'

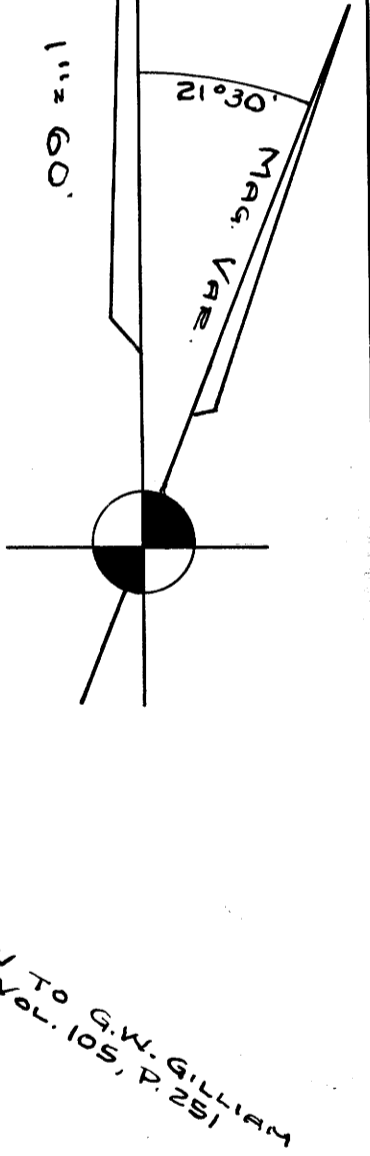

PACIFIC
(U.S. 99)

N 6°02' E

6350

HIGHWAY

SOUTHERN

S 15°06' W

PACIFIC 6433

R. R.

93.4

EXCEPTION FOR R of W

S 84°08' E, 101.4

50 FT. R/W TO G.W. GILLIAM
DEED REC. VOL. 105, P. 251

BEARINGS ARE TRUE, AND ARE
BASED ON THE ϕ BEARING OF
THE PACIFIC HIGHWAY.

⊙ - INDICATES 3/4" IRON ROD SET IN
CONCRETE.


○ - INDICATES 3/4" IRON ROD SET 6"
BELOW GROUND SURFACE.

COUNTY SURVEYORS OFFICE
DO NOT REMOVE FROM OFFICE

COUNTY SURVEYOR'S OFFICE DOUGLAS COUNTY OREGON SURVEY TO ESTABLISH PROP. COR. SECTION 36, T26S, R6W, WM.

BEN B. IRVING COUNTY SURVEYOR
SURVEYED, AUGUST 28, 1950 BY
N.E. RICHARDSON, DEPUTY

12 FT. R/W. TO DSK'S,
DEED REC. VOL. 157, P. 414.
ALONG EXT. NTH LINE TO HWY.

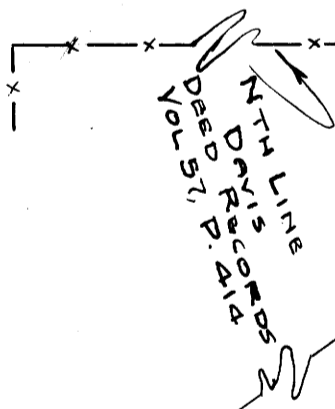

SW COR. JOHN AKIN D.L.C. No. 53.
FD 1/4" IRON SHAFT WITH 6" FLANGE ON TOP. 2 B.T.'S.
8" WHITE OAK, N 45°05' W, 1371 FT.
12" WHITE OAK, S 40°30' W, 803 FT.

REGISTERED
OREGON
LAND SURVEYOR

N.E. Richardson
JULY 7, 1944
N. E. RICHARDSON
35