



COUNTY SURVEYORS FILE DATA
DO NOT REMOVE FROM OFFICE

SURVEY OF SECTION 10, T 26 S, R 2 W, W.M.

SURVEYED FOR: MRS. O.A. MESSING
SURVEYED BY: G. R. LECKLIDER - ENG'R.

DECEMBER, 1959
SCALE: 1" = 500'

NOTE: ALL BEARINGS BASED ON SOLAR OBSERVATION.

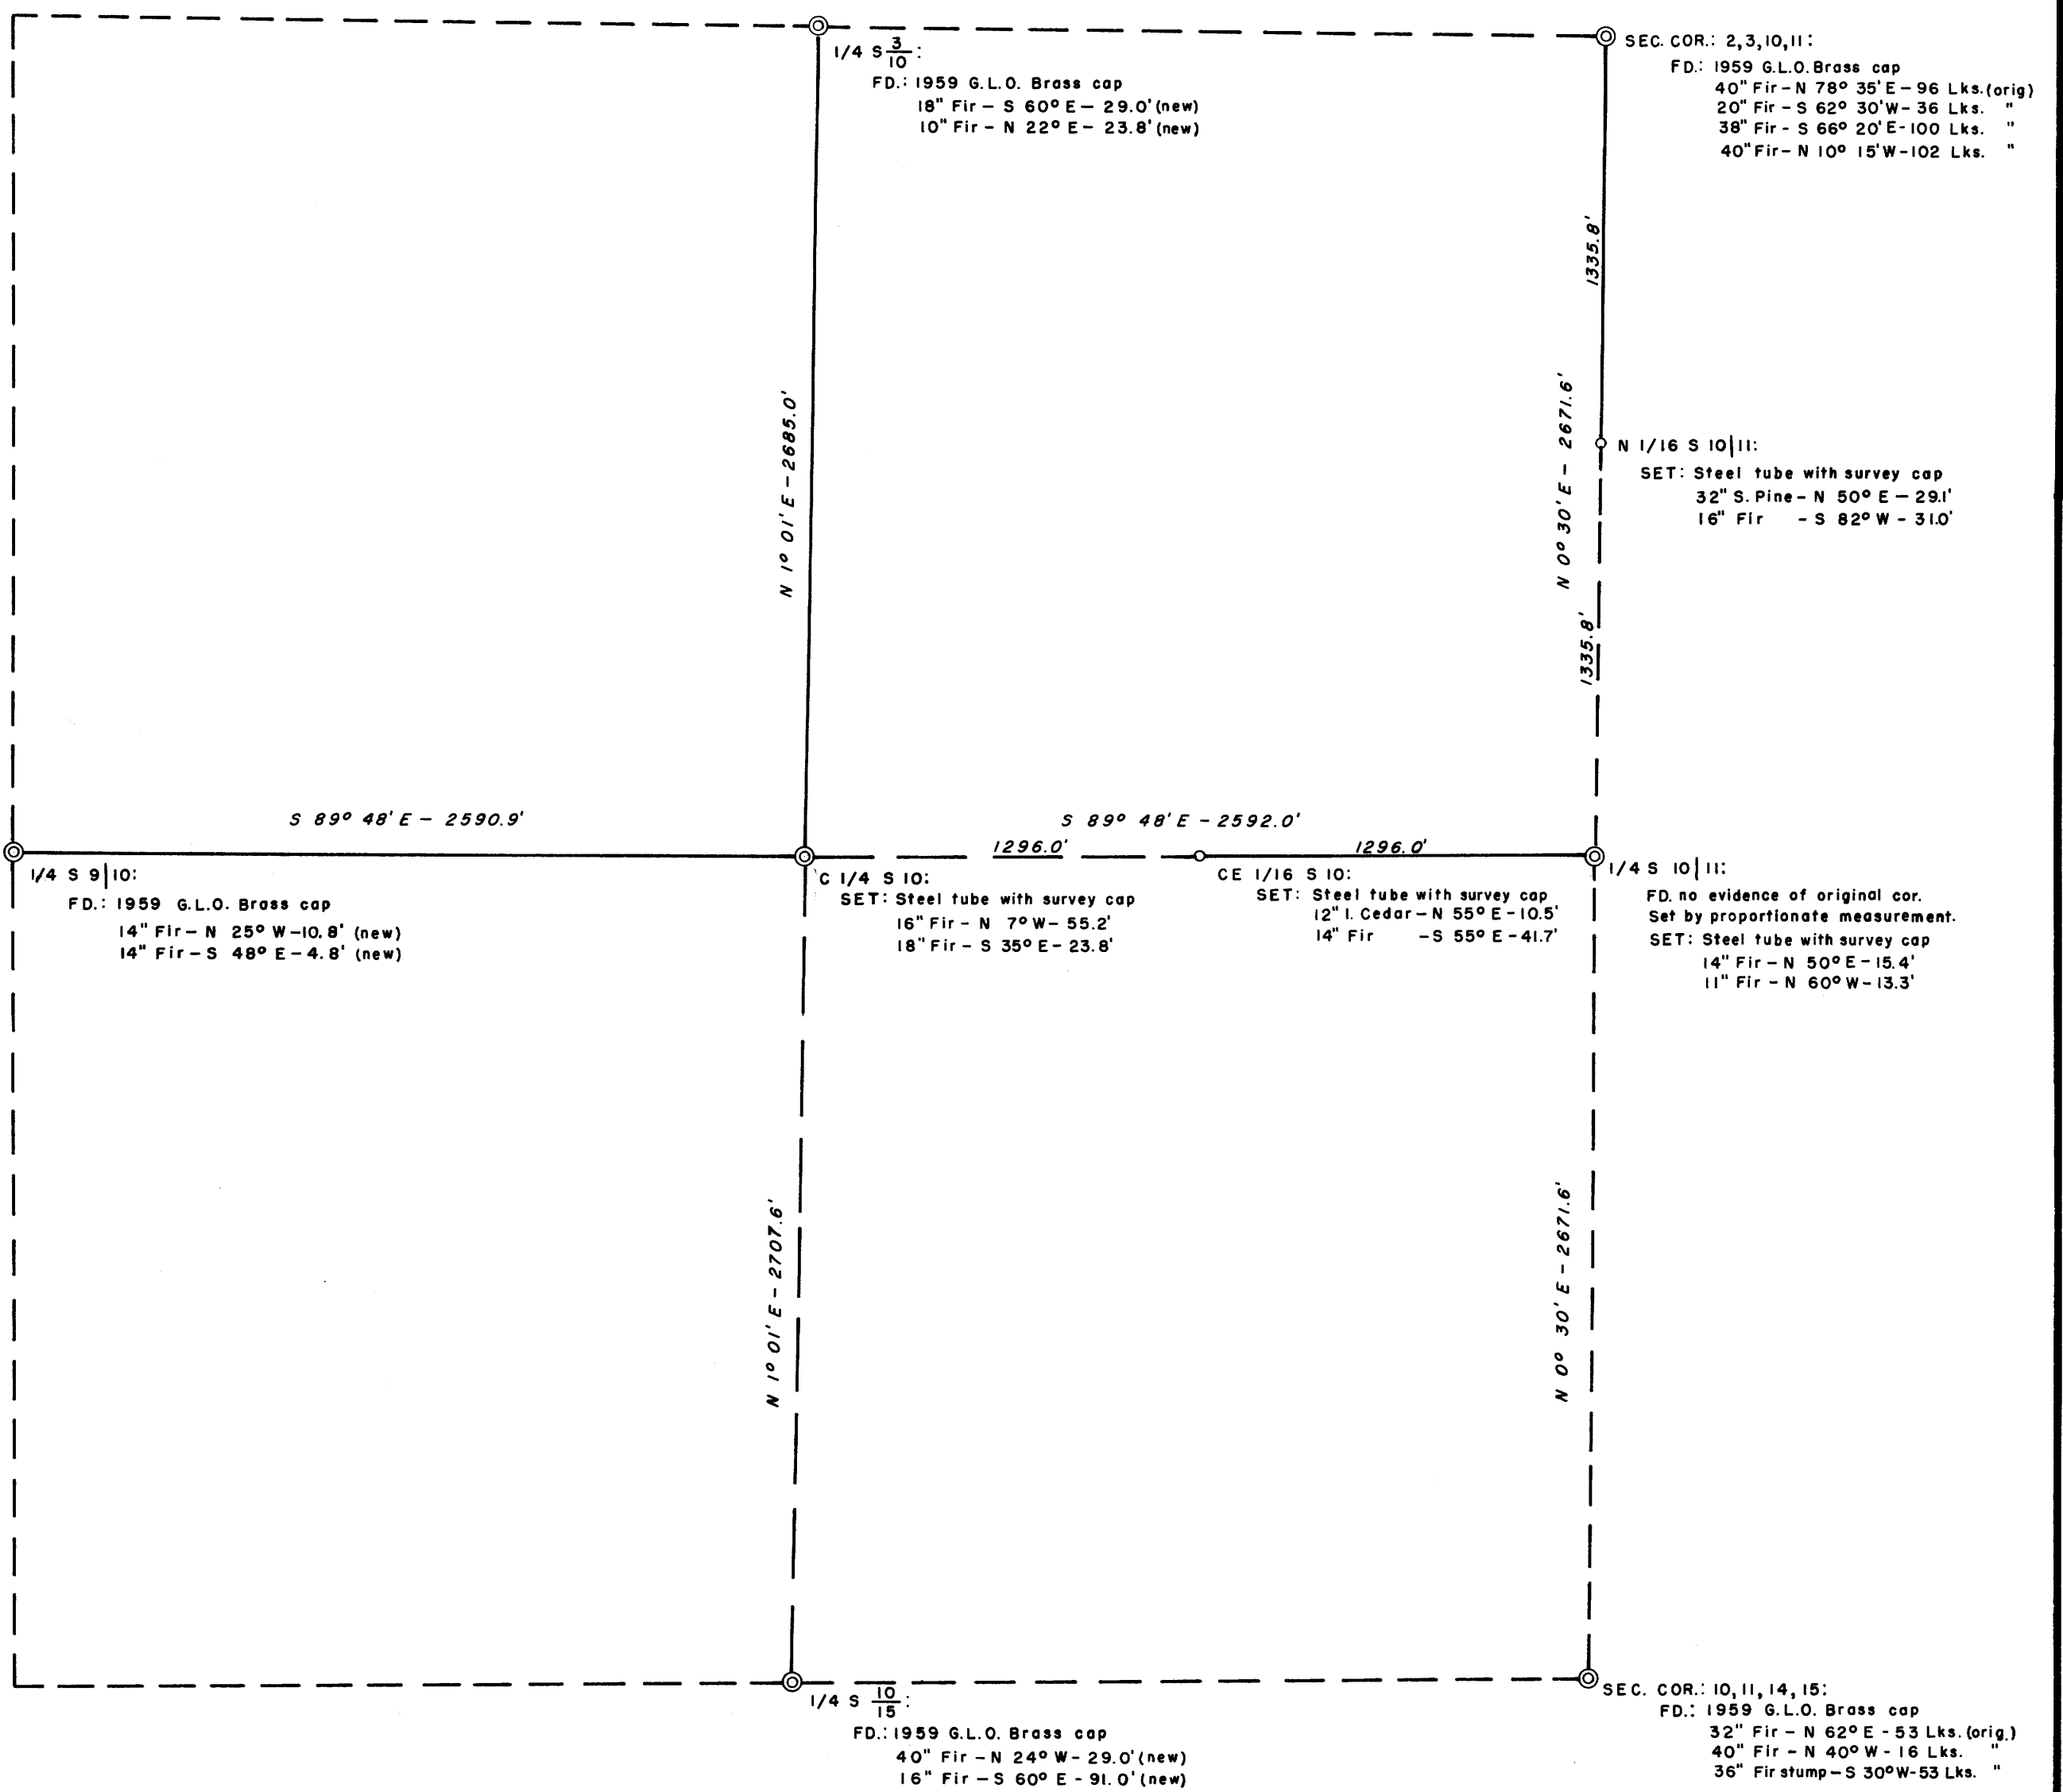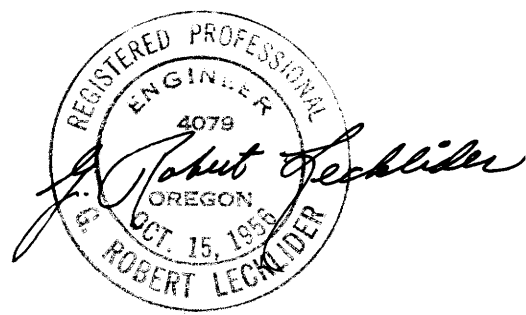

FILED
RECEIVED

DEC 3 1959

COUNTY SURVEYOR
DOUGLAS COUNTY, ORE.