


J.K. FALBEY
LOT SURVEY

SURVEYED BY
H.L. EPPSTEIN C.E.
JULY 23 1921

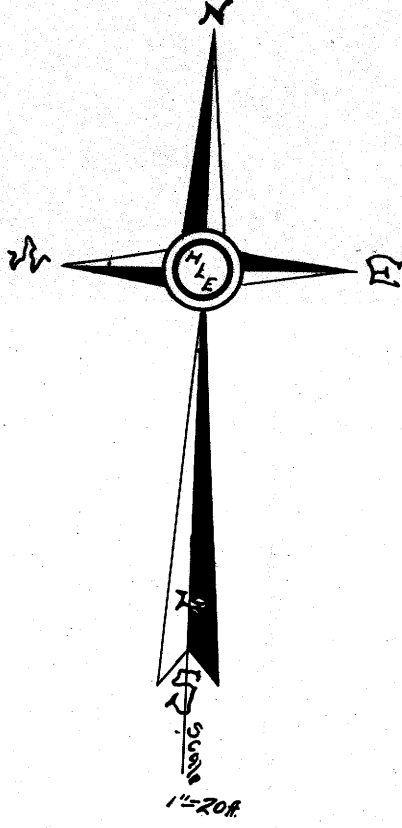

COUNTY SURVEYORS FILE DATA
DO NOT REMOVE FROM OFFICE

M.A. BOLT
104 W 2nd Ave. N