



FD. 3/4" IRON PIPES

||

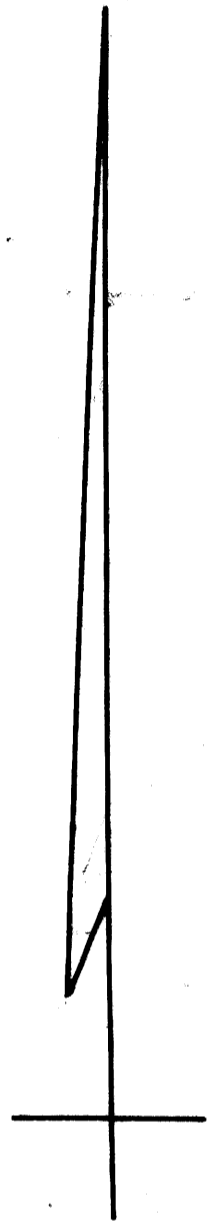

Scale 1" = 20'

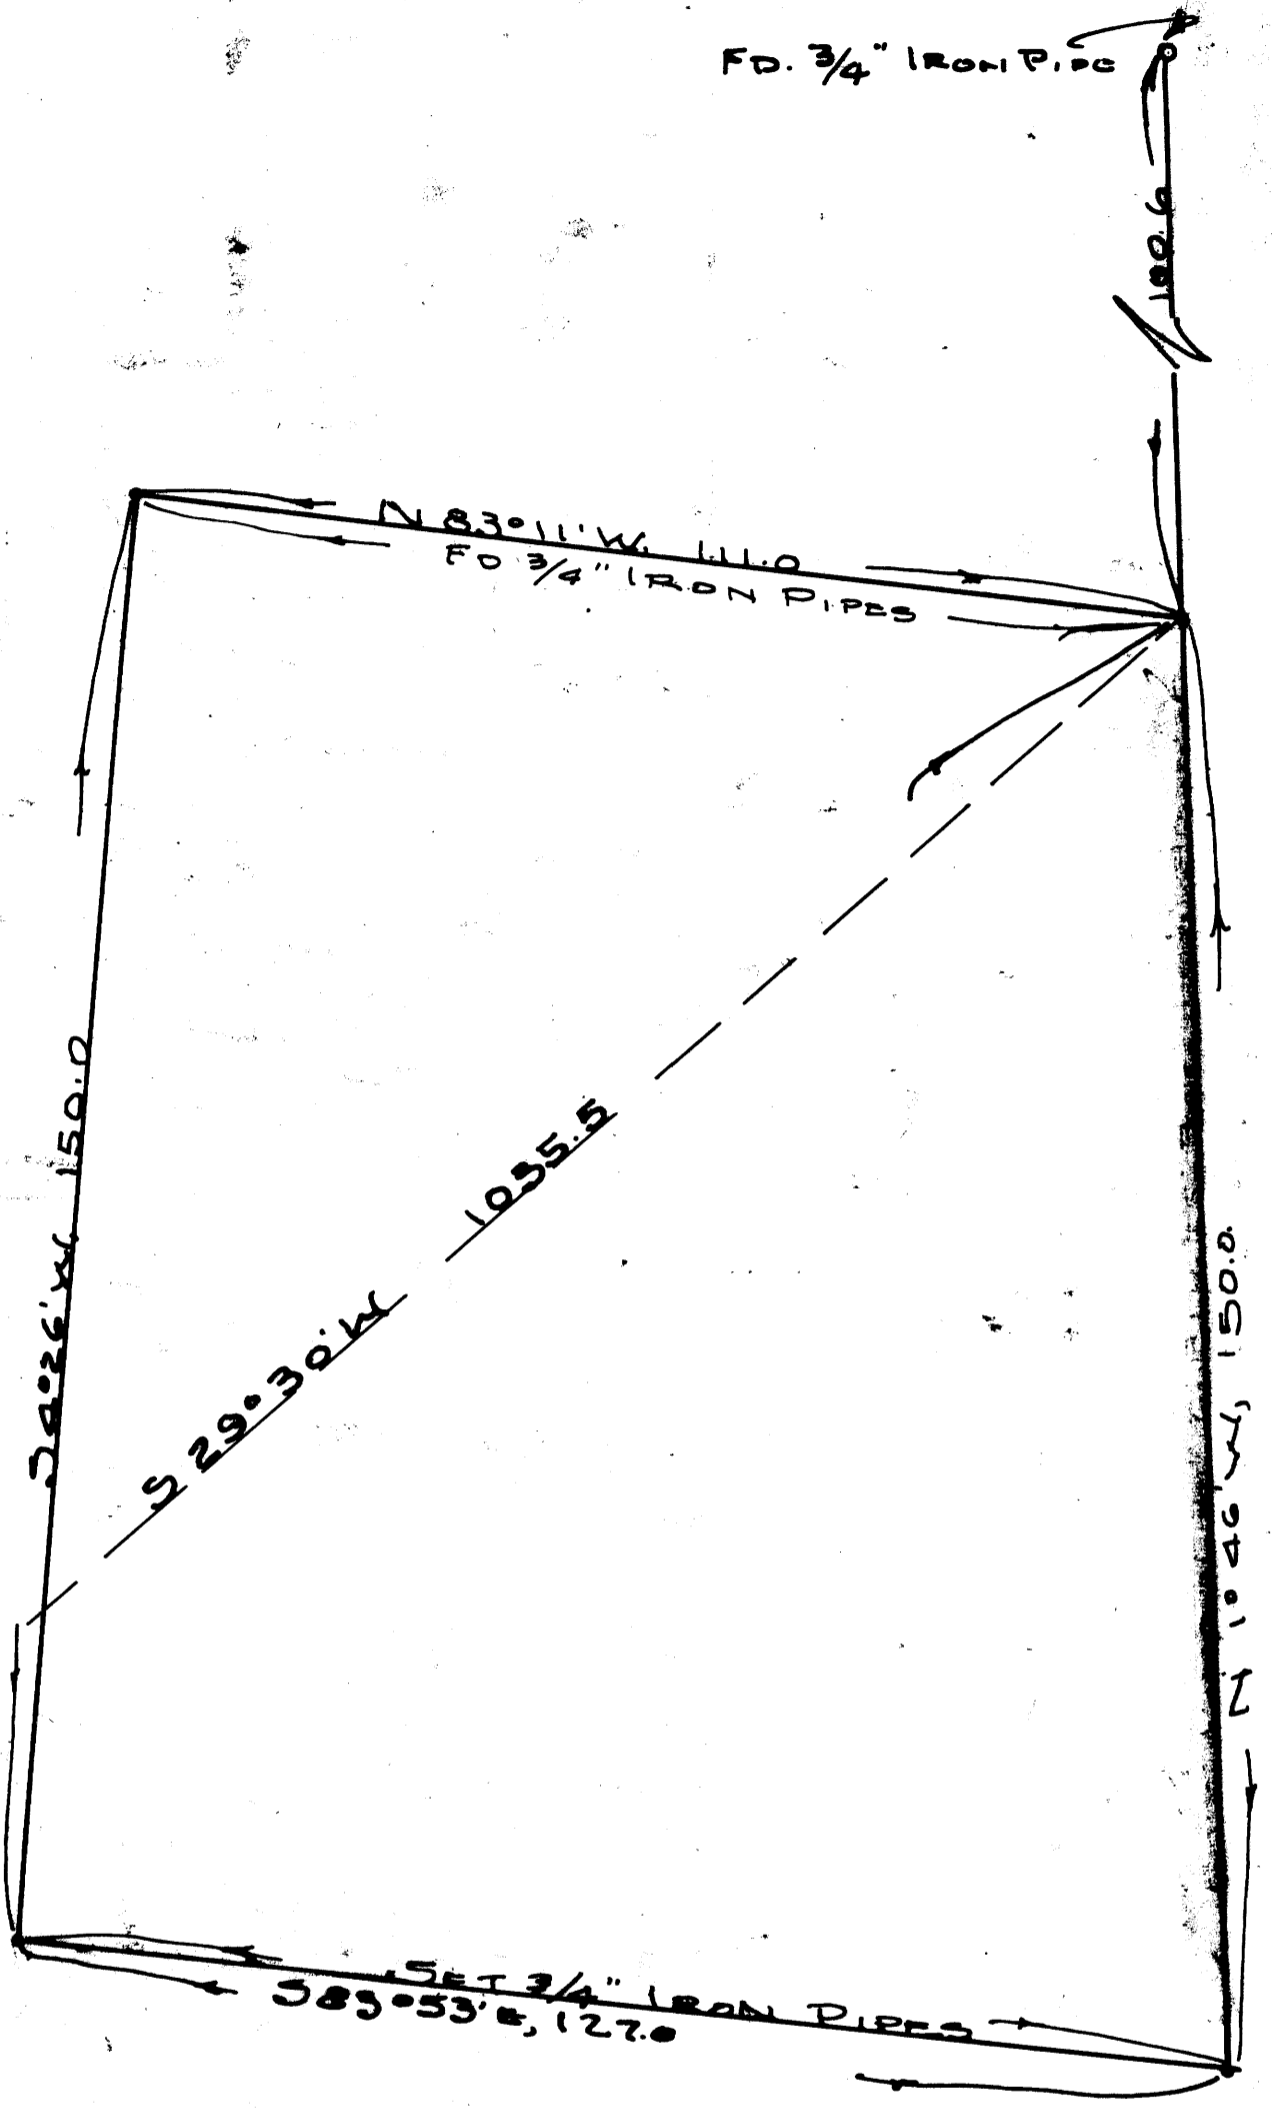

N.W. COR. T. STEVENS D.L.C.
No. 40, T21S, R5W.

COUNTY SURVEYORS FILE DATA
DO NOT REMOVE FROM OFFICE



GRANT & EVANS, ENGINEERS,
ROSEBURG, OREGON.
SURVEY FOR DEED DESCRIPTION
PART OF VAC. LOT 6, BLOCK 15
BUSHEY'S ADD'N. TO ROSEBURG.

SURVEYED & PLOTTED AUGUST 1951, BY
A.R. EVANS, REG. PROF. ENGINEER