



Fence on Property line
supposed to be on true
section line and used as such
for many years. Bearing
assumed as North Var. 22° E.

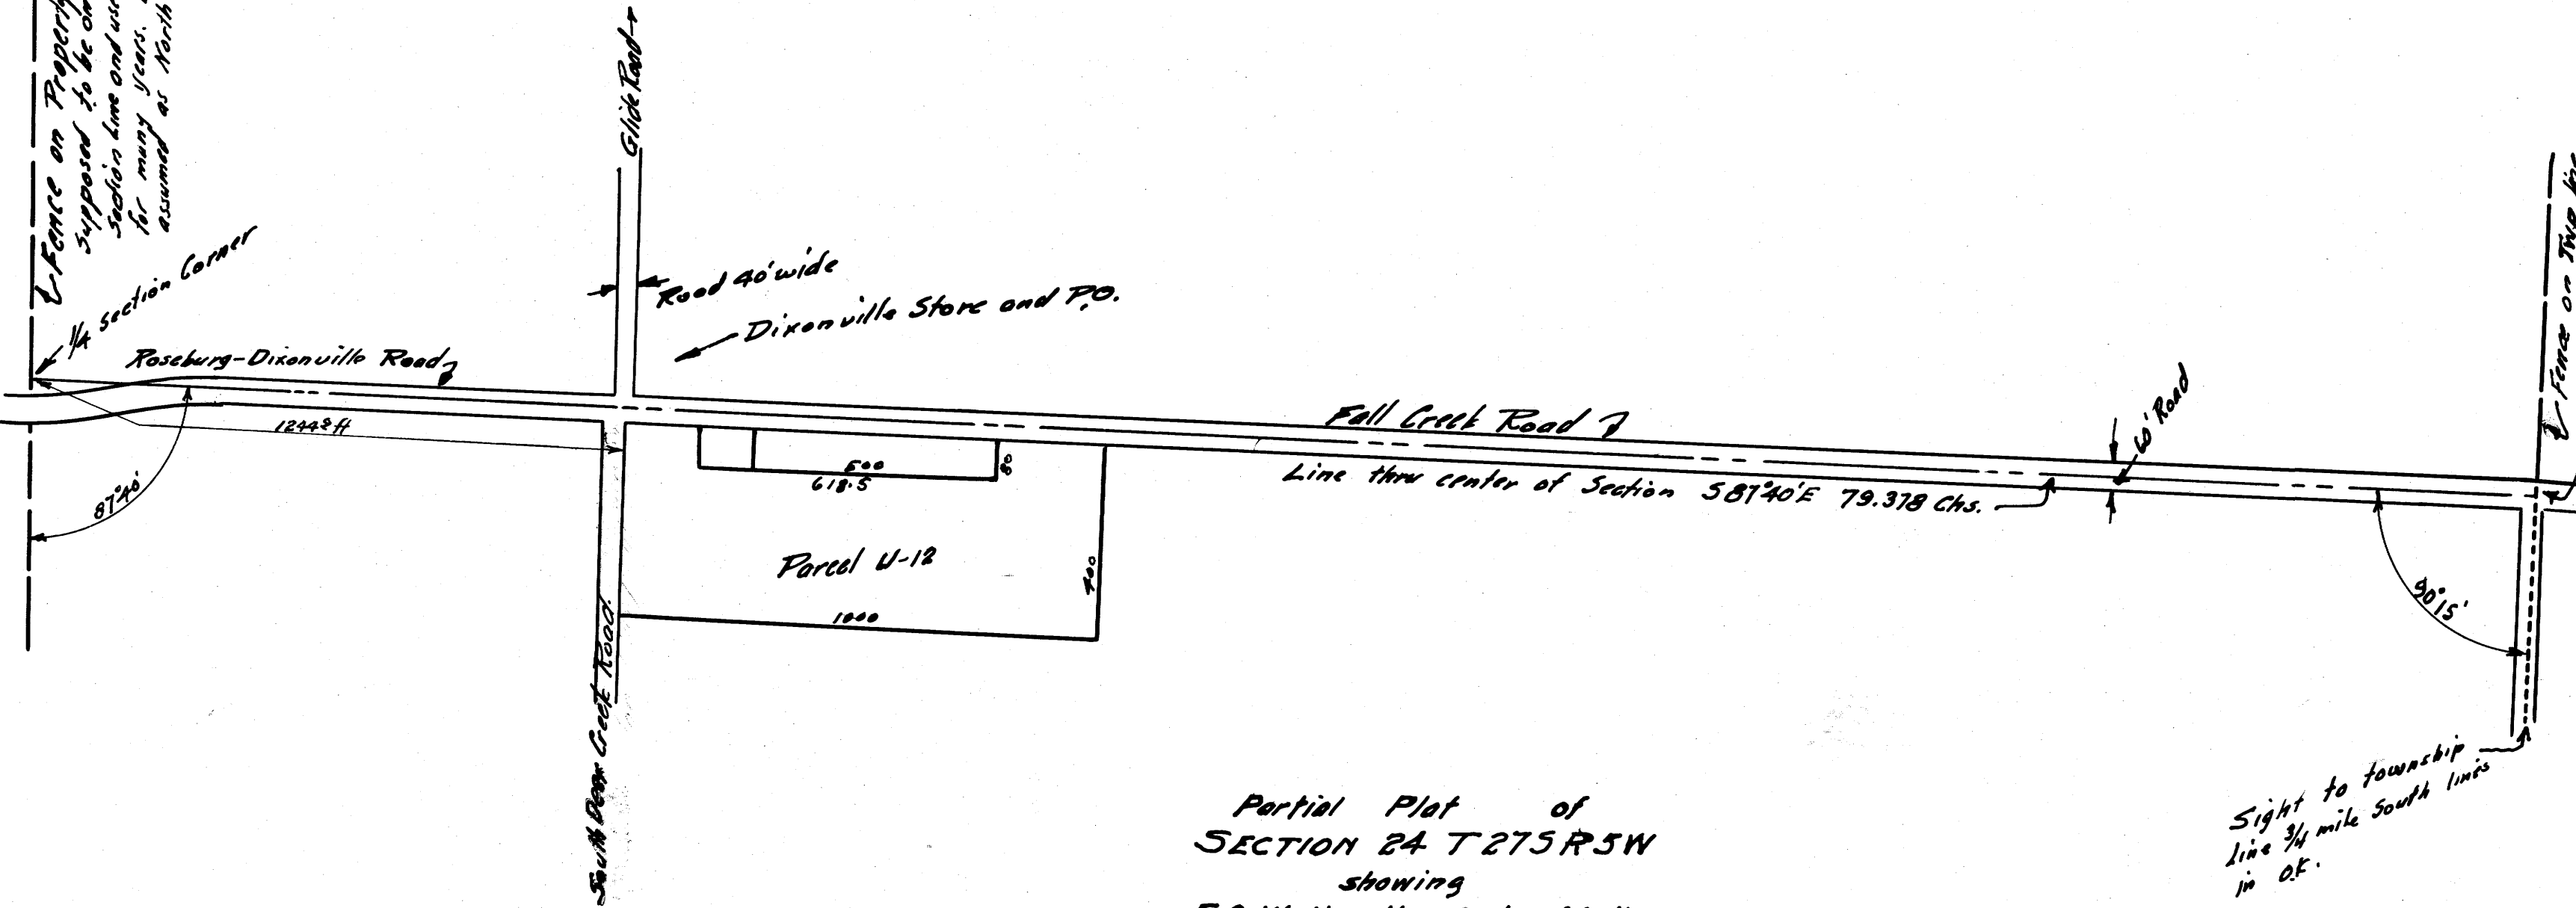

Partial Plot of
SECTION 24 T275R5W
 showing
 E & W Line thru Center of Section
 Surveyed & Platted by
BEN. B. IRVING ROSEBURG, ORE
 Registered Civil Engr. - Deputy County Surveyor
 November 4, 1929
 Scale 1" = 200'

Sight to township
 line 3/4 mile South line
 in O.K.

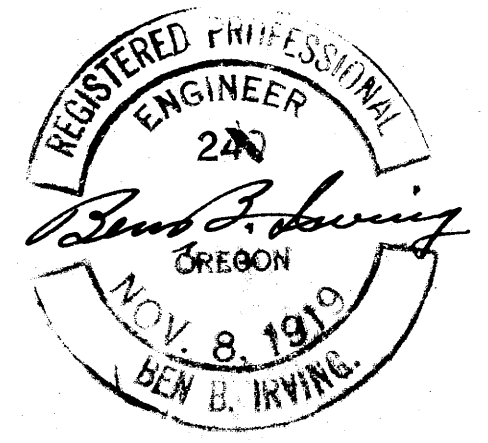

COUNTY SURVEYORS WILL
 DO NOT REMOVE FROM OFFICE