


ORCUTT ST - 50' wd.

Man Hole
Flow Line El. 564.63

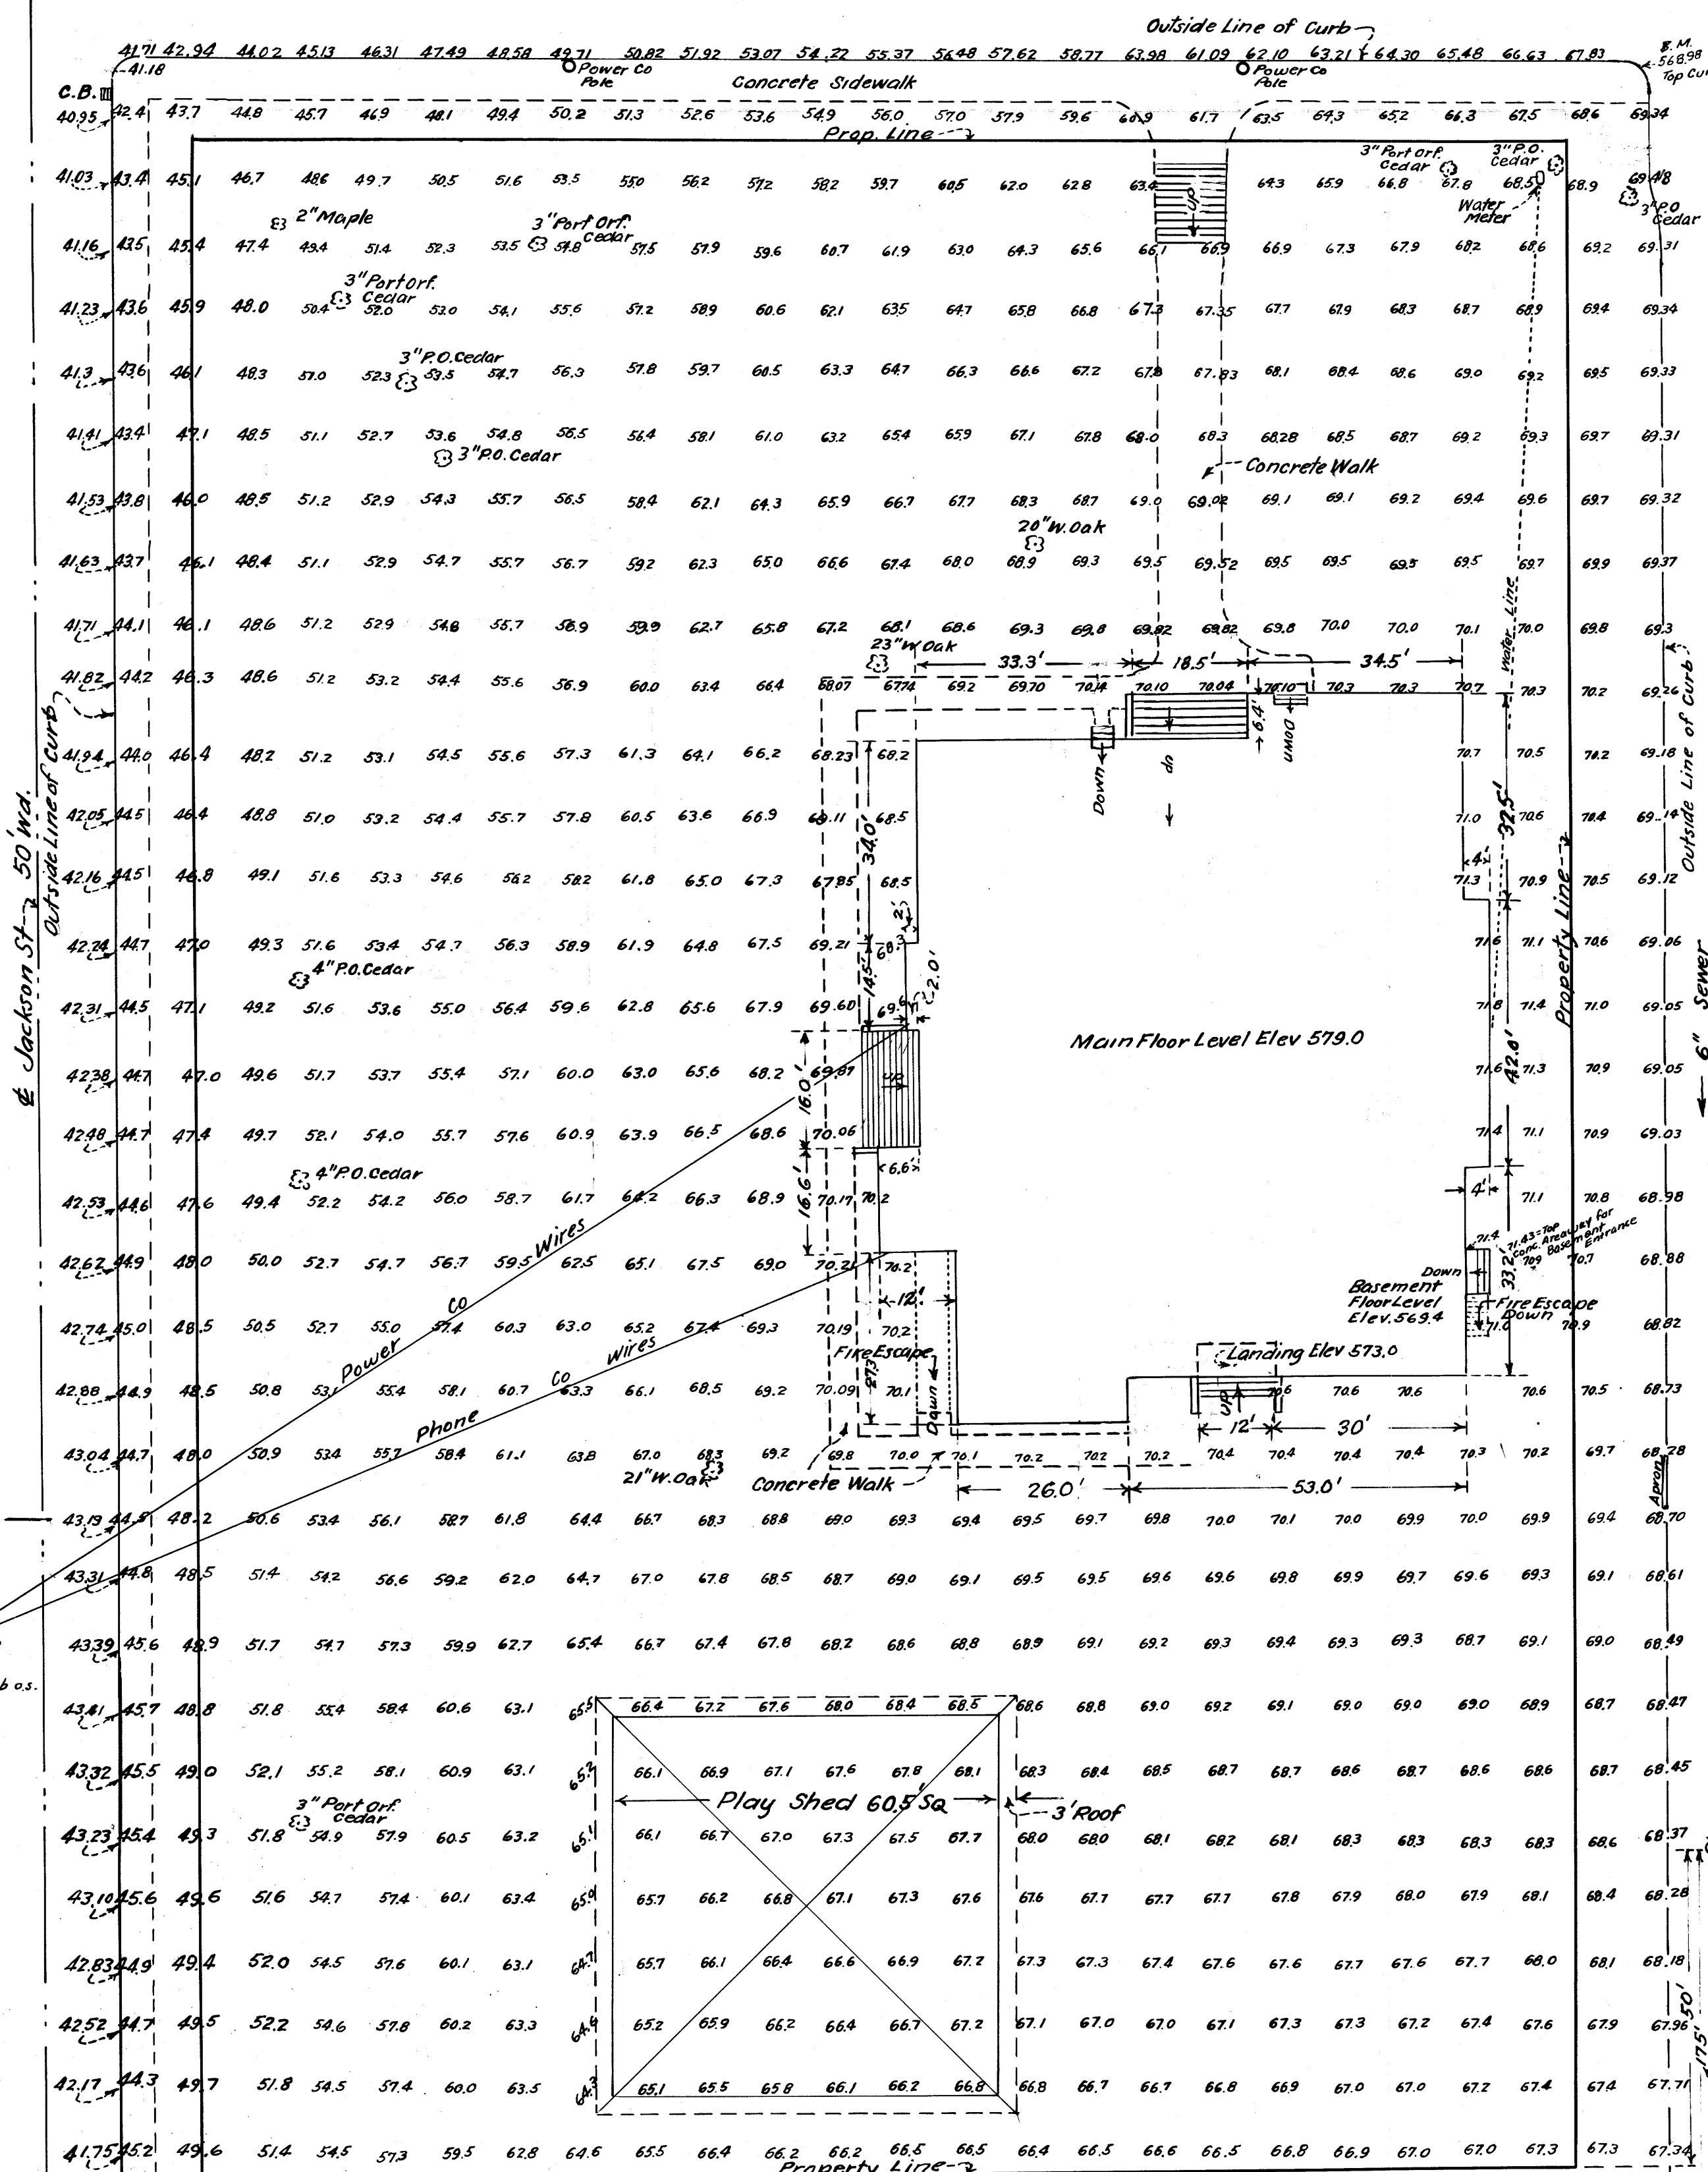

OFFICE OF H.L. EPPSTEIN - ROSEBURG, OREGON

ROSE SCHOOL SITE

LOTS 18 TO 25 AND 38 TO 45, BLOCK 9, 216'x320'

WAITE ADDITION TO
ROSEBURG, OREGON

DRAWN BY: A.B.
CHECKED BY: W.R.S.

MARCH 8, 1937
SCALE 1"=20'