
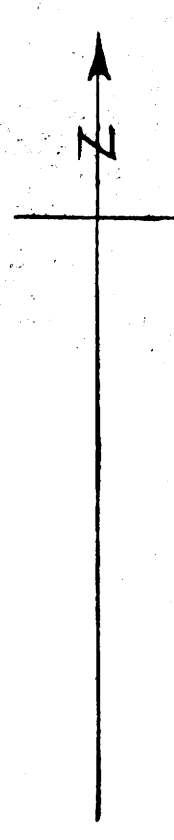


11-81 W

THIS COPY MADE FROM
A XEROX 2510
DATE July 12, 1989

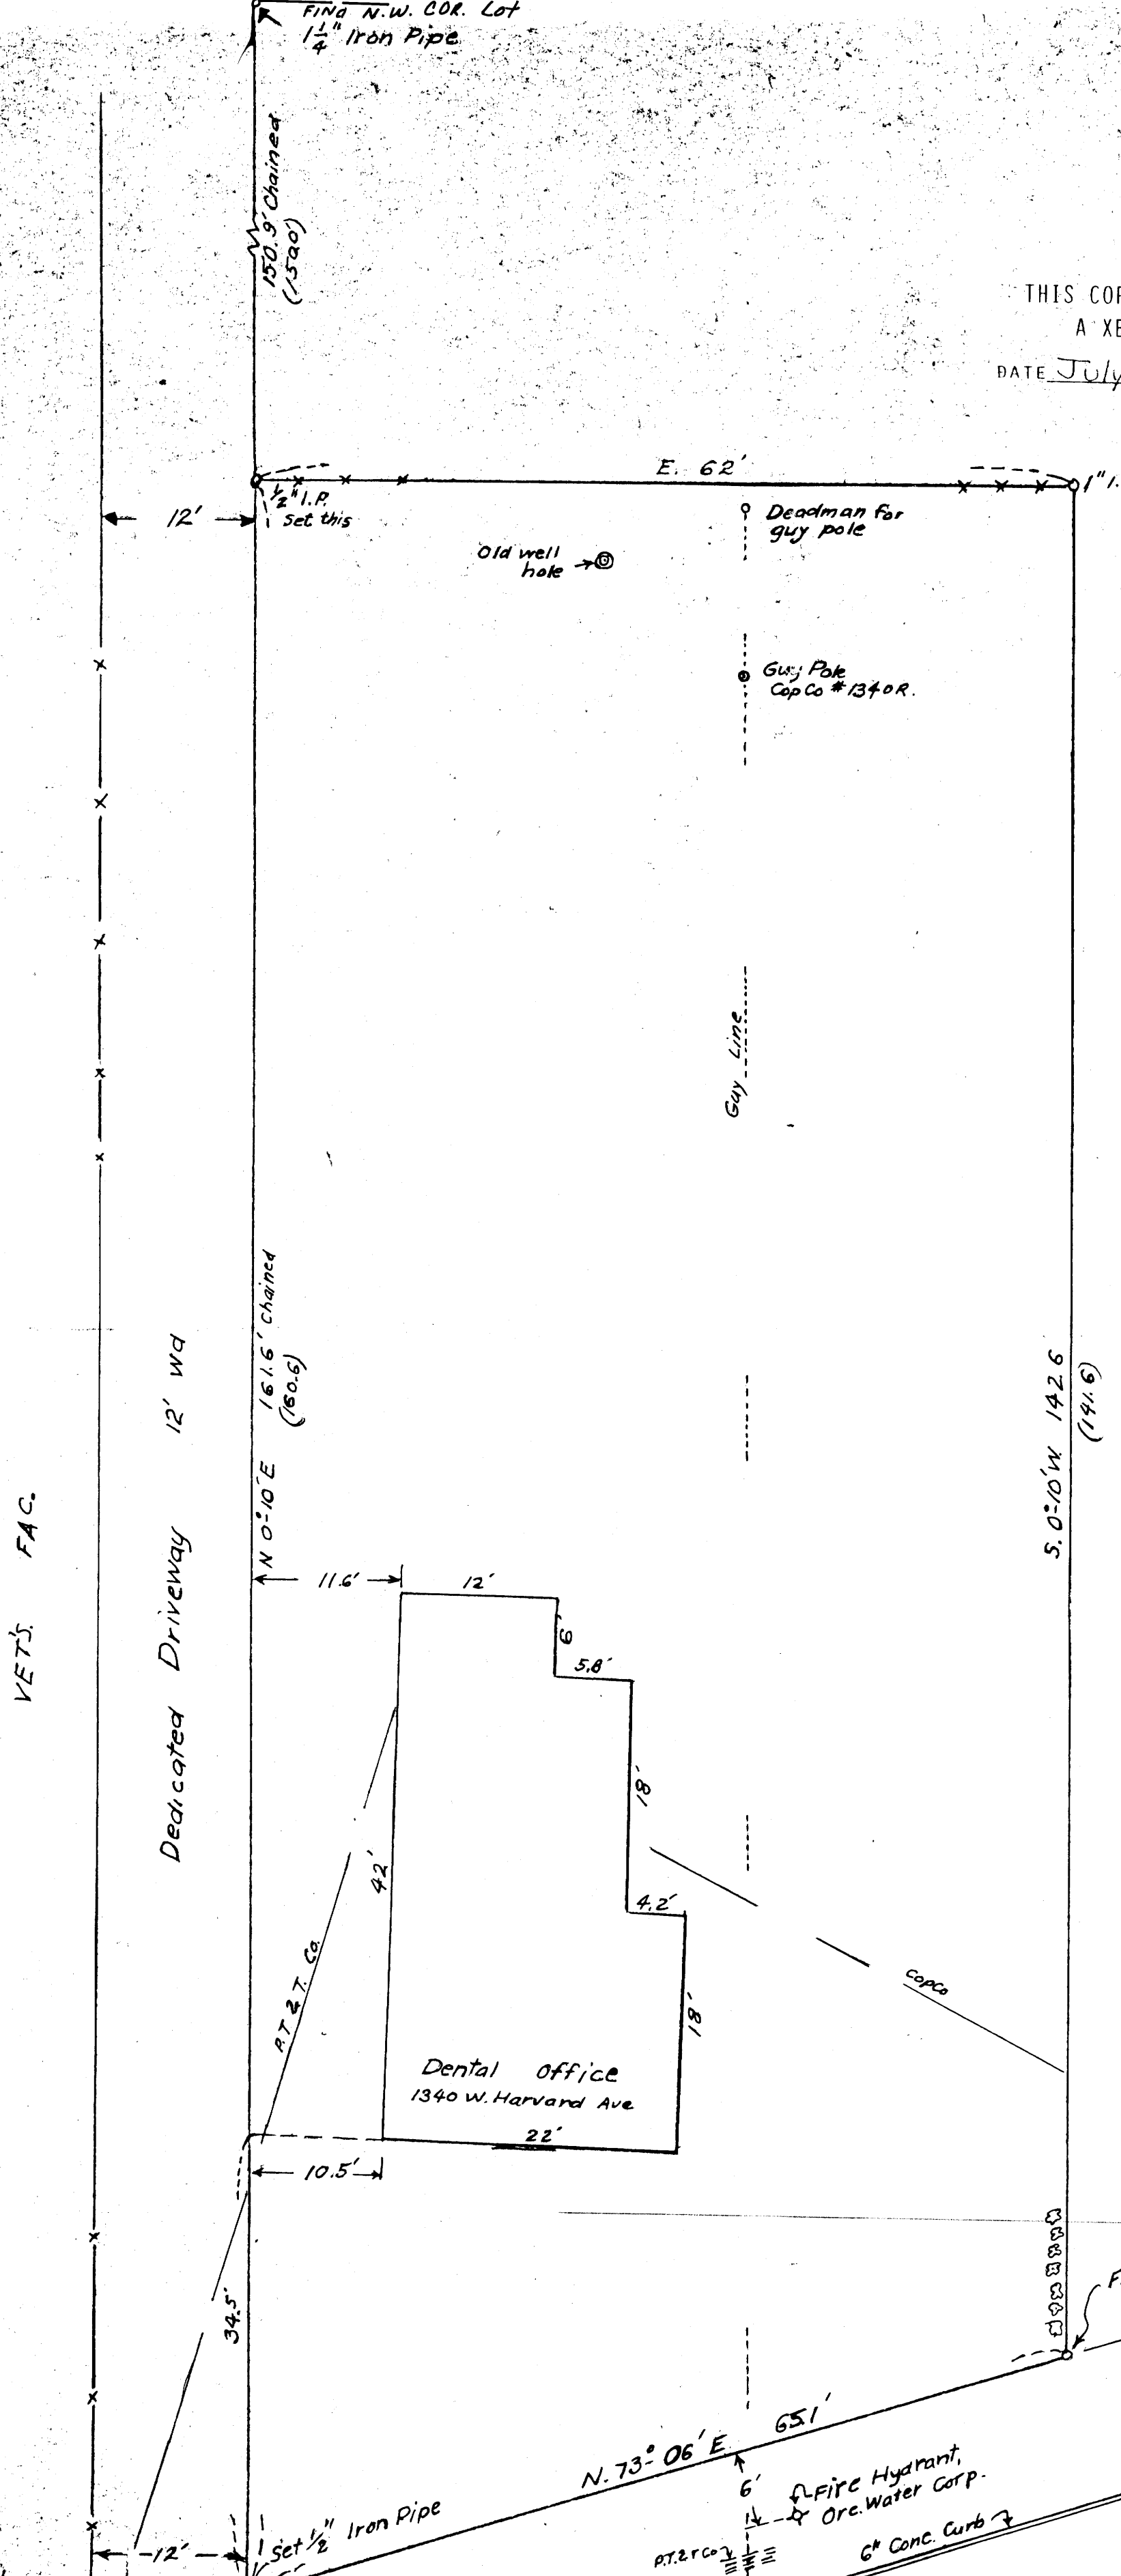

FILED
RECEIVED
APR 8 1960
COUNTY SURVEYOR
DOUGLAS COUNTY, ORE

THOS. HARTFIEL PROPERTY,
PORTION OF LOT 1, BAUER ADD,
ROSEBURG, ORE, IN SEC. 13, T27S, R6W, 34M.
JUNE, 1958 *Arthur Boyer* 1"=10' FE

COUNTY SURVEYORS FILE DATA
DO NOT REMOVE FROM OFFICE